


# BOBHOPECENTER -RESIDENTIAL at 3201 W OLIVE AVE. BURBANK, CA 91505

# PLANNING DEVELOPMENT STANDARDS RESUBMITTAL - 06.22.23

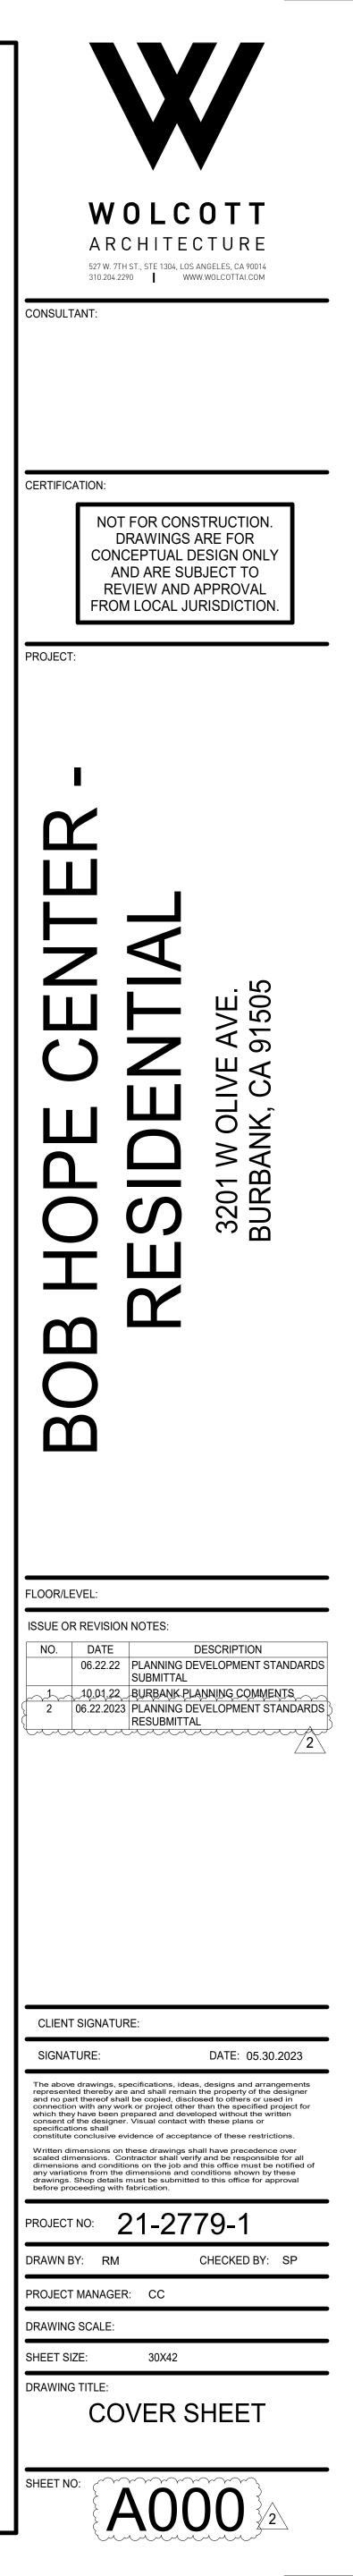

| POUND OR NUMBER<br>MARIE<br>MARIE<br>DIMETER<br>DIMETER         JAN.         JANITOR<br>JOINT<br>JOINT           DIMETER<br>DIMETER<br>DIMETER         LAM.         LAMINATE           DIMETER<br>AT         LAM.         LAMINATE           COUS.         ACOUSTICAL<br>MERCIANGE         MAC.         MINERAL CORE           COUS.         ACOUSTICAL<br>MERCIANGE         MAC.         MATERIAL<br>MATERIAL           DI.         ABOVE FINSH FLOOR         MET.         MATERIAL<br>MATERIAL           DI.         ABOVE FINSH FLOOR         MET.         MATERIAL<br>MATERIAL           DI.         ABOVE FINSH FLOOR         MET.         METAL           MIL UNINUM<br>MERCH         MERCH         MATERIAL         MISC.           ARCHITECTURAL         MISC.         MISC.         MISC.           NON         APPROXIMATE         MID.         MOUNTED           NOR         AVERAGE NATURAL GRADE         MID.         MOUNTED           NOR         NOR AVERAGE NATURAL GRADE         NO.         NUMMER           NOR         NOR AVERAGE NATURAL GRADE         NO.         NUMMER           NOR         NORTON OF         NO.         NUMMER           NOR         NORTON OF         NO.         NUMMER           NOR         CABINED         OF  | A $-+-1$ $(-)$ | DETAIL NUM<br>SHEET NUM<br>SHEET NUM<br>SHEET NUM<br>SHEET NUM<br>SINGLE ELE<br>ELEVATION<br>SHEET NUM<br>INTERIOR E<br>ELEVATION<br>SHEET NUM<br>BULLETIN (<br>AREA OF RE<br>REVISION N<br>FINISH FLOO<br>ROOM NAM<br>ROOM NUM   |
|--|--|---|
| AT LAV. LAVATORY<br>AND<br>PERPENDICULAR A.<br>AND<br>PERPENDICULAR A.<br>AND<br>PENDICULAR A.<br>AND<br>PENDIC | -+ -1  | <ul> <li>DETAIL NUM<br/>SHEET NUM</li> <li>SECTION NU<br/>SHEET NUM</li> <li>SINGLE ELE</li> <li>ELEVATION</li> <li>SHEET NUM</li> <li>INTERIOR E</li> <li>ELEVATION</li> <li>SHEET NUM</li> <li>BULLETIN (0<br/>AREA OF RI</li> <li>REVISION N</li> <li>FINISH FLOO</li> <li>ROOM NAM</li> <li>ROOM NUM</li> </ul> |
| PERFENCICULR M.C. MINERAL CORE<br>COUST AL MATE MALL MATERIAL<br>D.A ARERCANS WITH DISABILITIES ACT MAX. MAXIMUM<br>D.J. ADUSTALE MECAN WITH DISABILITIES ACT MAX. MAXIMUM<br>D.J. ADUSTALE MECAN METAL<br>D.J. ADUSTALE MECAN METAL<br>D.J. ADUSTALE MECAN METAL<br>D.J. ADUSTALE MECAN METAL<br>D.J. ADUSTALE MECAN METAL<br>MECAN MECAN MECAN MECAN<br>ADUSTALE METAL<br>REAL ARENTECT METAL<br>RCH ARCHTECTURAL MIN. MININUM<br>RCH, ARCHTECTURAL MIN. MULL MULLON<br>D.B. BOARD N. NEW TO MATCH EXISTING<br>D.B. BOARD N. NA NOT APPLICABLE<br>MULLON<br>D.B. BOARD N. NEW TO MATCH EXISTING<br>D.B. BOARD N. NA NOT APPLICABLE<br>MILLON<br>D.B. BOARD N. NA NOT APPLICABLE<br>MILLON<br>D.B. BOARD OF NO. NUMBER<br>MID. MOUNTED<br>D.B. BOARD OF NO. NUMBER<br>D.B. BOARD OF NO. NUMBER<br>MID. MOUNTED<br>D.B. BOARD OF NO. NUMBER<br>D.B. GATTOM OF NO. NUMBER<br>MID. MOUNTED<br>D.B. BOARD OF NO. NONNAL<br>MID. MOUNTED<br>D.B. BOARD OF NO. NONNAL<br>MID. MOUNTED<br>D.C. COUNTER<br>MID. CONTRECTON<br>MID. CONTRECTON<br>MID. CONTRECTON<br>MID. CONTRECTON<br>MID. CONTRECTON<br>MID. CONTRECTON<br>MID. CONTRUCTON<br>MID. MOUNTER<br>MID. DOWNER<br>MID.  | F.F.E.<br>ROOM NAME<br>#<br>#<br>STAIR/RAMP UP<br>##% SLOPE<br>ALIGN   | <ul> <li>DETAIL NUM<br/>SHEET NUM</li> <li>SECTION NU<br/>SHEET NUM</li> <li>SINGLE ELE</li> <li>ELEVATION</li> <li>SHEET NUM</li> <li>INTERIOR E</li> <li>ELEVATION</li> <li>SHEET NUM</li> <li>BULLETIN (0<br/>AREA OF RI</li> <li>REVISION N</li> <li>FINISH FLOO</li> <li>ROOM NAM</li> <li>ROOM NUM</li> </ul> |
| Dut         ADJUSTRALE         MEHC.         MECANICAL           F.F.         ABOVE FINISH FLOOR         MET.         META.         MANUPACTURER           PROX         APPROXIMATE         MIN.         MINNUM         MINNUM           RCH         ARCHITECTURAL         MISC.         MISCLANDATE           RCH         ARCHITECTURAL         MISC.         MISCLANDATE           NG         AVERAGE NATURAL GRADE         MUL         MULLION           D.         BOARD         N         NEW TO MATCH EXISTING           LKG.         BULDING         NA         NOT APPLICABLE           LKG.         BUCKING         NIA         NOT APPLICABLE           LKG.         BUCKING         NIA         NOT APPLICABLE           LKG.         BUCKING         NIA         NOT APPLICABLE           LKG.         GABINET         NIS         NOT APPLICABLE           LKG.         CALING         OFF         OC         ON EANITABULE           LCG.         CLARFORM BULDING CODE         O.         OU OTSIDE DIAMETER           LCG.         CLARAR         OFF         OFFICE         PLATE           LCG.         CLARAR         OFFICE         ON EFFICE         PLATE      <   | F.F.E.<br>ROOM NAME<br>#<br>#<br>STAIR/RAMP UP<br>##% SLOPE<br>ALIGN   | SHEET NUM SECTION NUM SECTION NUM SECTION NUM SINGLE ELE ELEVATION SHEET NUM INTERIOR E ELEVATION SHEET NUM BULLETIN (0 AREA OF RE REVISION N FINISH FLOO ROOM NUM  |
| DEPROX.         APPROXIMATE         MIN.         MIN.         MIN.MUMUM           RCHT.         ARCHITECT IVRAL         MISC.         MISC.<   | F.F.E.<br>ROOM NAME<br>#<br>#<br>STAIR/RAMP UP<br>##% SLOPE<br>ALIGN   | SECTION NI<br>SHEET NUM         SINGLE ELE<br>ELEVATION<br>SHEET NUM         INTERIOR E<br>ELEVATION<br>SHEET NUM         SHEET NUM         BULLETIN (<br>AREA OF RI<br>REVISION N<br>FINISH FLOOR         FINISH FLOOR<br>ROOM NUM   |
| DD BOARD N. NEW TO MATCH EXISTING<br>LDG BUILDING N. NA NOT APPLICABLE<br>BUICDING N. N.I.C. NOT IN CONTRACT<br>NOT APPLICABLE<br>BUCKING N.I.C. NOT IN CONTRACT<br>NOT APPLICABLE<br>BUCKING N.I.C. NOT IN CONTRACT<br>NOT BOTTOM N.I.C. NOT IN CONTRACT<br>NOT BOTTOM N.I.C. NOT NI CONTRACT<br>NOM NOMINAL<br>AB. CABINET<br>B.C. CALIFORNIA BUILDING CODE O.A. OVER ALL<br>ER. CERAMIC O.C. ON CENTER<br>LOPG, CLEAR OPENING O.D. OUTSIDE DIAMETER<br>LORG, CELLING OFF. OFFICE<br>LORG, CLEAR OPENING OPP. OPPOSITE<br>IKG. CALIKING OPP. OPPOSITE<br>IKG. CALIKING OPP. OPPOSITE<br>IKG. CONSTRUCTION PLAS. PLASTIC LAMINATE<br>OL. COLUMN PLAM. PLASTIC LAMINATE<br>ONST. CONSTRUCTION PLAS. PLASTIC CAMINATE<br>ONST. CONTRUCTOR P.O. PRIVATE OFFICE<br>ONTR. CONTRUCTOR P. P.O. PRIVATE OFFICE<br>ONTR. CONTRUCTOR P.O. PRIVATE OFFICE<br>ONTR. CONTRUCTOR P. P. PAINT<br>DEMOLISH P.TD. PAINTED<br>DEMOLISH P.TD. PAINTED<br>DEMOLISH REFER<br>M. DOUBLE P.TD. PAINTED<br>DEMOLISH REFER<br>M. DOUBLE P. P.T. PAINT<br>DEMOLISH REFER<br>M. DOUBLE P. REFERENCE<br>R. DOOR PENING REFER REFERENCE<br>R. DOOR NER REFER STA STATION<br>REFERENCE REFERENCE<br>R. FIRE ESTINGUSHER CABINET STOR. STANAGE<br>N.N. FINISH SUBLE READINET STAN STATION<br>REFERENCE REFERENCE<br>R. FIRE RESTINGUSHER CABINET STOR. STANAGE<br>N.N. FINI  | F.F.E.<br>ROOM NAME<br>#<br>#<br>STAIR/RAMP UP<br>##% SLOPE<br>ALIGN   | SHEET NUM<br>SINGLE ELE<br>ELEVATION<br>SHEET NUM<br>INTERIOR E<br>ELEVATION<br>SHEET NUM<br>BULLETIN (<br>AREA OF RI<br>REVISION N<br>FINISH FLO<br>ROOM NAM<br>ROOM NUM   |
| BLOCKING BLOCKING NIC NOT NOT CONTRACT<br>0. BOTTOM OF NO. NUMBER<br>NOM. NOMINAL<br>BOTTOM FOR NO. NUMBER<br>NT.S. NOT TO SCALE<br>B.C. CALIFORNIA BUILDING CODE O.A. OVER ALL<br>B.C. CALIFORNIA BUILDING CODE O.C. ON CENTER<br>B.C. CALIFORNIA BUILDING CODE O.C. ON CENTER<br>L.C. CERAMIC O.C. O.C. ON CENTER<br>L.C. C.C. CHAR OPENING O.C. P.C. OPPOSITE<br>I.C. C.C. CULAR OPENING O.P. OPPOSITE<br>I.C. C.C. COLUMN PLAS. PLASTIC LAMINATE<br>O.C. COLUMN PLAS. PLASTIC LAMINATE<br>O.N. CONSTRUCTION PLAS. PLASTIC CONSTRUCTION<br>D.T. CONTRUCTON PLAS. PLASTIC CONSTRUCTION<br>ONT. CONTRUCTON PLAS. PLASTIC CONSTRUCTION<br>ONT. CONTRUCTOR P.C. PR. PAIR<br>CONTROLOR P.R. PAIR<br>DEMOLISH PT.D. PAINT TO MATCH<br>TR. CENTER PT. PAINT<br>DEMOLISH PT.D. PAINT TO MATCH<br>ET. DETALL<br>D.C. COLUMN R. P.C. PRIN. PAINT ON MATCH<br>ET. DETALL<br>D.C. COLUMN R. P.C. PRIN. PAINT<br>DEMOLISH PT.D. PAINT TO MATCH<br>ET. DETALL<br>D. OUBLE PT. DEATMENT<br>ET. DETALL<br>A. DIMETER<br>A. DIMENSION R. R. RELOCATE OSTING OR<br>B. D. DOOR OPENING REF. REFERENCE<br>I.S. DISPENSER<br>D. DISPENSER<br>A. DOOR REF. REFERENCE<br>R. DOOR REF. REFERENCE<br>RESIL. RESILENT<br>R. DOOR SCHED SCHEDULE<br>L. ELEVATION<br>A. EACH R. R.O. ROUGH OPENING<br>A. EACH R. R.O. ROUGH OPENING<br>A. EACH R. R.O. SCHEDO SCHED<br>C. E. EXISTING TO REMAIN RM. SUMPACE MOUNTED<br>R. DOOR SCHED SCHEDULE<br>L. ELEVATION SCHED SCHEDULE<br>L. ELEVATION SCHED SCHEDULE<br>L. ELEVATION SCHED SCHEDULE<br>E. HINSH FLOOR ELEVATION SCHED SCHEDULE<br>L. F. LOOR SCHED STALL STON STANDARD<br>H. HINSH SUSP. SUS   | F.F.E.<br>ROOM NAME<br>#<br>#<br>STAIR/RAMP UP<br>##% SLOPE<br>ALIGN   | ELEVATION<br>SHEET NUM<br>INTERIOR E<br>ELEVATION<br>SHEET NUM<br>BULLETIN (<br>AREA OF RI<br>REVISION N<br>FINISH FLO<br>ROOM NAM<br>ROOM NUM  |
| AB.     CABINET     O.A.     OVER ALL       B.C.     CALIPORNIA BUILDING CODE     O.A.     OVER ALL       B.C.     CCERAMIC     O.C.     ON CENTER       L.PGC.     CLEAR OPENING     O.D.     OUTSIDE DIAMETER       LNG.     CELING     O.P.     OPFICE       LNG.     CELING     OPPOSITE       LKG.     CLEAR     OPPOSITE       LR.     CLEAR     PL     PLATE       NTR.     CENTER     PL     PLATE       OL.     COLUMN     PLAS.     PLASTIC LAMINATE       ONT.     CONTRACTOR     PL     PLASTIC LAMINATE       ONT.     CONTRACTOR     P.O.     PRIVATE OFFICE       ORR.     CORTROCOR     PR.     PAIR       ORR.     CORTRACTOR     P.O.     PRIVATE OFFICE       ORR.     CONTRACTOR     P.T.     PAINT TO MATCH       DEMOLISH     PTD.     PAINT TO       BL.     DOUBLE     PTD.     PAINTED       BL.     DOUBLE     PTD.     PAINTEN       ETT.     DEFARTINENT     ETT.     ELECATENTION       R.     DOOR OPENING     REF.     REFLECATENTION       N.     DOWN     RAD.     RADUS       N.     DOWN     RAD. <td< td=""><td>F.F.E.<br/>ROOM NAME<br/>#<br/>#<br/>STAIR/RAMP UP<br/>##% SLOPE<br/>ALIGN</td><td>SHEET NUM INTERIOR E ELEVATION SHEET NUM BULLETIN ( AREA OF RI AREA OF RI FINISH FLO ROOM NAM ROOM NUM</td></td<>   | F.F.E.<br>ROOM NAME<br>#<br>#<br>STAIR/RAMP UP<br>##% SLOPE<br>ALIGN   | SHEET NUM INTERIOR E ELEVATION SHEET NUM BULLETIN ( AREA OF RI AREA OF RI FINISH FLO ROOM NAM ROOM NUM  |
| TOPG.<br>CILEAR OPENINGO.D.OUTSIDE DAMETER<br>INGING.CELUNGOPF.OPFICE<br>INGLKG.CAULKINGOPP.OPPOSITELO.CLOSETOPP.OPPOSITELR.CLEARUPLATENTR.CENTERPL.PLATEOL.COLUMNPLAN.PLASTIC LAMINATEONST.CONSTRUCTIONPLAS.PLASTIC CONSTRUCTIONONT.CONTRACTORP.O.PRIVATE OFFICEORR.CONTRACTORP.O.PRIVATE OFFICEORR.CONTRACTORP.T.PAINTTR.CENTERPT.PAINTDEMOLISHPT.PAINT TO MATCHET.DEPARTMENTPRIN.PARTITIONET.DEPARTMENTQ.T.QUARRY TILEIA.DIMENSIONRREF.RELOCATIONJ.DOORREFL.REFLECRE EXISTING ORN.DOORREFL.REFLECREDWG.DAORREFL.REFLECREDWR.DOORREFL.REFLECREDWR.DARWERREO.REOUIREDWR.DARWERREG.SCLID CORELEV.ELVATIONSCHED.SCHED.A.ELCTICALSC.SOLID CORELEV.ELEVATIONSCHED.SCHED.A.ELCTINGSCHED.SCHED.A.ELCTINGSCHED.SCHED.A.ELCTINGSCHED.SCHED.A.ELCTINGSCHED.SCHED.A.  | F.F.E.<br>ROOM NAME<br>#<br>#<br>STAIR/RAMP UP<br>##% SLOPE<br>ALIGN   | ELEVATION SHEET NUM BULLETIN ( AREA OF R AREA OF R FINISH FLO ROOM NAM ROOM NUM   |
| 0.     CLOSET     OPP.     OPPOSITE       R     CLEAR     PL     PLATE       TITR.     CENTER     PL     PLATE       NTR.     COLUMN     PLAS.     PLASTIC LAMINATE       NIST.     CONTRUCTION     PLAS.     PLASTIC       NITR.     CONTRUCTOR     P.O.     PRIVATE OFFICE       NITR.     CONTRACTOR     P.O.     PRIVATE OFFICE       NRR.     CORRIDOR     PR.     PAINT       R.     CENTER     PT.     PAINT       R.     CENTER     PT.     PAINT       DEMOLISH     PTD.     PAINTED       IL.     DOUBLE     PRTN.     PARTITION       PT.     DEPARTMENT     Q.T.     QUARRY TILE       Q.     DIMENSION     R     RELOCATE EXISTING OR       A.     DIMENSION     R     SALVAGE FOR RELOCATION       J.     DOWN     RAD.     RADUS       A.     DIMENSION     REF.     REFRERENCE       L.     DOWN     REF.     REFRERENCE       VG.     DORAWER     REF.     REFIGERATOR       VR.     DRAWING     REFR.     RESULENT       VR.     DRAWER     RO.     ROUGH OPENING       ELEVATION     SCHED.     SCHEDULE <td>F.F.E.<br/>ROOM NAME<br/>#<br/>#<br/>STAIR/RAMP UP<br/>##% SLOPE<br/>ALIGN</td> <td>SHEET NUM<br/>BULLETIN (<br/>AREA OF R<br/>REVISION N<br/>FINISH FLO<br/>ROOM NAM<br/>ROOM NUM</td>  | F.F.E.<br>ROOM NAME<br>#<br>#<br>STAIR/RAMP UP<br>##% SLOPE<br>ALIGN   | SHEET NUM<br>BULLETIN (<br>AREA OF R<br>REVISION N<br>FINISH FLO<br>ROOM NAM<br>ROOM NUM  |
| DAT. CONSTRUCTION PLAS. PLASTIC<br>NT. CONTINUOUS PLY. PLYWOOD<br>NTR. CONTRACTOR PLY. PLYWOOD<br>NTR. CONTRACTOR PR. PAINT<br>CONTRACTOR PR. PAINT<br>R. CENTER PT. PAINT<br>DEMOLISH PTD. PAINT TO MATCH<br>DEMOLISH PTD. PAINT TO MATCH<br>T. DEPARTMENT<br>T. DEPARTMENT<br>T. DEPARTMENT<br>T. DETAIL Q.T. QUARRY TILE<br>A DIAMETER<br>M. DIMENSION R RELOCATE EXISTING OR<br>SP. DISPENSER<br>N. DOWN R RAD. RADIUS<br>POWN R RAD. RADIUS<br>DOOR OPENING REF. REFERENCE<br>SALVAGE FOR RELOCATION<br>N. DOWN R REF. REFERENCE<br>RESIL. REFICIEND<br>N. DOOR OPENING REF. REFERENCE<br>RESUL. RESILIENT<br>N. DOWN R REF. REFICIEND<br>N. DOOR OPENING REF. REFICIEND<br>N. DOWN R REF. REFICIEND<br>N. DOWN R REF. REFICIEND<br>N. DOWN R REFL. REFICIEND<br>N. DOWN R REFL. REFICIEND<br>N. DOOR OPENING REFL. REFLICIEND<br>N. DOOR OPENING REFL. REFLICIEND<br>N. DOOR OPENING REFL. REFLICIEND<br>N. DOOR SPENT<br>N. DRAWER RESIL. RESILIENT<br>N. EXISTING TO REMAIN RM. ROOM<br>N. EXISTING TO REMAIN RM. ROUMD<br>LEVATION<br>LEC ELECTRICAL S.C. SOLID CORE<br>LECTICAL SC.C. SOLID CORE<br>LECTION<br>LEC ELECTRICAL SC.C. SOLID CORE<br>LECC FINISH FLOOR ELEVATION SS. STAINLESS STELL<br>FIRE EXTINGUISHER CABINET SIN. SIMILAR<br>LISSING S.M. SURFACE MOUNTED<br>LISSING CORE STIL. STELL<br>LECCTRICAL SC.C. REVELLESS STELL<br>LISSING SUSPENDED<br>FLOOR FLOOR S.F. SUNDARD<br>FLOOR FLOOR S.F. SUNDARD<br>FLOOR FLOOR S.F. SUNDARD   | F.F.E.<br>ROOM NAME<br>#<br>#<br>STAIR/RAMP UP<br>##% SLOPE<br>ALIGN   | AREA OF R<br>REVISION N<br>FINISH FLO<br>ROOM NAM<br>ROOM NUM   |
| ORR.CORRIDORPR.PAIRTR.CENTERPT.PAINTTR.CENTERPT.PAINTDEMOLISHPTD.PAINT TO MATCHBL.DOUBLEPTD.PAINTEDBL.DOUBLEPRIN.PARTITIONET.DEPARTMENTC.T.QUARRY TILEIA.DIMENSIONRRELOCATE EXISTING ORISP.DISPENSERSALVAGE FOR RELOCATIONN.DOWNRAD.RADIUSO.DOOR OPENINGREF.REFERENCER.DOORREFL.REFLECTEDWG.DRAWERREQ.REQUIREDWR.DRAWERREQ.REQUIREDEXISTING TO REMAINRM.ROMA.EACHR.O.ROUGH OPENINGLEC.ELECTRICALS.C.SOLID CORELEC.ELECATIONSCHEDLSCHEDLELEC.ELECATIONSCHED.SCHEDULELC.ELEVATIONSCHED.SCHEDULELC.ELEVATIONSM.SUMLARXIST.EXISTING TO REMAINSM.SUMLARXIST.EXISTINGSM.SUMLARLEV.ELEVATIONSC.SOLID CORELEV.ELEVATIONSC.SOLID CORELEV.ELEVATIONSC.SOLID CORELEV.ELEVATIONSC.SOLID CORELEV.ELEVATIONSC.SOLID CORELEV.ELEVATIONSC.SOLID CORELEV.ELEVATIONSM.S  | F.F.E.<br>ROOM NAME<br>#<br>#<br>STAIR/RAMP UP<br>##% SLOPE<br>ALIGN   | REVISION N     FINISH FLOP     ROOM NAM     ROOM NUM  |
| BL.DOUBLEPRTN.PARTITIONEPT.DEPARTMENTQ.T.QUARRY TILEET.DETAILQ.T.QUARRY TILEA.DIAMETERRELOCATE EXISTING ORISP.DISPENSERSALVAGE FOR RELOCATIONN.DOWNRAD.RADIUSO.DOOR OPENINGREF.REFRENCER.DOOR OPENINGREF.REFRENCER.DOORREFR.REFRIGERATORWG.DRAWINGREFR.REFRIGERATORWR.DRAWERREO.REOUREDWR.DRAWERREO.ROUGH OPENINGLEVATIONRESILRESILIENTC.ELEVATIONSCHED.SCHEDULELEVATIONSCHED.SCHEDULELEVATIONSCHED.SCHEDULELEVATIONSCHED.SCHEDULELEVATIONSCHED.SCHEDULELEVATIONSCHED.SCHEDULELEVATIONSURFACE MOUNTEDLEVATIONSURFACE MOUNTEDLEVATIONSURFACE MOUNTEDLEVATIONSLSURFACE MOUNTEDLEVATIONSLSURFACE MOUNTEDC.L.ENCLOSURESLSURFACE MOUNTEDSLSURFACE MOUNTEDC.L.EVISTING SCHERSTAC.T.ECCSPECIFICATIONSQ.SQUAREF.E.FINSH FLOOR ELEVATIONSS.STAINLESS STEELSTAINLESS STEELE.FINE HOSE CABINETSTO.STANDARDSUSPENDEDL.C.FIRE ENS   | F.F.E.<br>ROOM NAME<br>#<br>#<br>STAIR/RAMP UP<br>##% SLOPE<br>ALIGN   | ROOM NAM  |
| A.DIAMETERM.DIMENSIONRRELOCATE EXISTING ORSP.DISPENSERSALVAGE FOR RELOCATIONN.DOWNRAD.RADUSO.DOOR OPENINGREF.REFERENCEX.DOORREFR.REFERENCENG.DRAWINGREFR.REFIGERATORWR.DRAWERREQ.REQUIREDV.EXISTING TO REMAINRM.ROOMV.EXISTING TO REMAINRM.ROOMLECELEVATIONS.C.SOLID COREELEVATIONSCHED.SCHEDLELEVATIONSCHED.SCHEDLEEQUIPMENTSIM.SIMILAREQUIPMENTSIM.SIMILAREQUIPMENTSM.SURFACE MOUNTEDEXISTING CRELEVATIONSS.STATINLESS STEELEXISTINGSTA.STATIONFRE EXTINGUISHERSTA.STATIONFIRE EXTINGUISHER CABINETSTD.STANDARDFIRE EXTINGUISHER CABINETSTD.STANDARDFIRE HOSESTOR.STORAGEFINISHLOORSTORAGEFLOORSUSPSUSPENDEDFLOORSTORSTORAGEFLOORSTORSTORAGEFLOORSTORSTORAGEFLOORSUSP SUSPENDEDFLOORSTORAGEFLOOR FINISHTANDG <td>F.F.E.<br/>ROOM NAME<br/>#<br/>#<br/>STAIR/RAMP UP<br/>##% SLOPE<br/>ALIGN</td> <td>ROOM NAM</td>   | F.F.E.<br>ROOM NAME<br>#<br>#<br>STAIR/RAMP UP<br>##% SLOPE<br>ALIGN   | ROOM NAM  |
| I.DOWNRAD.RADUSDOOR OPENINGREF.REFRENCEDOORREFL.REFLECTEDVG.DRAWINGREFR.REFLIGERATORVR.DRAWERREQ.REQUIREDVR.DRAWERREQ.RESILENTVR.DRAWERR.O.ROUGH OPENINGELEVATIONR.O.ROUGH OPENINGC.ELEVATIONSCHED.SCHEDULEEC.ELEVATIONSCHED.SCHEDULECL.EQUALSHT.SHEETPT.EQUIPMENTSIM.SIMLARIST.EXISTING SCHELEVATIONSM.SURFACE MOUNTEDIST.EXISTING SCHELEVATIONSS.STAINLESS STEELT.ETRIORSPEC.SPECIFICATIONE.E.FINISH FLOOR ELEVATIONSS.STAINLESS STEELE.C.FIRE EXTINGUISHERSTA.STANDARDI.C.FIRE EXTINGUISHERSTA.STANDARDI.FIRE EXTINGUISHER CABINETSTOR.STANDARDI.FIRE HOSE CABINETSTOR.STANDARDI.FIRE HOSE CABINETSTOR.STANDARDI.FIRE HOSE CABINETSTOR.STORAGEI.FICORSTOR.STORAGEI.FICE HOSE CABINETSTOR.STORAGEI.FIRE HOSE CABINETSTOR.STORAGEI.FIRE HOSE CABINETSTOR.STORAGEI.FICORSLOPENDEDSUSPENDEDI.FICORSLOPENISHEDSUSPENDEDI.<   | #<br>STAIR/RAMP UP<br>##% SLOPE<br>ALIGN   | ROOM NUM  |
| VR.DRAWERREQ.REQUIRED<br>RESIL.VR.EXISTING TO REMAINRM.ROOMEXISTING TO REMAINRM.ROOMEACHR.O.ROUGH OPENINGELEVATIONSC.SOLID COREEV.ELECTRICALS.C.SOLID COREEV.ELEVATIONSCHED.SCHEDULECL.ENCLOSURESECT.SECTIONLEQUALSHT.SHEETPT.EQUIPMENTSIM.SIMILARIST.EXISTINGS.M.SURFACE MOUNTEDT.EXTERIORSPEC.SPECIFICATIONS.STAINLESS STEELSC.STAINLESS STEELE.FIRE EXTINGUISHERSTA.STAINLESS STEELC.FIRE EXTINGUISHER CABINETSTD.STANDARDI.FIRE HOSESTL.STEELI.C.FIRE HOSE CABINETSTOR.STORAGEI.FINISHSUSPEN SUSPENDEDI.FINISHSUSPENDEDI.FINISHSUSPENDEDI.FINISHSUSPENDEDI.FLOORS.F.SQUARE FEETG.FLOORINGTANDGTONGUE AND GROOVE  | ##% SLOPE  | STAIR/RAM   |
| EACHR.O.ROUGH OPENINGELEVATIONS.C.SOLID COREEV.ELECTRICALS.C.SOLID COREEV.ELEVATIONSCHED.SCHEDULECL.ENCLOSURESECT.SECTIONLEQUALSHT.SHEETPT.EQUIPMENTSIM.SIMILARIST.EXISTINGS.M.SURFACE MOUNTEDT.EXTERIORSPEC.SPECIFICATIONT.EXTERIORSS.STAINLESS STEELE.E.FINISH FLOOR ELEVATIONSS.STAINLESS STEELE.E.FIRE EXTINGUISHERSTA.STANDARDI.FIRE EXTINGUISHER CABINETSTD.STANDARDI.FIRE HOSESTL.STEELI.C.FIRE HOSE CABINETSTOR.STORAGEI.FINISHFLOORSUSPSUSPENDEDI.FLOORS.F.SQUARE FEETG.FLOORS.F.SQUARE FEETO.F.FACE OF FINISHTANDGTONGUE AND GROOVE  | ALIGN —  |   |
| CL.ENCLOSURE<br>EQUALSECT.SECTION<br>SHEETPT.EQUIPMENTSHT.SHEETIST.EXISTINGSIM.SIMILARIST.EXISTINGS.M.SURFACE MOUNTEDT.EXTERIORSPEC.SPECIFICATIONE.FINISH FLOOR ELEVATIONSS.STAINLESS STEELI.FIRE EXTINGUISHERSTA.STAINLESS STEELI.FIRE EXTINGUISHER CABINETSTD.STANDARDI.FIRE HOSESTL.STEELI.C.FIRE HOSE CABINETSTOR.STORAGEI.FINISH<br>FLOORSUSPSUSPENDEDI.FINISH<br>FLOORS.F.SQUARE FEETG.FLOORINGSTANDGTONGUE AND GROOVE   | ¥  |   |
| IST. EXISTING S.M. SURFACE MOUNTED<br>T. EXTERIOR SPEC. SPECIFICATION<br>SQ. SQUARE<br>E. FINISH FLOOR ELEVATION SS. STAINLESS STEEL<br>FIRE EXTINGUISHER STA. STATION<br>C. FIRE EXTINGUISHER CABINET STD. STANDARD<br>I. FIRE HOSE STEEL STD. STEEL<br>A.C. FIRE HOSE CABINET STD. STORAGE<br>I. FINISH SUSP SUSPENDED<br>FLOOR S.F. SQUARE FEET<br>G. FLOORING<br>D.F. FACE OF FINISH TANDG TONGUE AND GROOVE   | N RUE  | ALIGN   |
| E.FINISH FLOOR ELEVATIONSS.STAINLESS STEELFIRE EXTINGUISHERSTA.STATIONE.C.FIRE EXTINGUISHER CABINETSTD.STANDARDI.FIRE HOSESTL.STEELI.C.FIRE HOSE CABINETSTOR.STORAGEI.C.FINISHSUSPSUSPENDEDI.C.FLOORS.F.SQUARE FEETG.FLOORINGTANDGTONGUE AND GROOVE  |  | T. T  |
| .C.     FIRE HOSE CABINET     STOR.     STORAGE       I.     FINISH     SUSP     SUSPENDED       FLOOR     S.F.     SQUARE FEET       G.     FLOORING     TANDG     TONGUE AND GROOVE  |  | PLAN NORT   |
| G. FLOORING<br>D.F. FACE OF FINISH TANDG TONGUE AND GROOVE   | (#)  | KEYNOTE S   |
|  |  | X DOOR NUM  |
| PRF.     FIRE PROOF     TEL.     TELEPHONE       R.T.     FIRE RETARDANT TREATED     TER.     TERRAZZO       -     FOOT OR FEET     THK.     THICK       JRR.     FURRING     T.O.     TOP OF  |  | WALL SYME   |
| UT. FUTURE T.O.P. TOP OF PARAPET<br>T.O.L. TOP OF LID<br>A. GAUGE T.V. TELEVISION  | N.I.C.   |   |
| ALV. GALVANIZED TYP. TYPICAL<br>C GENERAL CONTRACTOR<br>.D. GARBAGE DISPOSAL U.B.C. UNIFORM BUILDING CODE<br>L. GLASS OR GLAZING UNF. UNFINISHED   | E  | EXISTING T  |
| YP. GYPSUM U.O.N. UNLESS OTHERWISE NOTED<br>YP. BD. GYPSUM BOARD<br>V. VOLT  | N  | NEW   |
| C.         HOLLOW CORE         VERT.         VERTICAL           .D.         HEAD         VEST.         VESTIBULE           DWD.         HARDWOOD         V.I.F.         VERIFY IN FIELD           DWR.         HARDWARE         V.T.         VINYL TILE  | D  | DEMO<br>RELOCATE  |
| DWR. HARDWARE V.T. VINYL TILE<br>GT. HEIGHT<br>.M. HOLLOW METAL W/ WITH<br>ORIZ. HORIZONTAL WD. WOOD   |  |   |
| R. HOUR W.H. WATER HEATER<br>VAC HEATING, VENTILATION AND AIR W.A. WOLCOTT ARCHITECTURE<br>CONDITIONING W/O WITHOUT  |  | ~~~~~~~~~~~~~~~~~~~~~~~~~~~~~~~~~~~~~~  |
| WP.WATERPROOFINSIDE DIAMETERWSCT.WAINSCOTINFORMATIONWS.WORKSTATIONSUL.INSULATIONWT.WEIGHT  |  |   |
| IT. INTERIOR<br>T. INFORMATION TECHNOLOGY  |  | , CONCESSIONS, INCENTIVES & W   |
| SATELLITE MAP  | WE ARE REQUESTING A 50%  | 6 DENSITY BONUS AND WILL ALLC<br>ANTS. SATISFY'S BURBANK'S INCL   |
| Chick-fil-A<br>Fast-Foode S<br>eda NVP   | LOT AREA<br>GROSS LOT AREA:<br>(FOR PURPOSE OF CALC  | 71,829 SF (1.649  |
| E E E E E E E E E E E E  | DWELLING UNIT COUNT)   |   |
| Academy   Los Angales  | (INCLUDES CALIFORNIA<br>EASEMENT FOR PURPOS<br>CALCULATING FAR)  | ST. AND   |
| Whole Foods Market Burbank, CA 91505   | RETAIL AREA<br>EXISTING PD 2001-2 LAND AF<br>PD 2001-2 RESIDENTIAL DEN   |   |
| 3 AV <sup>®</sup> Studio 9 Burb  | BASE DENSITY ALLOWED   | OUNDED UP PER SDB 65915(Q)  |
| Talaria<br>O due dus Tax Shield  | BASE PROJECT PROPOSED<br>% AFFORDABLE (VERY LOW)   |   |
| Ventura Fwy Monton's The Steakhouse  | AFFORDABLE UNITS<br>AFFORDABLE UNITS, ROUNE  |   |
| VEDITE FUT   | STATE DENSITY BONUS (50%<br>TOTAL RESIDENTIAL DENSIT   |   |
| ash City National Bank   | APPLICABLE ADDRESSES:  | 3004 W. OLIVE AVE., BURBANK<br>3305 W. OLIVE AVE., BURBANK<br>3311 W. OLIVE AVE., BURBANK   |
| City National Bank W Riverside Dr<br>Q<br>New York Film 8 9  |  | 3321 W. OLIVE AVE., BURBANK<br>(3 PARCELS ON PROPOSED SI<br>AS "NO ADD.")   |
|  | ASSESSOR'S PARCEL #(S):  | 2484-024-401, 2483-023-419, 24<br>2483-023-421, 2483-023-422, 24<br>2483-023-432  |
| VICINITY MAP   | TRACT:   | 2483-023-432<br>10135 MB 141-21-22  |
| Woakst z st z  | MAP REFERENCE:   | MR 43 - 47 - 59<br>MEDIA DISTRICT COMMERCIAL  |
| M Cordova St Lim Nom N Fairview S  |  | DEVELOPMENT STANDARDS B<br>ARTICLE 21 10-1-2101 (MDM-1)   |
|  | ZONING SETBACKS<br>RESIDENTIAL   |   |
| Wienerschnitzel W Alameda Ave  | (NOT A RESIDENTIAL ZO<br>COMMERCIAL<br>PER MEDIA DISTRICT PL   | ,   |
| A Avon St wollie Ave   | PORTION OF BUILDING T  | ALLER THAN 8' - 11"   |
| Whole Foods Marret P S3321 W Olive Ave,<br>Burbank, CA 91505   | 15' IN HT. MUST HAVE AN<br>SETBACK OF 20% FROM<br>RIGHT-OF-WAY (PROP. L  | STREET HT. X 0.2)   |
|  | FENCE, WALL, HEDGE HEIGI<br>WITHIN SETBACKS<br>FENCE AND WALL  | HTS ALLOWABLE<br>4' - 0"  |
| Talaria Vientura Fwy   | HEDGE<br>OUTSIDE OF SETBACKS<br>FENCE AND WALL   | 6' - 0"<br>8' -0"   |
| W Rives  | HEDGE  | 12' - 0"<br><b>ALLOWABLE</b>  |
|  | (MEASURED FROM AVG. NA<br>GRADE TO CEILING HEIGHT<br>THE HIGHEST ROOM OF OCC   | TURAL<br>OF   |
| d DT entre   | DISTANCE FROM R-1, R-2<br>150' - 300'<br>300' - 500'   | 2 LOT LINE<br>50'<br>70'  |
| 5 C 2 R 2 2 2 2 2 2 2 2 2 2 2 2 2 2 2 2 2  | # OF STORIES:  | 2   |
| MAP N.T.S 3201 W OLIVE AVE   | -  |   |

|  | ~~~~~~~~~~~~~~~~~~~~~~~~~~~~~~~~~~~~~~  | ~~~~~~~~~~~~~~~~~~~~~~~~~~~~~~~~~~~~~~~ | ~~~~~~~~~~~~~~~~~~~~~~~~~~~~~~~~~~~~~~                |                      | $\sim$                       |
|--|---|---|---|----------------------|------------------------------|
| SYMBOLS  | <pre>PR</pre>   | OJECT TEA                               | Μ   |                      |                              |
|  |   |   |   |                      |                              |
|  | WOLCOTT ARCHITECTURE  | 100 WILS                                | REAL ESTATE GROUP<br>HIRE BLVD SUITE 2100             |                      |                              |
| STRUCTURAL GRID LINES  | LOS ANGELES, CA 90027<br>PHONE: 310.204.2290  |   | ONICA, CA 90401<br>310.393.9653                       |                      |                              |
| IMBER  | EMAIL: SPADDOCK@WOLCOTTAI.COM   |   | ADENR@WORTHE.COM<br>T: JADEN ROBBINS                  | DRAWING<br>NUMBER    |                              |
| MBER   | SECONDARY: ROBBIE MEHRING<br>EMAIL: RMEHRING@WOLCOTTAI.COM  |   |   | ARCHITECTUR<br>A000  | COVER                        |
| NUMBER<br>MBER   |   |   |   | A001<br>A002         | PROJEC<br>PROJEC             |
| EVATION IDENTIFICATION:  | PSOMAS<br>555 FLOWER ST.  |   |   | ARCHITECTUR<br>A111  | AL                           |
| N NUMBER<br>MBER   | SUITE 4300<br>PHONE: 661.705.4410   |   |   | CIVIL<br>C000        | CIVIL DR                     |
| ELEVATION IDENTIFICATION:  | EMAIL: JEREMY.JOHNSON@PSOMAS.COM  |   |   | ARCHITECTUR          | AL<br>SITE PLA               |
| N NUMBER   |   |   |   | A200<br>A201         | FLOOR F                      |
| MBER   | LANDSCAPE:       GLLB STUDIO  |   |   | A203<br>A204<br>A205 | ROOF PI<br>FLOOR F           |
| (OR ADDENDUM):<br>REVISION   | LOS ANGELES, CA   |   |   | A300<br>A301<br>A302 | EXTERIC<br>ENLARG<br>ENLARG  |
| NUMBER   | PHONE: 310.625.2029<br>EMAIL: EGIBSON@GLLBSTUDIO.COM  |   |   | A303<br>A400         | ENLARG<br>BUILDIN            |
| OOR ELEVATION SYMBOL   | CONTACT: ERIC GIBSON  |   |   | A410<br>A600<br>A601 | ENLARG<br>ENLARG<br>ENLARG   |
| ME<br>MBER   |   |   |   | A602<br>A603         | ENLARG<br>ENLARG             |
| VIDER  |   |   |   | A604<br>A710<br>A900 | ENLARG<br>SCHEDU<br>SITE CO  |
| IP DIRECTION: ARROW POINTS UP  |   |   |   | A901                 | VIEWS A                      |
|  |   |   |   | L1.0<br>L1.1         | OVERAL<br>HARDSC             |
|  |   |   |   | L1.2<br>L1.3<br>L1.4 | LANDSC<br>CONCEF<br>PLANT II |
|  |   |   |   | L1.5                 | PLANT II                     |
| TH REFERENCE   |   |   |   |                      |                              |
| SYMBOL   |   | CT DESCRT                               |   | _                    |                              |
| MBER   | SCOPE OF WORK:  |   | TION  | _                    |                              |
| BOL TYPE   | LOCATED AT 3201 W. OLIVE AVE., ALSO KNOWN A<br>CONTEMPORARY STYLE MULTI-STORY RESIDEN   |   |   |                      |                              |
|  | AND GYM AMENITIES, TO BE BUILT ON A VACANT<br>2-BEDROOM UNITS WITH BALCONIES.   |   |   |                      |                              |
| ONTRACT": NO WORK IN THIS AREA   |   |   |   |                      |                              |
|  |   |   |   |                      |                              |
| E EXISTING/SALVAGE FOR RELOCATION (AT DEMO PLA                                 |   |   |   |                      |                              |
|  |   |   |   |                      |                              |
|  |   |   |   |                      |                              |
| BURBANK PLA  | NNING TABULATIONS   |   |   |                      |                              |
| WAIVERS PER SB 35)   |   | L <b>OWABLE</b><br>037 SF (60%)         | PROPOSED<br>29,424 SF                                 |                      |                              |
| OCATE 15% OF OUR BASE PROJECT'S UNITS<br>LUSIONARY HOUSING REQ. OF 15% OF BASE | (USING NET LOT AREA AND LIMITED TO  |   | PROPOSED<br>0.02 FAR<br>(1,058 SF RETAIL / 58,395 SF) |                      |                              |
|  | =64   | (,234 SF)                               |   |                      |                              |
| 9 ACRES)   | (EXCLUDES SHAFTS & STAIRS)<br>RETAIL  | ,058 SF<br>0,666 SF                     |   | que                  | mm                           |
| ACRES)   | TOTAL 131   | ,724 SF                                 |   |                      |                              |
|  |   | TOTAL PERCENTA                          | <u>\GE</u>  |                      |                              |
| <b>1,058 SF</b><br>1.65 ACRES (71,829 SF)<br>58 DU/ACRE                        | 2BR:       7       6       6       6         1BR:       12       20       20       20         STUDIO:       2       6       6       6 | 2521.4%7261.5%2017.1%                   |   |                      |                              |
| 77.72 DU<br>78 DU<br><b>78 DU</b>  | TOTAL: 21 32 32 32  | 117                                     |   |                      |                              |
| 15%<br>11.7 DU   | ALLOCATES 12 UNITS AS VERY LOW INCOME (15<br>MARKET RATE UNITS INCLUDE ONE ON-SITE RES  | IDENT MANAGERUNIT.                      |   |                      |                              |
| 12 DU<br>39 DU   | FIFTEEN UNITS WILL BE DEED-RESTRICTED AFFC  |   | TS (VERT LOW INCOME) FOR 35 TEARS.                    |                      |                              |
| <b>117 DU</b><br><, CA 91505   | NOTE: STATE DENSITY BONUS LAW REQUIRES A<br>RETAIL PARKS TO CODE. GUEST PARKING IS NOT  |   |   |                      |                              |
| <, CA 91505<br><, CA 91505<br><, CA 91505<br><, CA 91505                       | USE FORMULA UNIT COUNT/SF<br>RETAIL 3.3 PER 1,000SF 1,058 SF  | REQUIRED<br>3.4 (3) STALLS              | PROPOSED<br>4 STALLS                                  |                      |                              |
| K, CA 91505<br>ITE LISTED  | RESIDENTIAL 0.5 PER UNIT 117 UNITS  | 59 STALLS<br>63 STALLS                  | 145 STALLS<br><u>(36 TANDEM)</u><br>181 STALLS        |                      |                              |
| 483-023-420,<br>183-023-431  | ACCESSIBLE PARKING RQTS (11B-208.2)   | REQUIRED                                | PROPOSED  |                      |                              |
|  | ACCESSIBLE STANDARD STALLS<br>ACCESSIBLE VAN STALL (11B-208.2.4)  | 5 STALLS<br>2 STALLS                    | 5 STALLS<br>2 STALLS                                  |                      |                              |
|  | TOTAL<br>ACCESSIBLE VAN EV STALL  | 7 STALLS<br>1 STALL                     | 7 STALLS<br>1 STALL                                   |                      |                              |
| L (MDC-2)<br>BASED ON MDC-2  |   |   |   |                      |                              |
| PROPOSED   | BICYCLE PARKING<br><u>SHORT TERM:</u><br>RESIDENTIAL (1 SPACE / 20 UNITS)   | REQUIRED                                | PROPOSED  |                      |                              |
|  | RETAIL (1 SPACE / 5000 SF)  | 1 8.2 (8)                               | 8 SPACES  |                      |                              |
| 5' - 0" (APPLIES TO SINGLE STORY<br>RETAIL BUILDING)                           | <u>LONG TERM:</u><br>RESIDENTIAL (1 SPACE / 4 UNITS)<br>RETAIL: (1 SPACE / 12,000 SF)   | 36<br>1                                 | 36<br>1   |                      |                              |
| 10' - 0" AVG. BLDG. ENVELOPE<br>8' - 0" AVG. OVERHANG / PROJECTION             | TOTAL:  | 37 SPACES                               | 37 SPACES   |                      |                              |
| PROPOSED   | OPEN SPACE REQUIREMENTS   |   |   |                      |                              |
| 3' - 0"<br>6' - 0" MAX.  | (NOT REQ'D IN MDC-2 & MDM-1 ZONE)   |   |   |                      |                              |
| 8' - 0" MAX.<br>6' - 0" MAX.   | (NOT REQ'D IN MDC-2 & MDM-1 ZONE)   | 5)                                      |   |                      |                              |
| ACTUAL   | (NOT REQ'D IN MDC-2 & MDM-1 ZONE)   |   |   |                      |                              |
|  |   |   |   |                      |                              |
| 44' - 6"<br>44' - 6"   |   |   |   |                      |                              |
| 4  |   |   |   |                      |                              |
|  |   |   |   |                      |                              |
|  |   |   |   | <                    |                              |

|                                 | S                                     | HEE              | ΞT                 | INE                    | DEX |
|---------------------------------|---------------------------------------|------------------|--------------------|------------------------|-----|
| DRAWING TITLE                   | PLANNING DEV. STANDARDS               | SCHEMATIC DESIGN | DESIGN DEVELOPMENT | CONSTRUCTION DOCUMENTS |     |
|                                 |                                       |                  |                    |                        |     |
| RSHEET                          |                                       |                  |                    |                        |     |
| ECT DATA                        | •                                     |                  |                    |                        |     |
| ECT REVISIONS                   | •                                     |                  |                    |                        |     |
|                                 |                                       |                  |                    |                        |     |
|                                 |                                       |                  |                    |                        |     |
| AGE SETBACK DIAGRAM - 2ND FLOOR | •                                     |                  |                    |                        |     |
|                                 |                                       |                  |                    |                        |     |
| DRAWING PACKAGE                 |                                       |                  |                    |                        |     |
|                                 |                                       |                  |                    |                        |     |
|                                 |                                       |                  |                    |                        |     |
| PLAN - PROPOSED                 | •                                     |                  |                    |                        |     |
| R PLAN - 1ST FLOOR              | •                                     |                  |                    |                        |     |
| R PLAN - 2ND-4TH FLOOR          | •                                     |                  |                    |                        |     |
| PLAN                            | •                                     |                  |                    |                        |     |
| R PLAN - P-1                    | •                                     |                  |                    |                        |     |
| R PLAN - P-2                    | •                                     |                  |                    |                        |     |
| RIOR ELEVATIONS                 | •                                     |                  |                    |                        |     |
| RGED EXTERIOR ELEVATIONS        | •                                     |                  |                    |                        |     |
| RGED EXTERIOR ELEVATIONS        | •                                     |                  |                    |                        |     |
| RGED EXTERIOR ELEVATIONS        | •                                     |                  |                    |                        |     |
| DING SECTIONS                   | •                                     |                  |                    |                        |     |
| RGED SECTIONS                   | •                                     |                  |                    |                        |     |
| RGED PLANS - TYP. UNITS         | •                                     |                  |                    |                        |     |
| RGED PLAN 1ST FLOOR - AREA A    | •                                     |                  |                    |                        |     |
| RGED PLAN 1ST FLOOR - AREA B    | •                                     |                  |                    |                        |     |
| RGED PLAN 2ND FLOOR - AREA A    | •                                     |                  |                    |                        |     |
| RGED PLAN 2ND FLOOR- AREA B     | •                                     |                  |                    |                        |     |
| DULE - FINISH AND FIXTURE       | •                                     |                  |                    |                        |     |
| CONTEXT PHOTOS                  | •                                     |                  |                    |                        |     |
| S AND IMAGES                    | •                                     |                  |                    |                        |     |
|                                 |                                       |                  |                    |                        |     |
|                                 |                                       |                  |                    |                        |     |
|                                 | •                                     |                  |                    |                        |     |
| OSCAPE CONCEPT PLAN             | •                                     |                  |                    |                        |     |
| SCAPE ELEVATIONS                | •                                     |                  |                    |                        |     |
| CEPTUAL PLANTING PLAN           | · · · · · · · · · · · · · · · · · · · |                  |                    |                        |     |
| T IMAGES<br>T IMAGES            | •                                     |                  |                    |                        |     |
|                                 | •                                     |                  |                    |                        |     |





DRAWN BY: RM PROJECT MANAGER: CC DRAWING SCALE: As indicated SHEET SIZE: 30X42 DRAWING TITLE:

SHEET NO: A001


PROJECT DATA


| PROJECT REVISION  |
|---|
| REVISION #02: PLANNING AND DEVELOPMENT STANDARDS  |
| A000<br>• UPDATED COVER SHEET TO LATEST SUBMITTAL   |
| <ul> <li>A001</li> <li>UPDATED PROJECT DATA UNIT COUNTS</li> <li>REMOVED A202 FROM INDEX</li> <li>REVISED CLIENT ADDRESS</li> <li>REVISED PARKING COUNT REQUIREMENTS</li> <li>REVISED BASE DENSITY ALLOWED AND DENSITY BONUS</li> <li>UPDATED SETBACK REQUIREMENTS</li> <li>UPDATED NUMBER OF STORIES</li> </ul>  |
| A002 <ul> <li>ADDED PROJECT REVISION SHEET</li> </ul>   |
| <ul> <li>A110</li> <li>REVISED SIDEWALK TO (E) CONDITION ALONG ALAMEDA AVE.</li> <li>ADDED DOOR TO (N) LEASING OFFICE ALONG ALAMEDA AVE.</li> <li>REVISED TO A 4-STORY APARTMENT BUILDING</li> <li>ADDED TRANSFORMER VAULT LOCATION</li> <li>RECESSED STAIRWAY EXIT DOORS TO COVER DOORWAYS</li> <li>UPDATED SITE TO SHOW LANDSCAPE PER LANDSCAPE DRAWINGS</li> <li>ADDED DESIGN ARTICULATION TO POOL WALL ALONG OLIVE AVE.</li> </ul> A111 <ul> <li>REVISED AVERAGE SETBACK CALCULATIONS BASED ON NEW HEIGHTS</li> </ul> |
| <ul> <li>ADDED LEASING OFFICE AND MAILROOM(RM 128)</li> <li>CHANGED MAINTENANCE ROOM TO ELECTRICAL ROOM(RM 161) AND DATA ROOM(RM133)</li> <li>REVISED "STAIR-A" FOOTPRINT</li> <li>REVISED TRASH ENCLOSURE, CHUTES, AND ADDED TRASH ENCLOSURE VESTIBULE</li> <li>ADDED TRANSFORMER VAULT LOCATION</li> <li>REMOVED (5) STUDIO UNITS AND (1) 1-BEDROOM AND ADDED (2) 2-BEDROOM UNITS</li> </ul>  |
| <ul> <li>A201</li> <li>REMOVED (2) 1-BEDROOM UNITS AND ADDED (1) 2-BEDROOM UNIT</li> <li>ADDED TRASH ENCLOSURE ROOM</li> <li>ADDED BALCONIES TO UNITS 221, 227, AND 204</li> <li>ADDED ROOF DRAIN TO RETAIL</li> <li>REVISED LAYOUT ON UNITS: <ol> <li>UNIT 203, 212, 215, 217, 219, AND 224</li> </ol> </li> </ul>   |
| A202<br>• REMOVED SHEET, NO LONGER USED   |
| <ul> <li>A203</li> <li>CHANGED ROOF DRAIN TYPE TO HAVE BOTH PRIMARY AND OVERFLOW DRAINS AS ONE TYPE.</li> <li>ADDED 5'-6" RETURN TO CANOPY</li> </ul>   |
| A204 & A205<br>• RELOCATED STAIR NO. 01 TO ALIGN W/ STAIRCASE ON LEVELS 2-4   |
| <ul> <li>A300</li> <li>REMOVED 5TH FLOOR</li> <li>REVISED LEVEL HEIGHTS TO HAVE 10'-06" FLOOR TO FLOOR HEIGHT ON LEVELS 2-4</li> <li>ADDED ELEVATION LOCATION MARKERS</li> <li>ADDED TRANSFORMER VAULT LOCATION (1/A300)</li> <li>ADDED BALCONIES TO UNITS, SEE A201 FOR LOCATIONS ON PLAN</li> </ul>   |
| <ul> <li>A301-A303</li> <li>UPDATED GLAZING PANEL LOCATIONS AND DIMENSIONS</li> <li>REVISED LEVEL HEIGHTS TO HAVE 10'-06" FLOOR TO FLOOR HEIGHT ON LEVELS 2-4</li> <li>REMOVED 5TH FLOOR</li> </ul>   |
| <ul> <li>A400-A410</li> <li>REVISED LEVEL HEIGHTS TO HAVE 10'-06" FLOOR TO FLOOR HEIGHT ON LEVELS 2-4</li> <li>REMOVED 5TH FLOOR</li> </ul>   |
| A601-A604 UPDATED ENLARGED PLANS WITH REVISED LAYOUT PER A200 AND A201  |
| A901 UPDATED RENDERS PER REMOVAL OF 5TH FLOOR   |

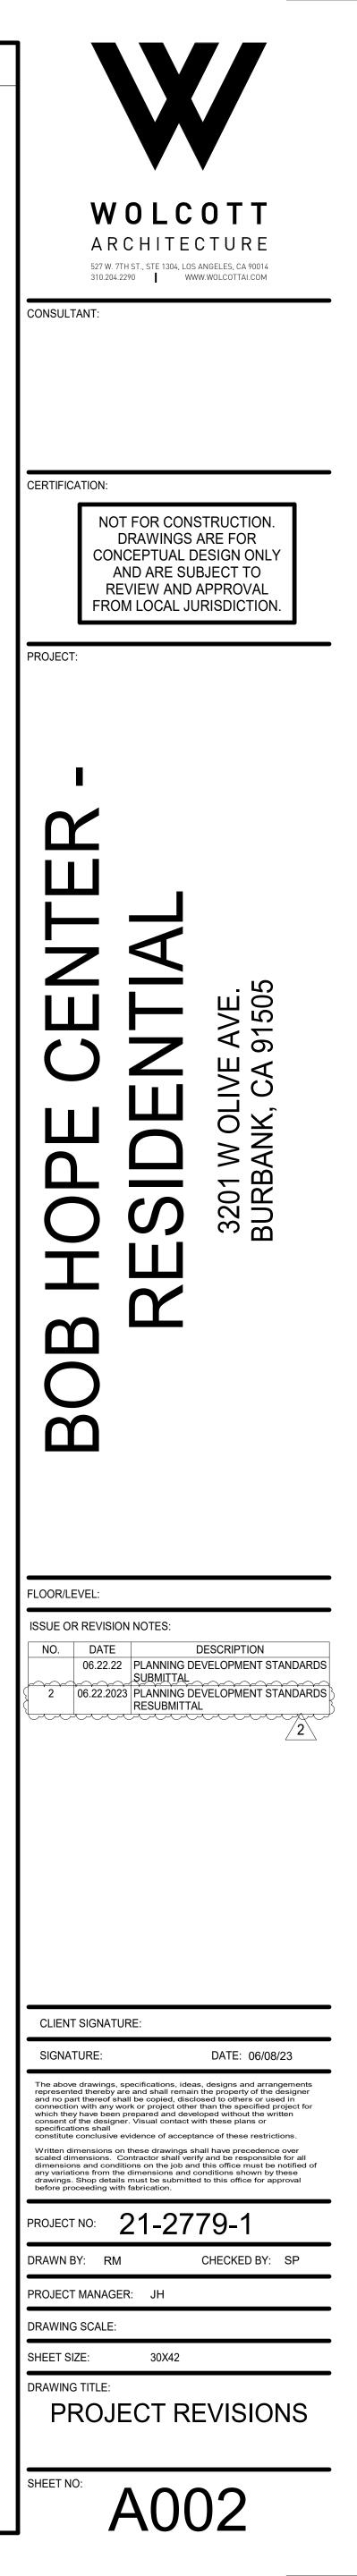

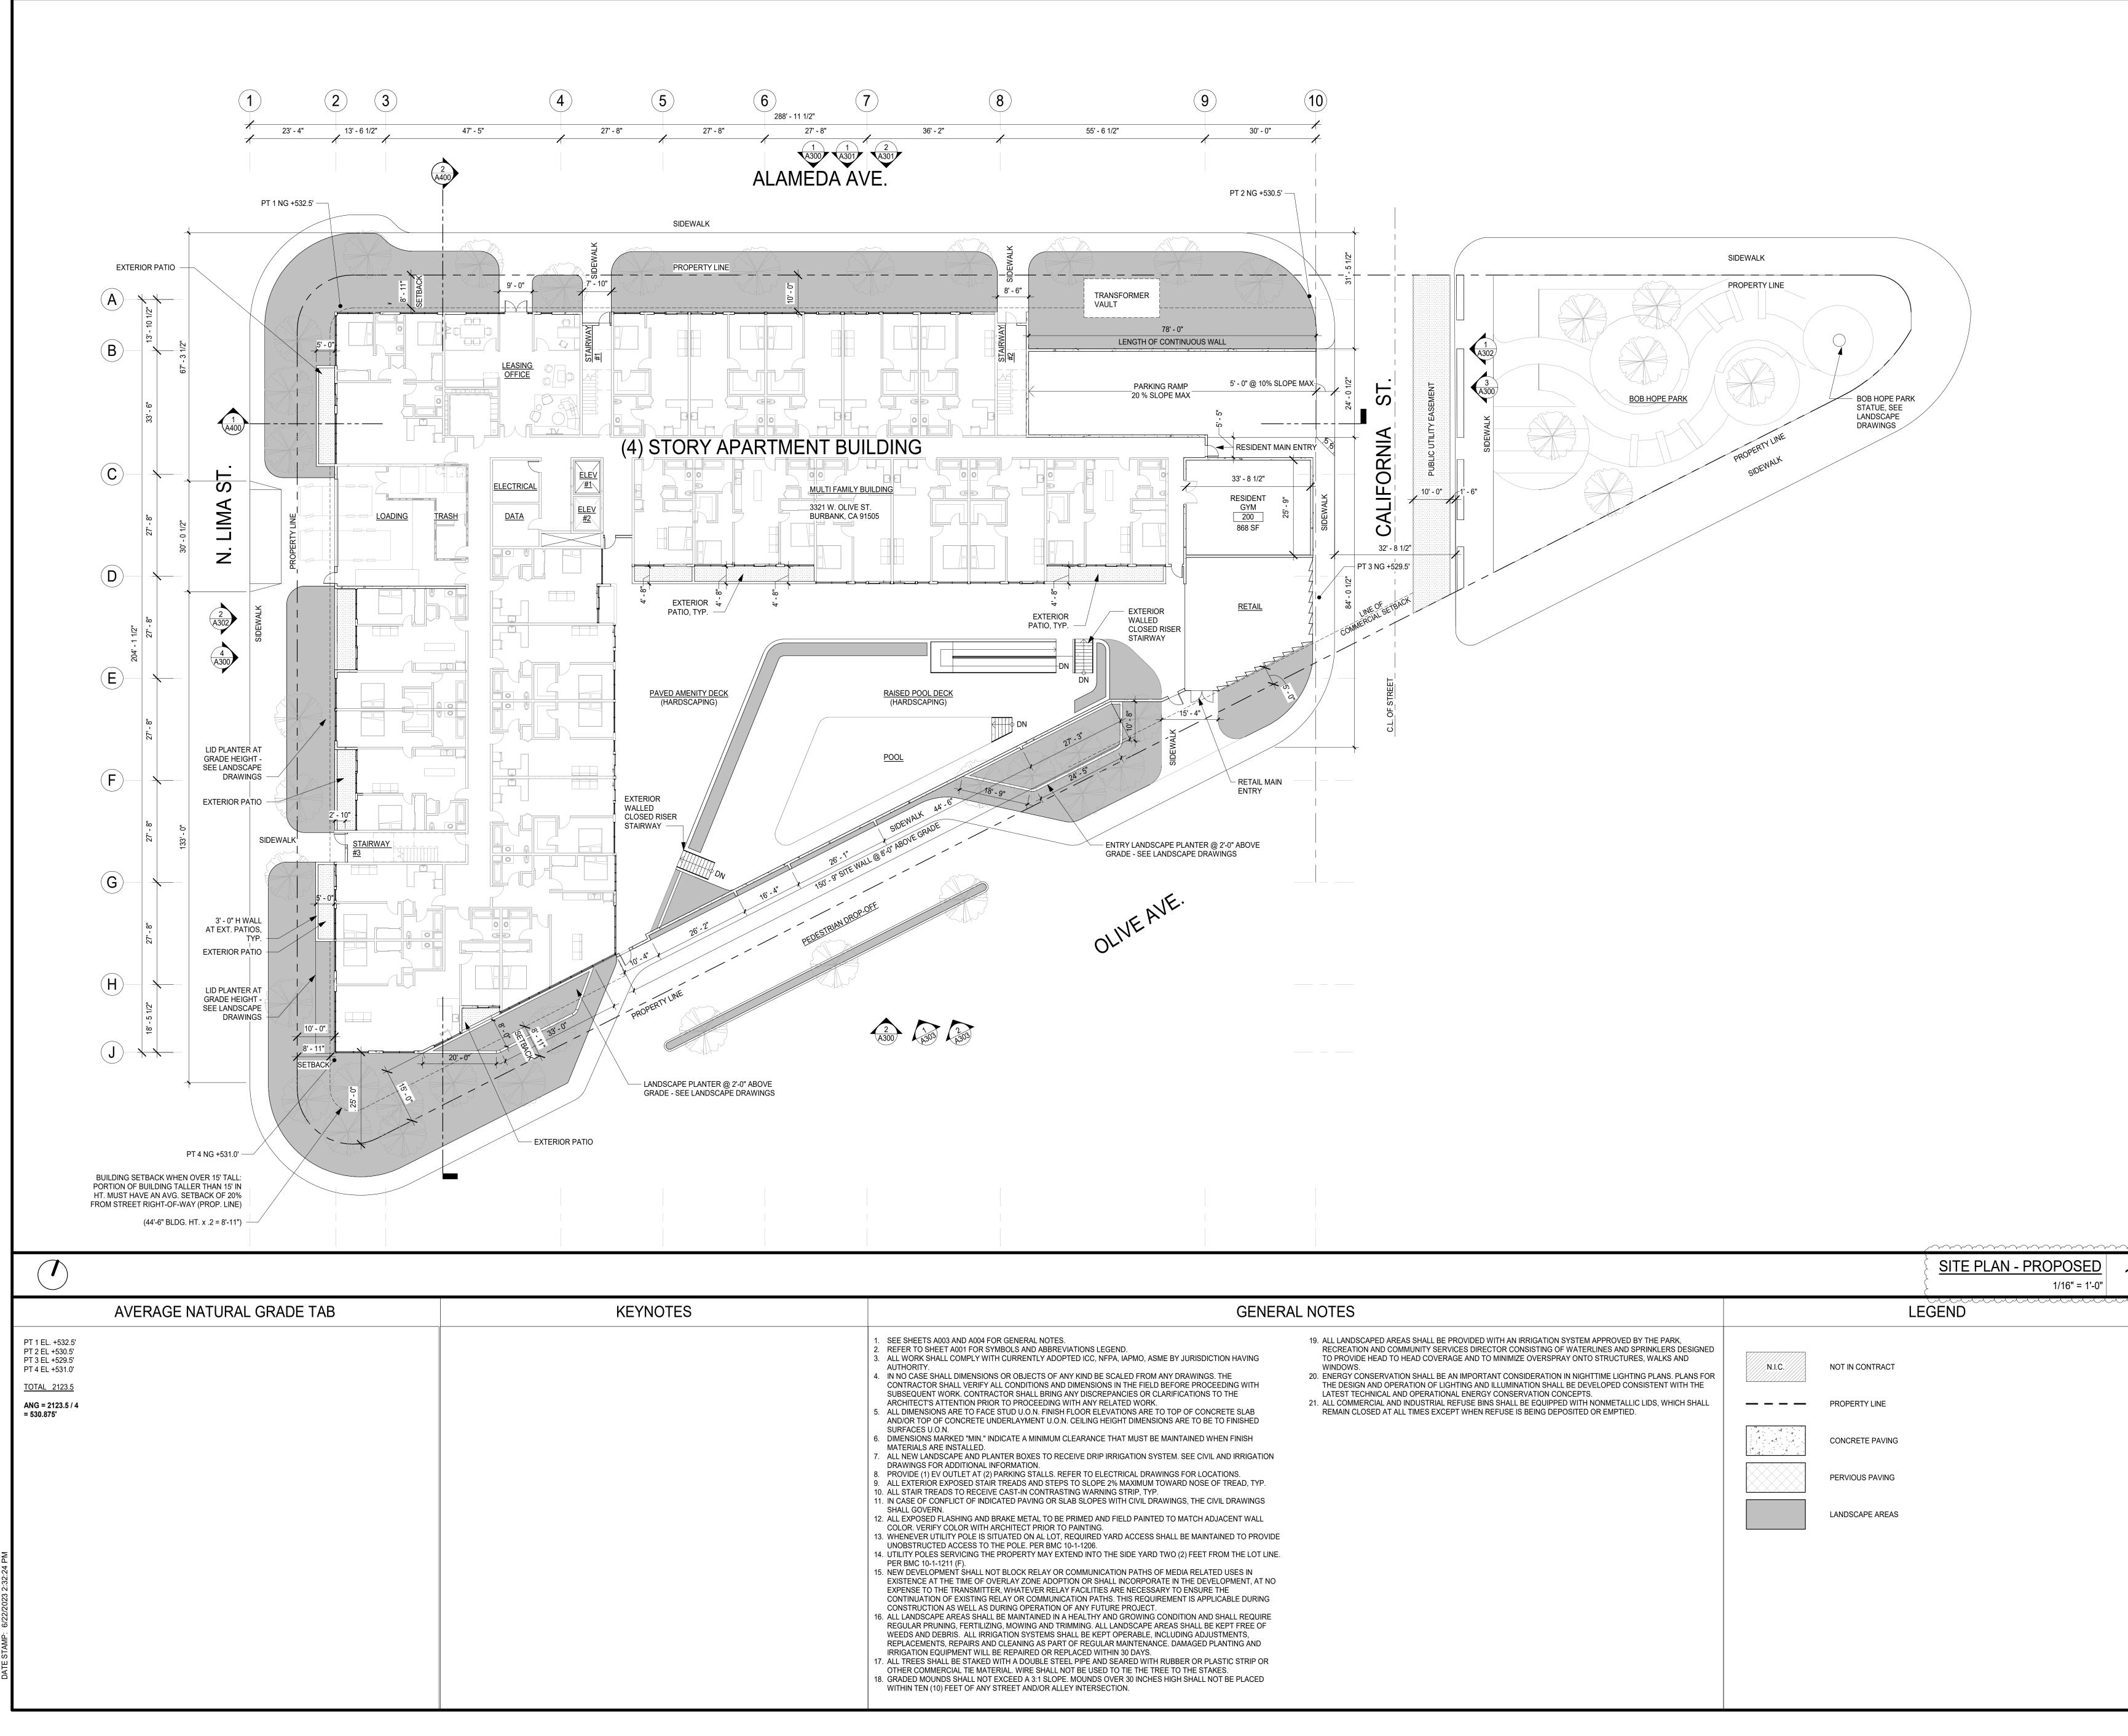

| NOTES | GENERA   | AL NOTES   |
|-------|--|--|
|       | <ol> <li>SEE SHEETS A003 AND A004 FOR GENERAL NOTES.</li> <li>REFER TO SHEET A001 FOR SYMBOLS AND ABBREVIATIONS LEGEND.</li> <li>ALL WORK SHALL COMPLY WITH CURRENTLY ADOPTED ICC, NFPA, IAPMO, ASME BY JURISDICTION HAVING<br/>AUTHORITY.</li> <li>IN NO CASE SHALL DIMENSIONS OR OBJECTS OF ANY KIND BE SCALED FROM ANY DRAWINGS. THE<br/>CONTRACTOR SHALL VERIFY ALL CONDITIONS AND DIMENSIONS IN THE FIELD BEFORE PROCEEDING WITH<br/>SUBSEQUENT WORK. CONTRACTOR SHALL BRING ANY DISCREPANCIES OR CLARFICATIONS TO THE<br/>ARCHTECTS ATTENTION PRIOTO TO PROCEEDING WITH HAV RELATED WORK.</li> <li>ALL DIMENSIONS ARE TO FACE STUD U.O.N. FINISH FLOOR ELEVATIONS ARE TO TOP OF CONCRETE SLAB<br/>AND/OR TOP OF CONCRETE UNDERLAYMENT U.O.N. CELING HEIGHT DIMENSIONS ARE TO BE TO FINISHED<br/>SURFACES U.O.N.</li> <li>DIMENSIONS MARKED "NIN." INDICATE A MINIMUM CLEARANCE THAT MUST BE MAINTAINED WHEN FINISH<br/>MATERIALS ARE INSTALLED.</li> <li>ALL NEW LANDSCAPE AND PLANTER BOXES TO RECEIVE DRIP IRRIGATION SYSTEM. SEE CIVIL AND IRRIGATION<br/>DRAWINGS FOR ADDITIONAL INFORMATION.</li> <li>PROVIDE (1) EV OUTLET AT (2) PARKING STALLS. REFER TO ELECTRICAL DRAWINGS FOR LOCATIONS.</li> <li>ALL EXTERIOR EXPOSED STAIR TREADS AND STEPS TO SLOPE 2% MAXIMUM TOWARD NOSE OF TREAD, TYP.</li> <li>ALL EXTERIOR EXPOSED STAIR TREADS AND STEPS TO SLOPE 2% MAXIMUM TOWARD NOSE OF TREAD, TYP.</li> <li>ALL EXTRENCE REMOVEN AND BRAKE METAL TO BE PRIMED AND FIELD PAINTED TO MATCH ADJACENT WALL<br/>COLOR. VERIFY COLOR WITH ARCHTECT PRIOR TO AMRINIG STIRP. TYP.</li> <li>IN CASE OF CONFLICT OF INDICATED PAVING OR SLAB SLOPES WITH CIVIL DRAWINGS, THE CIVIL DRAWINGS<br/>SHALL GOVERN.</li> <li>ALL EXPOSED FLASHING AND BRAKE METAL TO BE PRIMED AND FIELD PAINTED TO MATCH ADJACENT WALL<br/>COLOR. VERIFY COLOR WITH ARCHTECT PRIOR TO PAINTING.</li> <li>WHENEVER UTILITY POLE IS SITUATED ON AL LOT, REQUIRED TARD ACCESS SHALL BE MAINTAINED TO PROVIDE<br/>UNOBSTRUCTED THE THE OF OPOPERTY MAY EXTEND INTO THE SIDE YARD TWO (2) FEET FROM THE LOT LINE.<br/>PER BMC 10-1-1211 (F).<th><ol> <li>ALL LANDSCAPED A<br/>RECREATION AND O<br/>TO PROVIDE HEAD<br/>WINDOWS.</li> <li>ENERGY CONSERV.<br/>THE DESIGN AND O<br/>LATEST TECHNICAL</li> <li>ALL COMMERCIAL A<br/>REMAIN CLOSED AT</li> </ol></th></li></ol> | <ol> <li>ALL LANDSCAPED A<br/>RECREATION AND O<br/>TO PROVIDE HEAD<br/>WINDOWS.</li> <li>ENERGY CONSERV.<br/>THE DESIGN AND O<br/>LATEST TECHNICAL</li> <li>ALL COMMERCIAL A<br/>REMAIN CLOSED AT</li> </ol> |

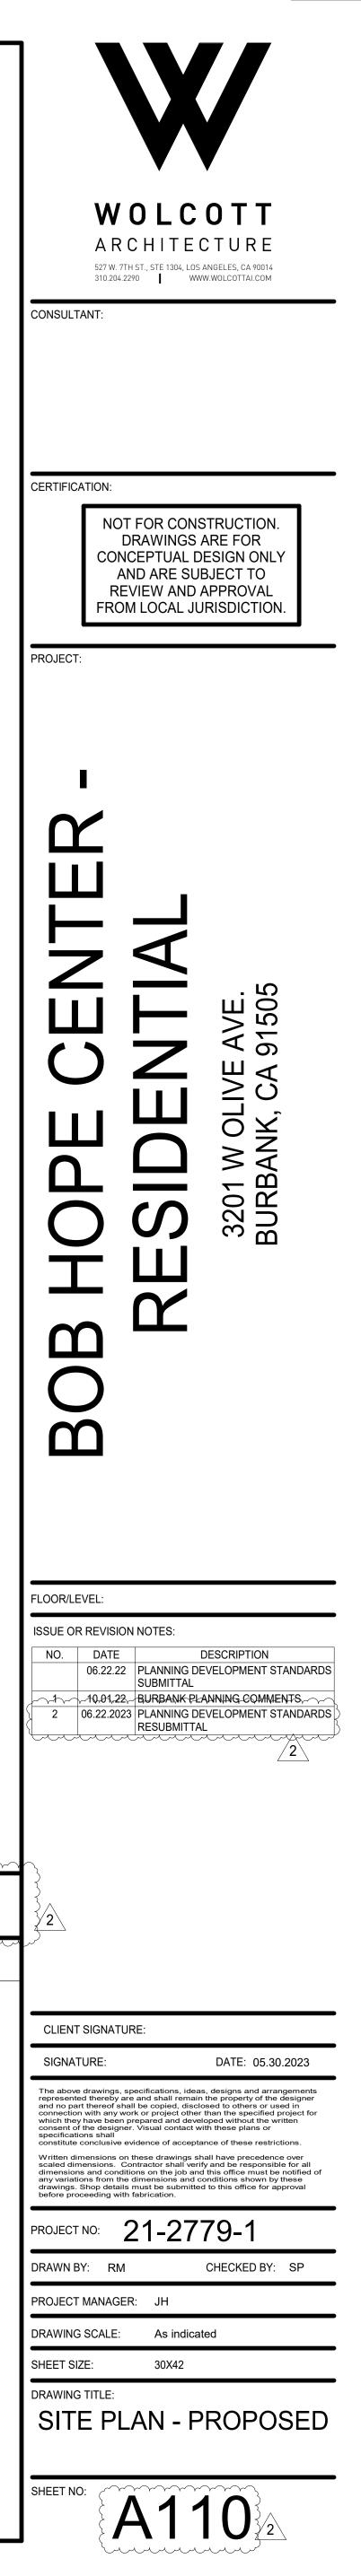


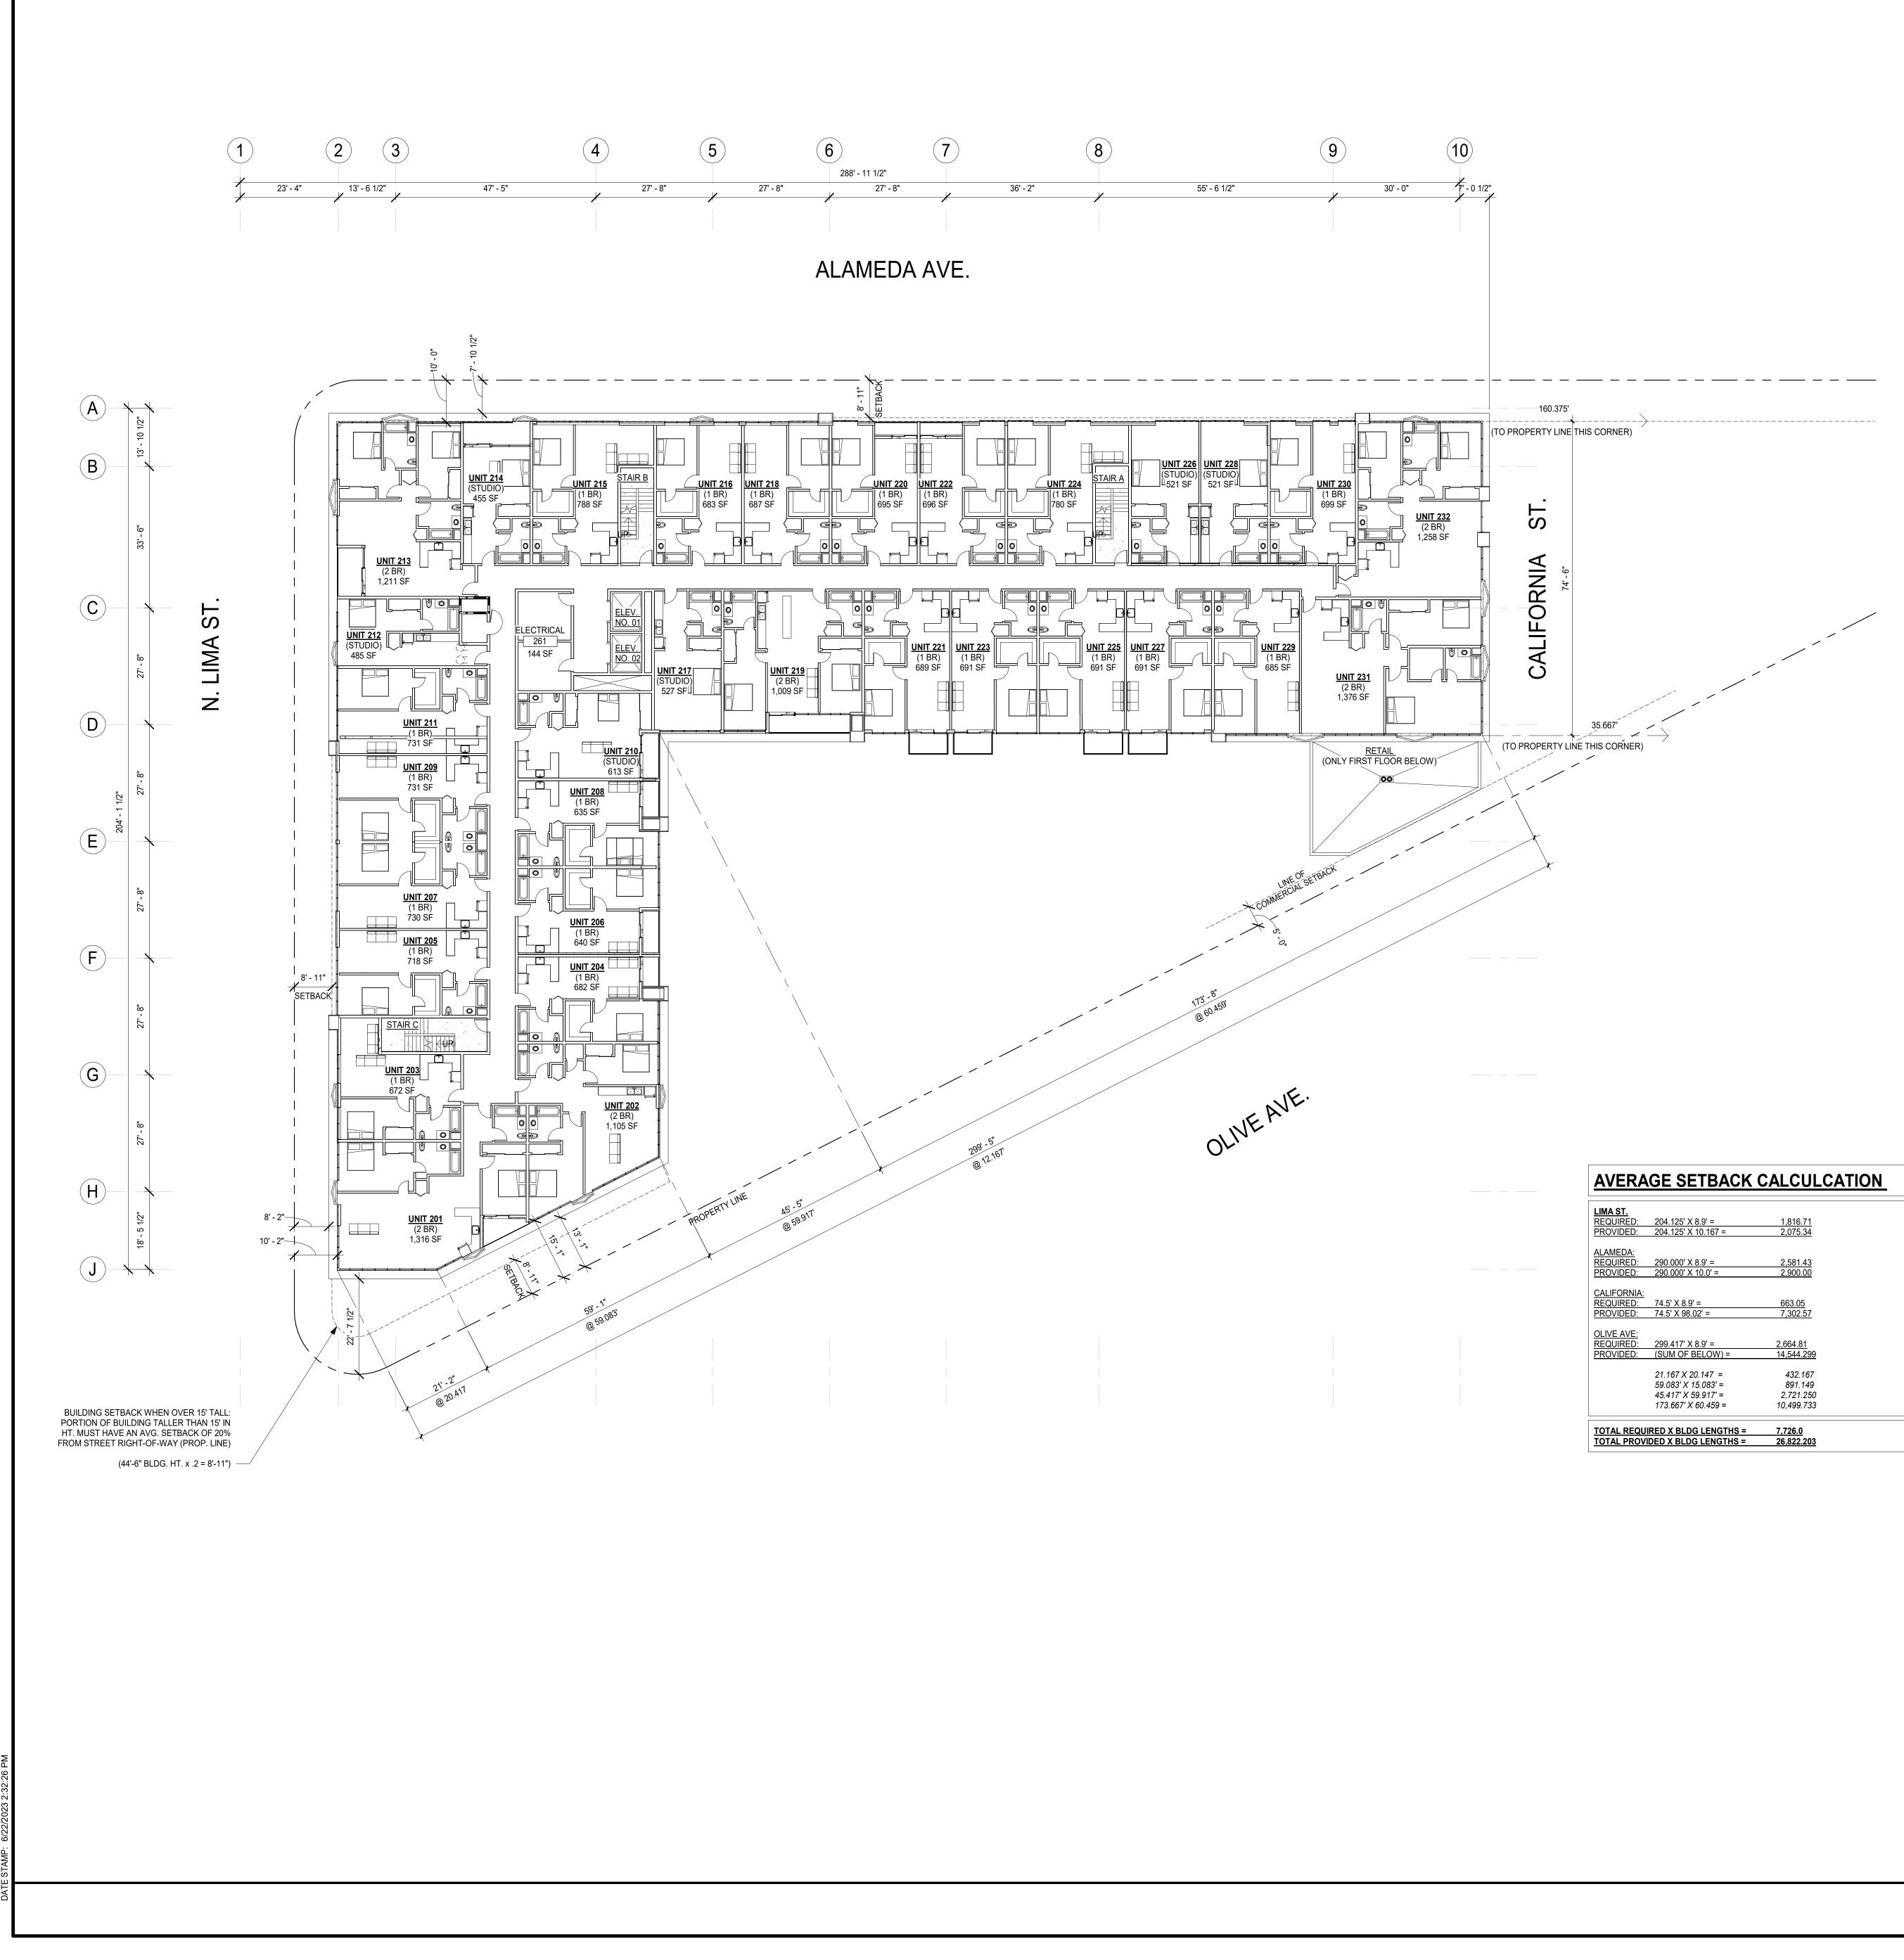


| TOTAL PROVI              | DED X BLDG LENGTHS =     | 26,822.203 |  |
|--------------------------|--------------------------|------------|--|
| TOTAL REQUI              | RED X BLDG LENGTHS =     | 7,726.0    |  |
|                          | 173.667' X 60.459 =      | 10,499.733 |  |
|                          | 45.417' X 59.917' =      | 2,721.250  |  |
|                          | 59.083' X 15.083' =      | 891.149    |  |
|                          | 21.167 X 20.147 =        | 432.167    |  |
| PROVIDED:                | (SUM OF BELOW) =         | 14,544.299 |  |
| REQUIRED:                | <u>299.417' X 8.9' =</u> | 2,664.81   |  |
| OLIVE AVE:               |                          | 0.004.04   |  |
| PROVIDED:                | 74.5' X 98.02' =         | 7,302.57   |  |
| CALIFORNIA:<br>REQUIRED: | 74.5' X 8.9' =           | 663.05     |  |
| PROVIDED:                | 290.000' X 10.0' =       | 2,900.00   |  |
| REQUIRED:                | 290.000' X 8.9' =        | 2,581.43   |  |
| ALAMEDA:                 |                          |            |  |
| PROVIDED:                | 204.125' X 10.167 =      | 2,075.34   |  |
| REQUIRED:                | 204.125' X 8.9' =        | 1,816.71   |  |
| LIMA ST.                 |                          |            |  |
|                          |                          |            |  |

∕2∖


1/16" = 1'-0"

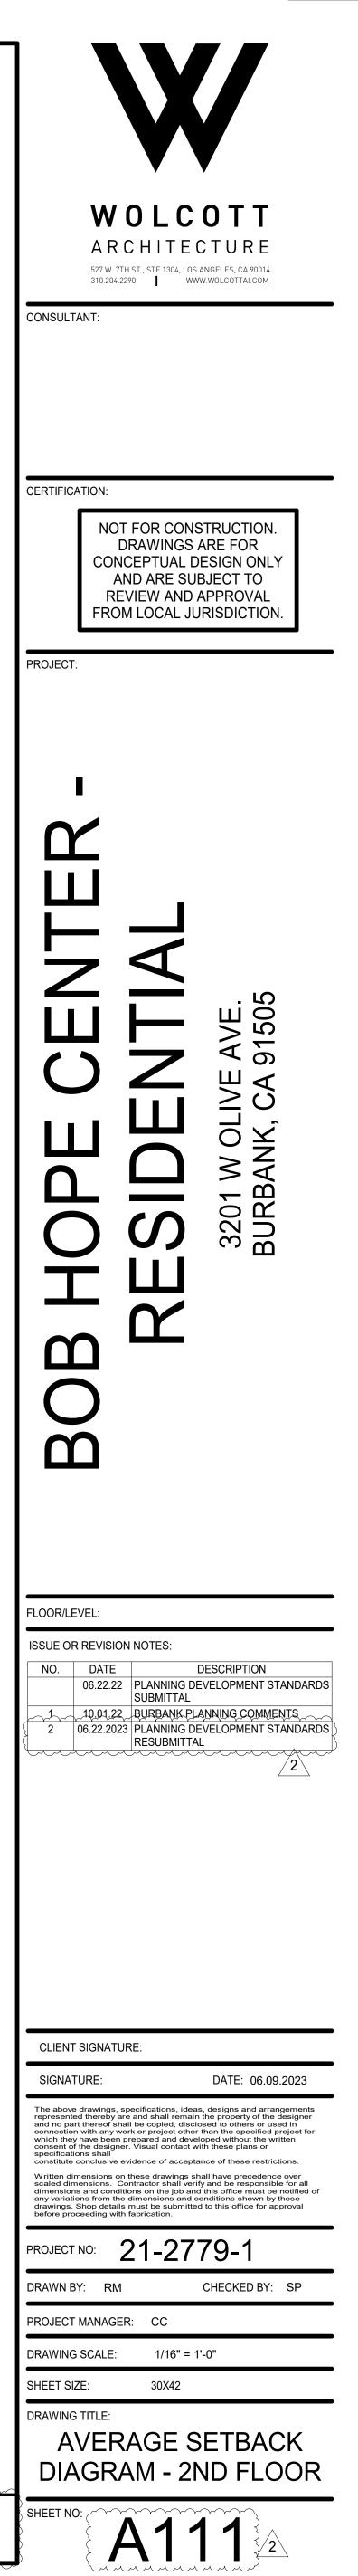


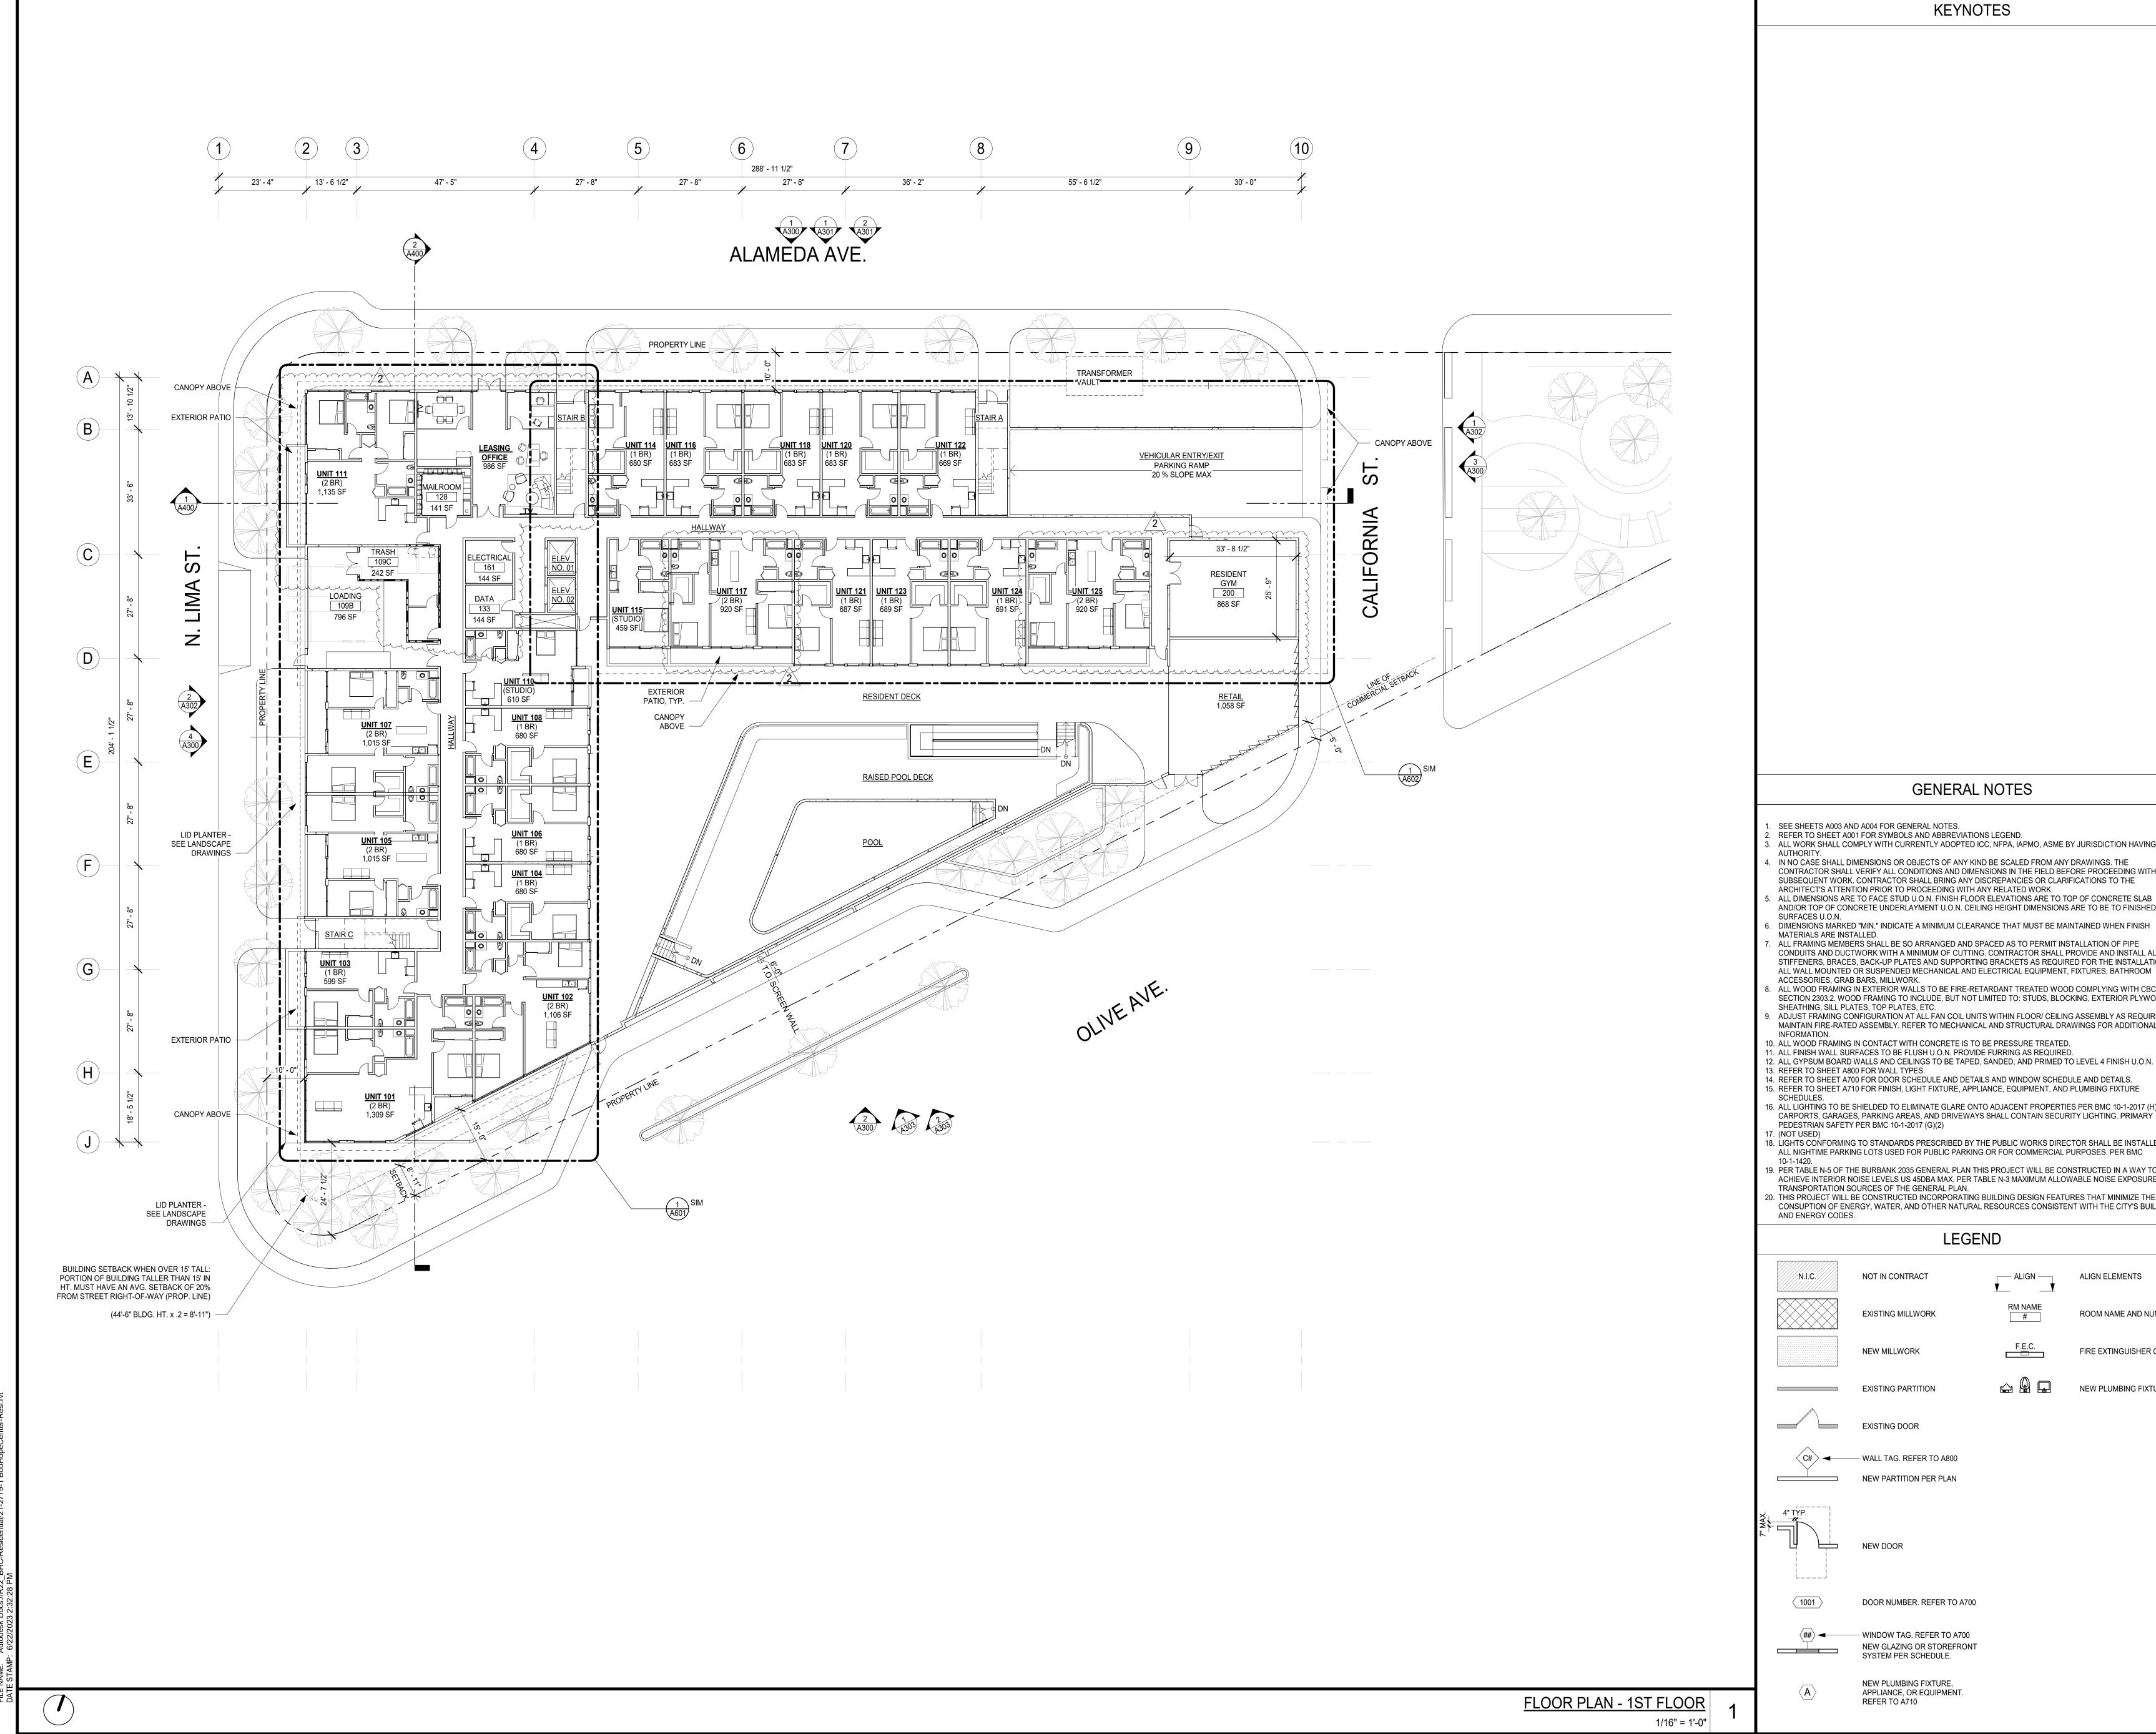


- ALL WORK SHALL COMPLY WITH CURRENTLY ADOPTED ICC, NFPA, IAPMO, ASME BY JURISDICTION HAVING IN NO CASE SHALL DIMENSIONS OR OBJECTS OF ANY KIND BE SCALED FROM ANY DRAWINGS. THE CONTRACTOR SHALL VERIFY ALL CONDITIONS AND DIMENSIONS IN THE FIELD BEFORE PROCEEDING WITH
- ARCHITECT'S ATTENTION PRIOR TO PROCEEDING WITH ANY RELATED WORK. ALL DIMENSIONS ARE TO FACE STUD U.O.N. FINISH FLOOR ELEVATIONS ARE TO TOP OF CONCRETE SLAB AND/OR TOP OF CONCRETE UNDERLAYMENT U.O.N. CEILING HEIGHT DIMENSIONS ARE TO BE TO FINISHED
- DIMENSIONS MARKED "MIN." INDICATE A MINIMUM CLEARANCE THAT MUST BE MAINTAINED WHEN FINISH ALL FRAMING MEMBERS SHALL BE SO ARRANGED AND SPACED AS TO PERMIT INSTALLATION OF PIPE CONDUITS AND DUCTWORK WITH A MINIMUM OF CUTTING. CONTRACTOR SHALL PROVIDE AND INSTALL ALL STIFFENERS, BRACES, BACK-UP PLATES AND SUPPORTING BRACKETS AS REQUIRED FOR THE INSTALLATION OF ALL WALL MOUNTED OR SUSPENDED MECHANICAL AND ELECTRICAL EQUIPMENT, FIXTURES, BATHROOM
- ALL WOOD FRAMING IN EXTERIOR WALLS TO BE FIRE-RETARDANT TREATED WOOD COMPLYING WITH CBC SECTION 2303.2. WOOD FRAMING TO INCLUDE, BUT NOT LIMITED TO: STUDS, BLOCKING, EXTERIOR PLYWOOD
- ADJUST FRAMING CONFIGURATION AT ALL FAN COIL UNITS WITHIN FLOOR/ CEILING ASSEMBLY AS REQUIRED TO MAINTAIN FIRE-RATED ASSEMBLY. REFER TO MECHANICAL AND STRUCTURAL DRAWINGS FOR ADDITIONAL
- 10. ALL WOOD FRAMING IN CONTACT WITH CONCRETE IS TO BE PRESSURE TREATED. 11. ALL FINISH WALL SURFACES TO BE FLUSH U.O.N. PROVIDE FURRING AS REQUIRED.
- 14. REFER TO SHEET A700 FOR DOOR SCHEDULE AND DETAILS AND WINDOW SCHEDULE AND DETAILS.
- 16. ALL LIGHTING TO BE SHIELDED TO ELIMINATE GLARE ONTO ADJACENT PROPERTIES PER BMC 10-1-2017 (H) (1)
- CARPORTS, GARAGES, PARKING AREAS, AND DRIVEWAYS SHALL CONTAIN SECURITY LIGHTING. PRIMARY 18. LIGHTS CONFORMING TO STANDARDS PRESCRIBED BY THE PUBLIC WORKS DIRECTOR SHALL BE INSTALLED IN
- ALL NIGHTIME PARKING LOTS USED FOR PUBLIC PARKING OR FOR COMMERCIAL PURPOSES. PER BMC 19. PER TABLE N-5 OF THE BURBANK 2035 GENERAL PLAN THIS PROJECT WILL BE CONSTRUCTED IN A WAY TO
- ACHIEVE INTERIOR NOISE LEVELS US 45DBA MAX. PER TABLE N-3 MAXIMUM ALLOWABLE NOISE EXPOSURE -20. THIS PROJECT WILL BE CONSTRUCTED INCORPORATING BUILDING DESIGN FEATURES THAT MINIMIZE THE CONSUPTION OF ENERGY, WATER, AND OTHER NATURAL RESOURCES CONSISTENT WITH THE CITY'S BUILDING


|                  | AND ENERGY CODES             | S.   |              |                         |  |
|------------------|------------------------------|--|--------------|-------------------------|--|
|                  | LEGEND                       |  |              |                         |  |
|                  | N.I.C.                       | NOT IN CONTRACT  | ALIGN —      | ALIGN ELEMENTS          |  |
|                  |                              | EXISTING MILLWORK  | RM NAME<br># | ROOM NAME AND NUMBER    |  |
|                  |                              | NEW MILLWORK   | F.E.C.       | FIRE EXTINGUISHER CABIN |  |
|                  |                              | EXISTING PARTITION   | <b>☆ </b>    | NEW PLUMBING FIXTURES   |  |
|                  |                              | EXISTING DOOR  |              |                         |  |
|                  | C# -                         | — WALL TAG. REFER TO A800  |              |                         |  |
|                  |                              | NEW PARTITION PER PLAN   |              |                         |  |
|                  | 4" TYP.                      | NEW DOOR   |              |                         |  |
|                  | < <u>1001</u> >              | DOOR NUMBER. REFER TO A700   |              |                         |  |
|                  |                              | — WINDOW TAG. REFER TO A700<br>NEW GLAZING OR STOREFRONT<br>SYSTEM PER SCHEDULE. |              |                         |  |
| AN - 1ST FLOOR 1 | $\langle \mathbf{A} \rangle$ | NEW PLUMBING FIXTURE,<br>APPLIANCE, OR EQUIPMENT.<br>REFER TO A710               |              |                         |  |

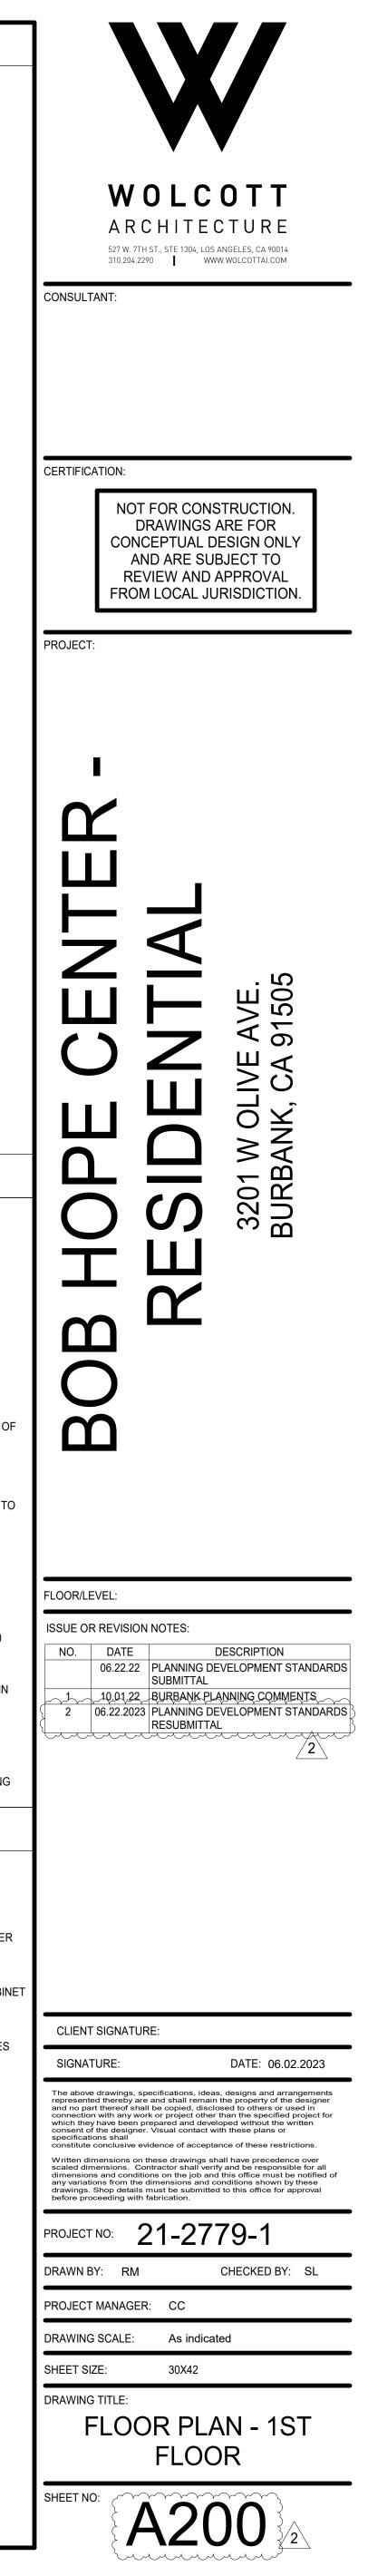

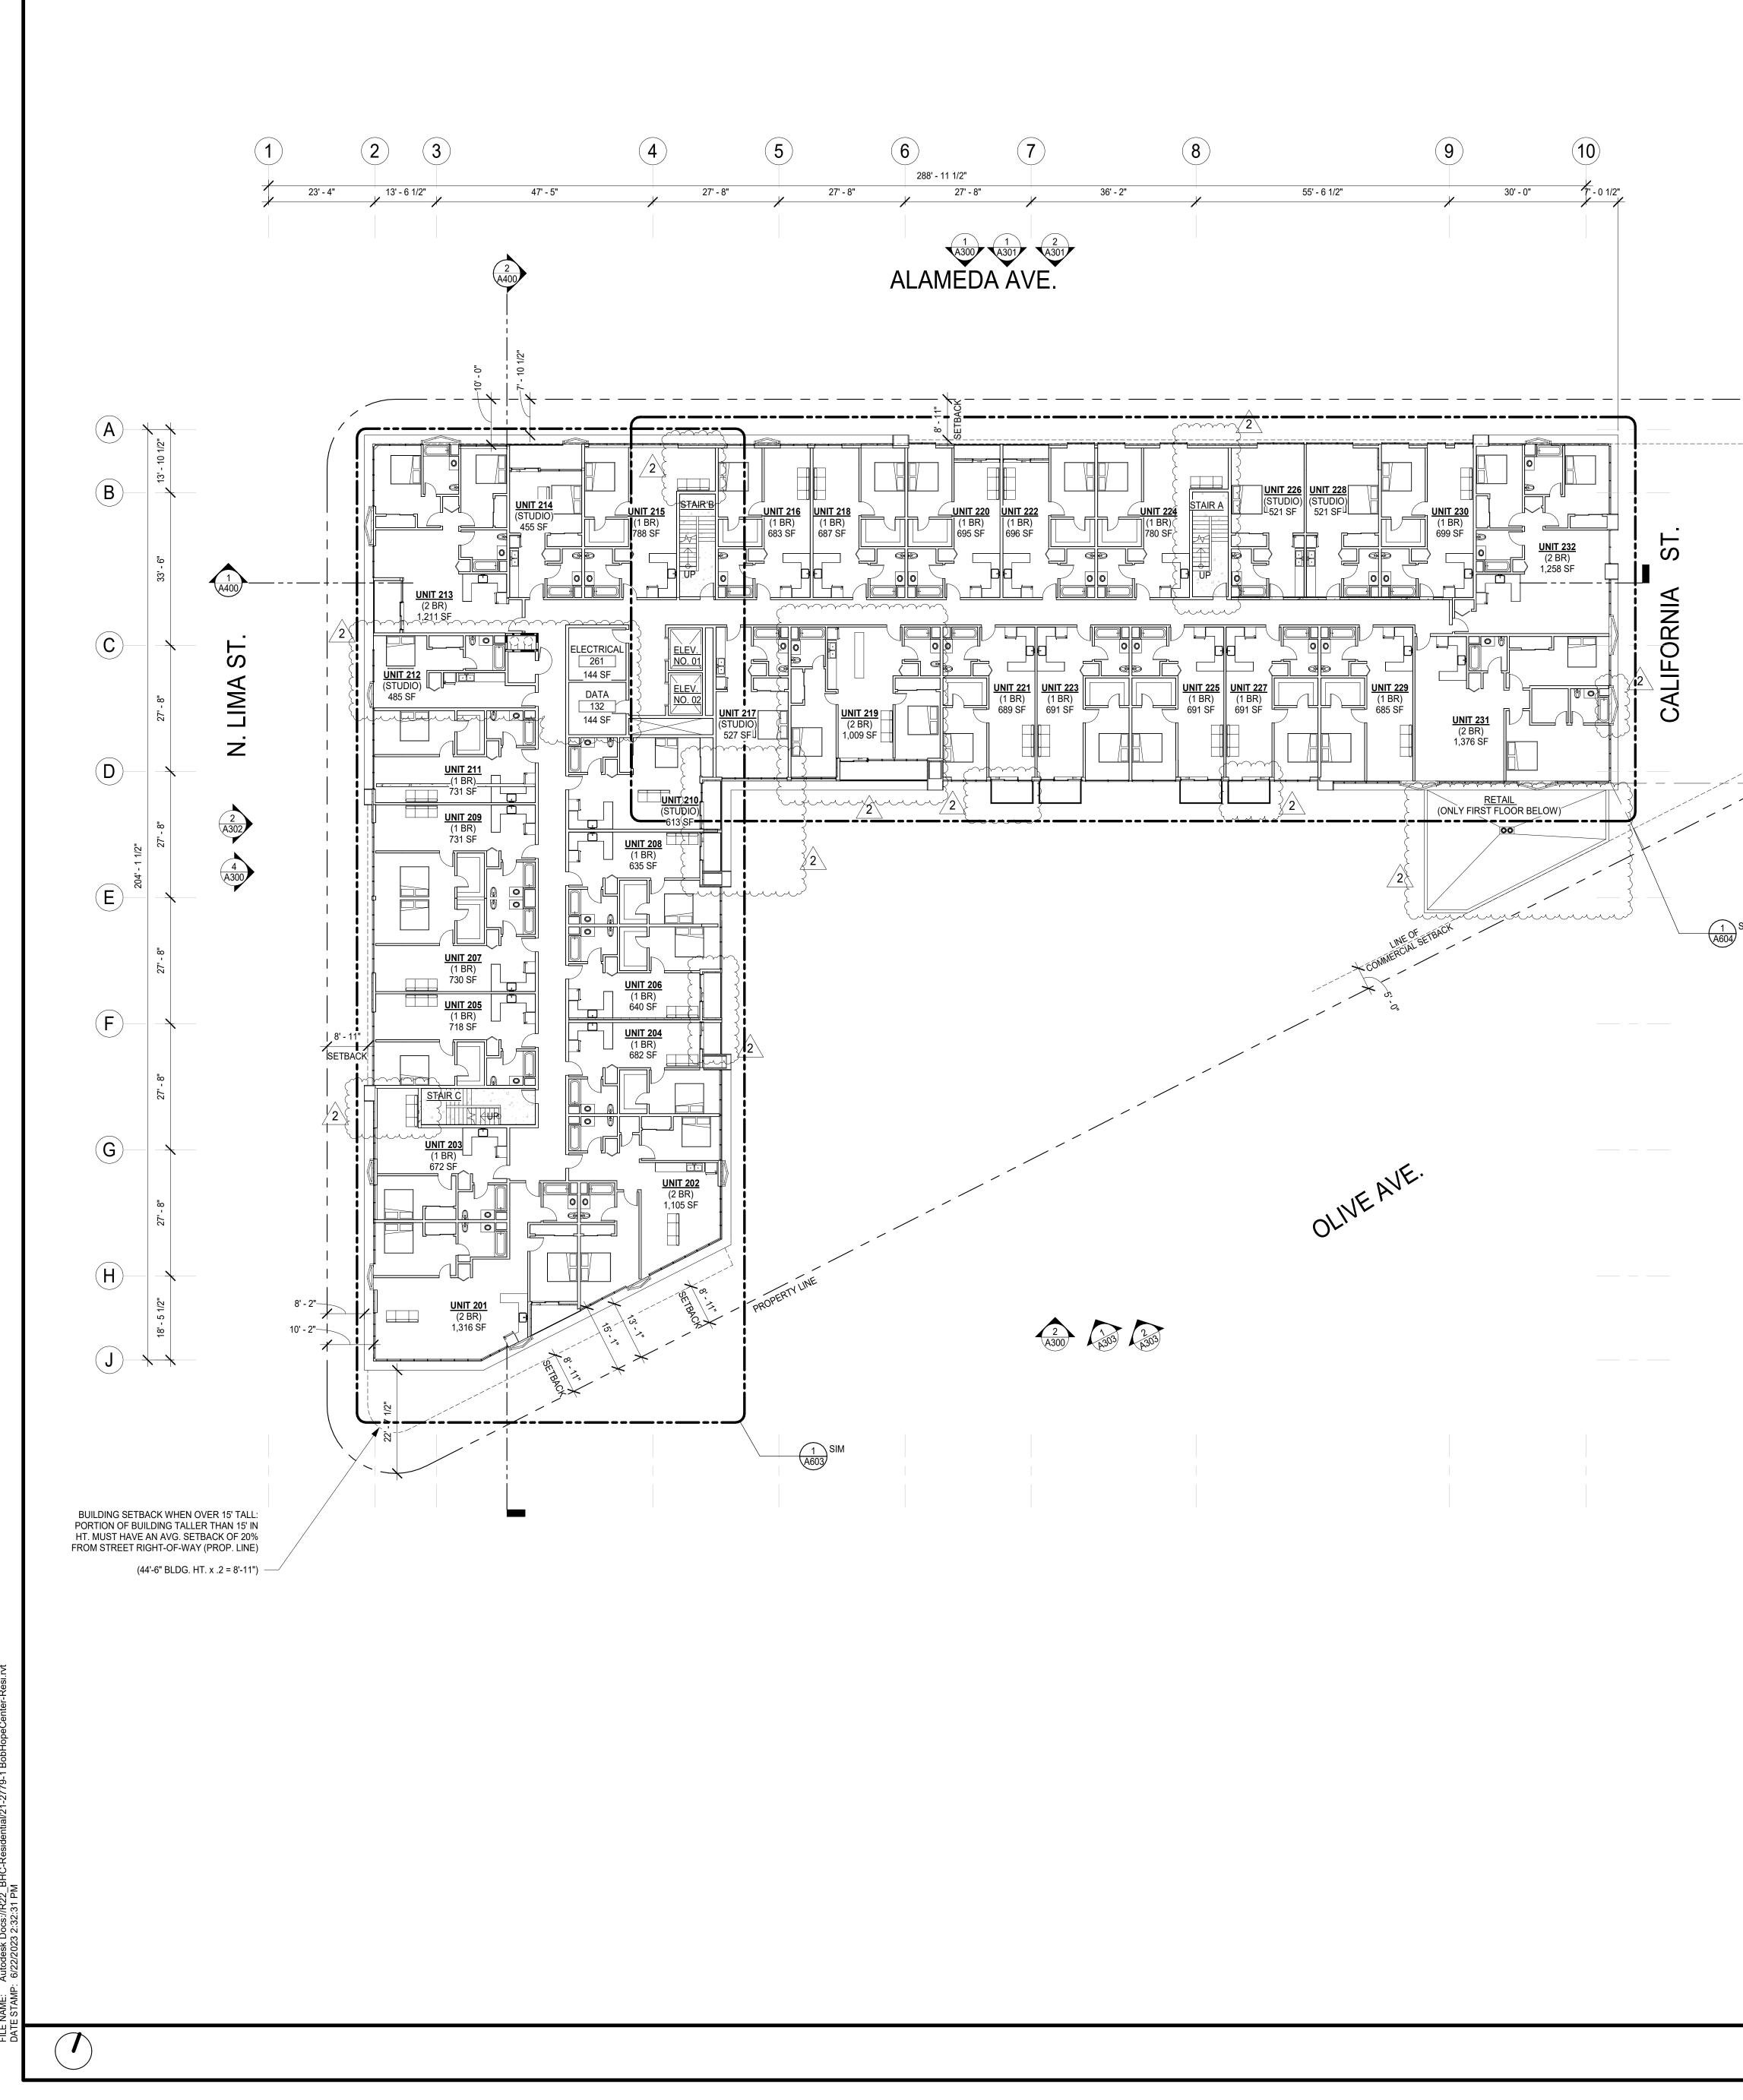



|   | KEYNOTES   |
|---|--|
|   |  |
|   |  |
|   |  |
|   |  |
| 1<br>(A302)<br>(3)<br>(A300)            |  |
|   |  |
|   |  |
| ∖ SIM                                   | GENERAL NOTES  |
|   | <ol> <li>SEE SHEETS A003 AND A004 FOR GENERAL NOTES.</li> <li>REFER TO SHEET A001 FOR SYMBOLS AND ABBREVIATIONS LEGEND.</li> <li>ALL WORK SHALL COMPLY WITH CURRENTLY ADOPTED ICC, NFPA, IAPMO, ASME BY JURISDICTION HAVING<br/>AUTHORITY.</li> <li>IN NO CASE SHALL DIMENSIONS OR OBJECTS OF ANY KIND BE SCALED FROM ANY DRAWINGS. THE<br/>CONTRACTOR SHALL VERIFY ALL CONDITIONS AND DIMENSIONS IN THE FIELD BEFORE PROCEEDING WITH<br/>SUBSEQUENT WORK. CONTRACTOR SHALL BRING ANY DISCREPADICIES OR CLARIFICATIONS TO THE<br/>ARCHITECTS ATTENTION PRIOR TO PROCEEDING WITH ANY RELATED WORK.</li> <li>ALL DIMENSIONS ARE TO FACE STUD U.O.N. FINISH FLOOR ELEVATIONS ARE TO TOP OF CONCRETE SLAB<br/>AND/OR TOP OF CONCRETE UNDERLAYMENT U.O.N. CEILING HEIGHT DIMENSIONS ARE TO BE TO FINISHED<br/>SURFACES U.O.N.</li> <li>DIMENSIONS MARKED "MIN." INDICATE A MINIMUM CLEARANCE THAT MUST BE MAINTAINED WHEN FINISH<br/>MATERIALS ARE INSTALLED.</li> <li>ALL FRAMING MEMBERS SHALL BE SO ARRANGED AND SPACED AS TO PERMIT INSTALLATION OF PIPE<br/>CONDUITS AND DUCTWORK WITH A MINIMUM OF CUTTING. CONTRACTOR SHALL PROVIDE AND INSTALL ALL<br/>STIFFENERS, BRACES, BACK-UP PLATES AND SUPPORTING BRACKETS AS REQUIRED FOR THE INSTALLATION C<br/>ALL WALL MOUNTED OR SUSPENDED MECHANICAL AND ELECTRICAL EQUIPMENT, FIXTURES, BATHROOM<br/>ACCESSORIES, GRAB BARS, MILLWORK.</li> <li>ALL WOOD FRAMING IN EXTERIOR WALLS TO BE FIRE-RETARDANT TREATED WOOD COMPLYING WITH CBC<br/>SECTION 2303.2. WOOD FRAMING TO INCLUDE, BUT NOT LIMITED TO: STUDS, BLOCKING, EXTERIOR PLYWOOD<br/>SHEATHING, SILL PLATES, TOP PLATES, ETC.</li> <li>ADJUST FRAMING CONFIGURATION AT ALL FAN COIL UNITS WITHIN FLOOR/ CEILING ASSEMBLY AS REQUIRED T<br/>MAINTAIN FIRE-RATED ASSEMBLY. REFER TO MECHANICAL AND STRUCTURAL DRAWINGS FOR ADDITIONAL<br/>INFORMATION.</li> <li>ALL WOOD FRAMING IN CONTACT WITH CONCRETE IS TO BE PRESSURE TREATED.</li> <li>ALL WOOD FRAMING IN CONTACT WITH CONCRETE IS TO BE PRESSURE TREATED.</li> <li>ALL WOOD FRAMING IN CONTACT WITH CONCRETE IS TO BE PRESSURE TREATED.</li> <li>ALL WOOD FRAMING IN</li></ol> |
|   | <ul> <li>SCHEDULES.</li> <li>16. ALL LIGHTING TO BE SHIELDED TO ELIMINATE GLARE ONTO ADJACENT PROPERTIES PER BMC 10-1-2017 (H) (1)<br/>CARPORTS, GARAGES, PARKING AREAS, AND DRIVEWAYS SHALL CONTAIN SECURITY LIGHTING. PRIMARY<br/>PEDESTRIAN SAFETY PER BMC 10-1-2017 (G)(2)</li> <li>17. (NOT USED)</li> <li>18. LIGHTS CONFORMING TO STANDARDS PRESCRIBED BY THE PUBLIC WORKS DIRECTOR SHALL BE INSTALLED IN<br/>ALL NIGHTIME PARKING LOTS USED FOR PUBLIC PARKING OR FOR COMMERCIAL PURPOSES. PER BMC<br/>10-1-1420.</li> <li>19. PER TABLE N-5 OF THE BURBANK 2035 GENERAL PLAN THIS PROJECT WILL BE CONSTRUCTED IN A WAY TO<br/>ACHIEVE INTERIOR NOISE LEVELS US 45DBA MAX. PER TABLE N-3 MAXIMUM ALLOWABLE NOISE EXPOSURE -<br/>TRANSPORTATION SOURCES OF THE GENERAL PLAN.</li> <li>20. THIS PROJECT WILL BE CONSTRUCTED INCORPORATING BUILDING DESIGN FEATURES THAT MINIMIZE THE<br/>CONSUPTION OF ENERGY, WATER, AND OTHER NATURAL RESOURCES CONSISTENT WITH THE CITY'S BUILDING<br/>AND ENERGY CODES.</li> </ul>   |
|   | LEGEND   |
|   | N.I.C. NOT IN CONTRACT   |
|   | EXISTING MILLWORK RM NAME<br># ROOM NAME AND NUMBER  |
|   |  |
|   | EXISTING PARTITION   |
|   | EXISTING DOOR<br>C# WALL TAG. REFER TO A800<br>NEW PARTITION PER PLAN  |
|   | 4" TYP.<br>NEW DOOR  |
|   | (1001) DOOR NUMBER. REFER TO A700  |
|   | WINDOW TAG. REFER TO A700<br>NEW GLAZING OR STOREFRONT<br>SYSTEM PER SCHEDULE.   |
| FLOOR PLAN - 2ND FLOOR<br>1/16" = 1'-0" | A NEW PLUMBING FIXTURE,<br>APPLIANCE, OR EQUIPMENT.<br>REFER TO A710   |

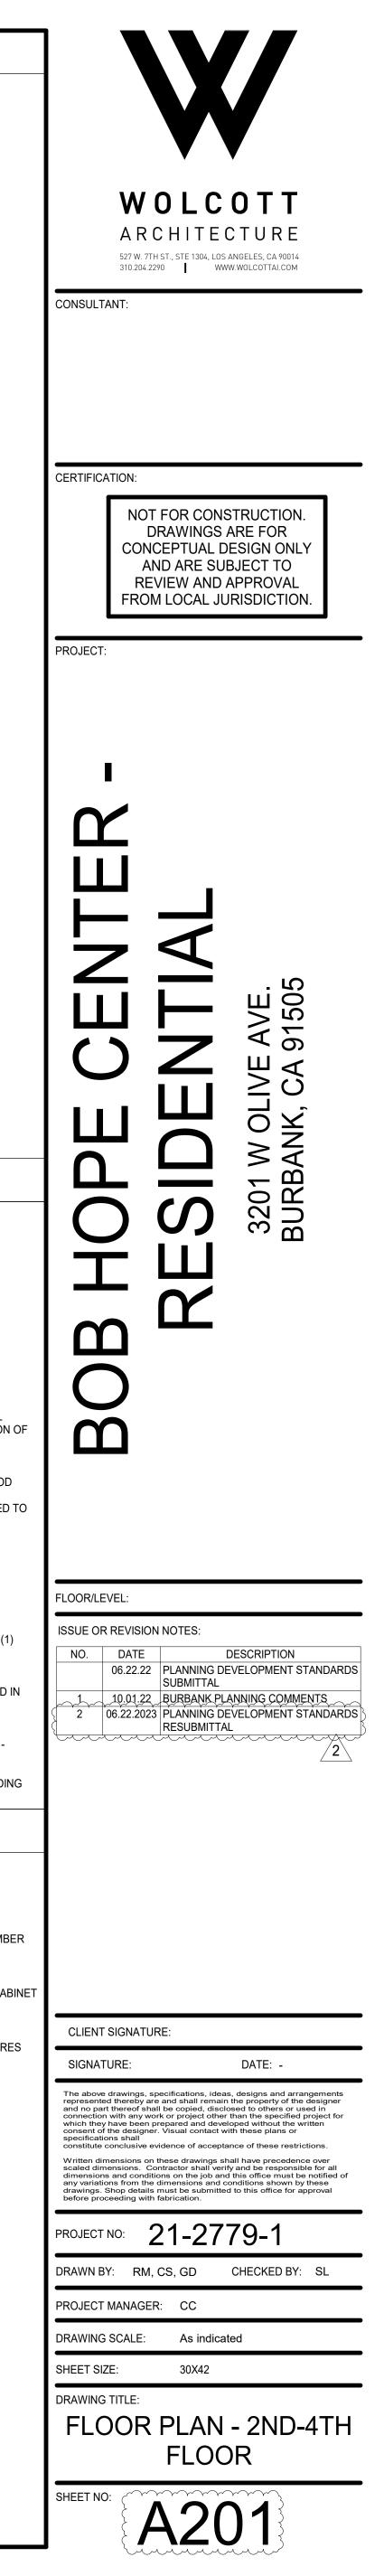

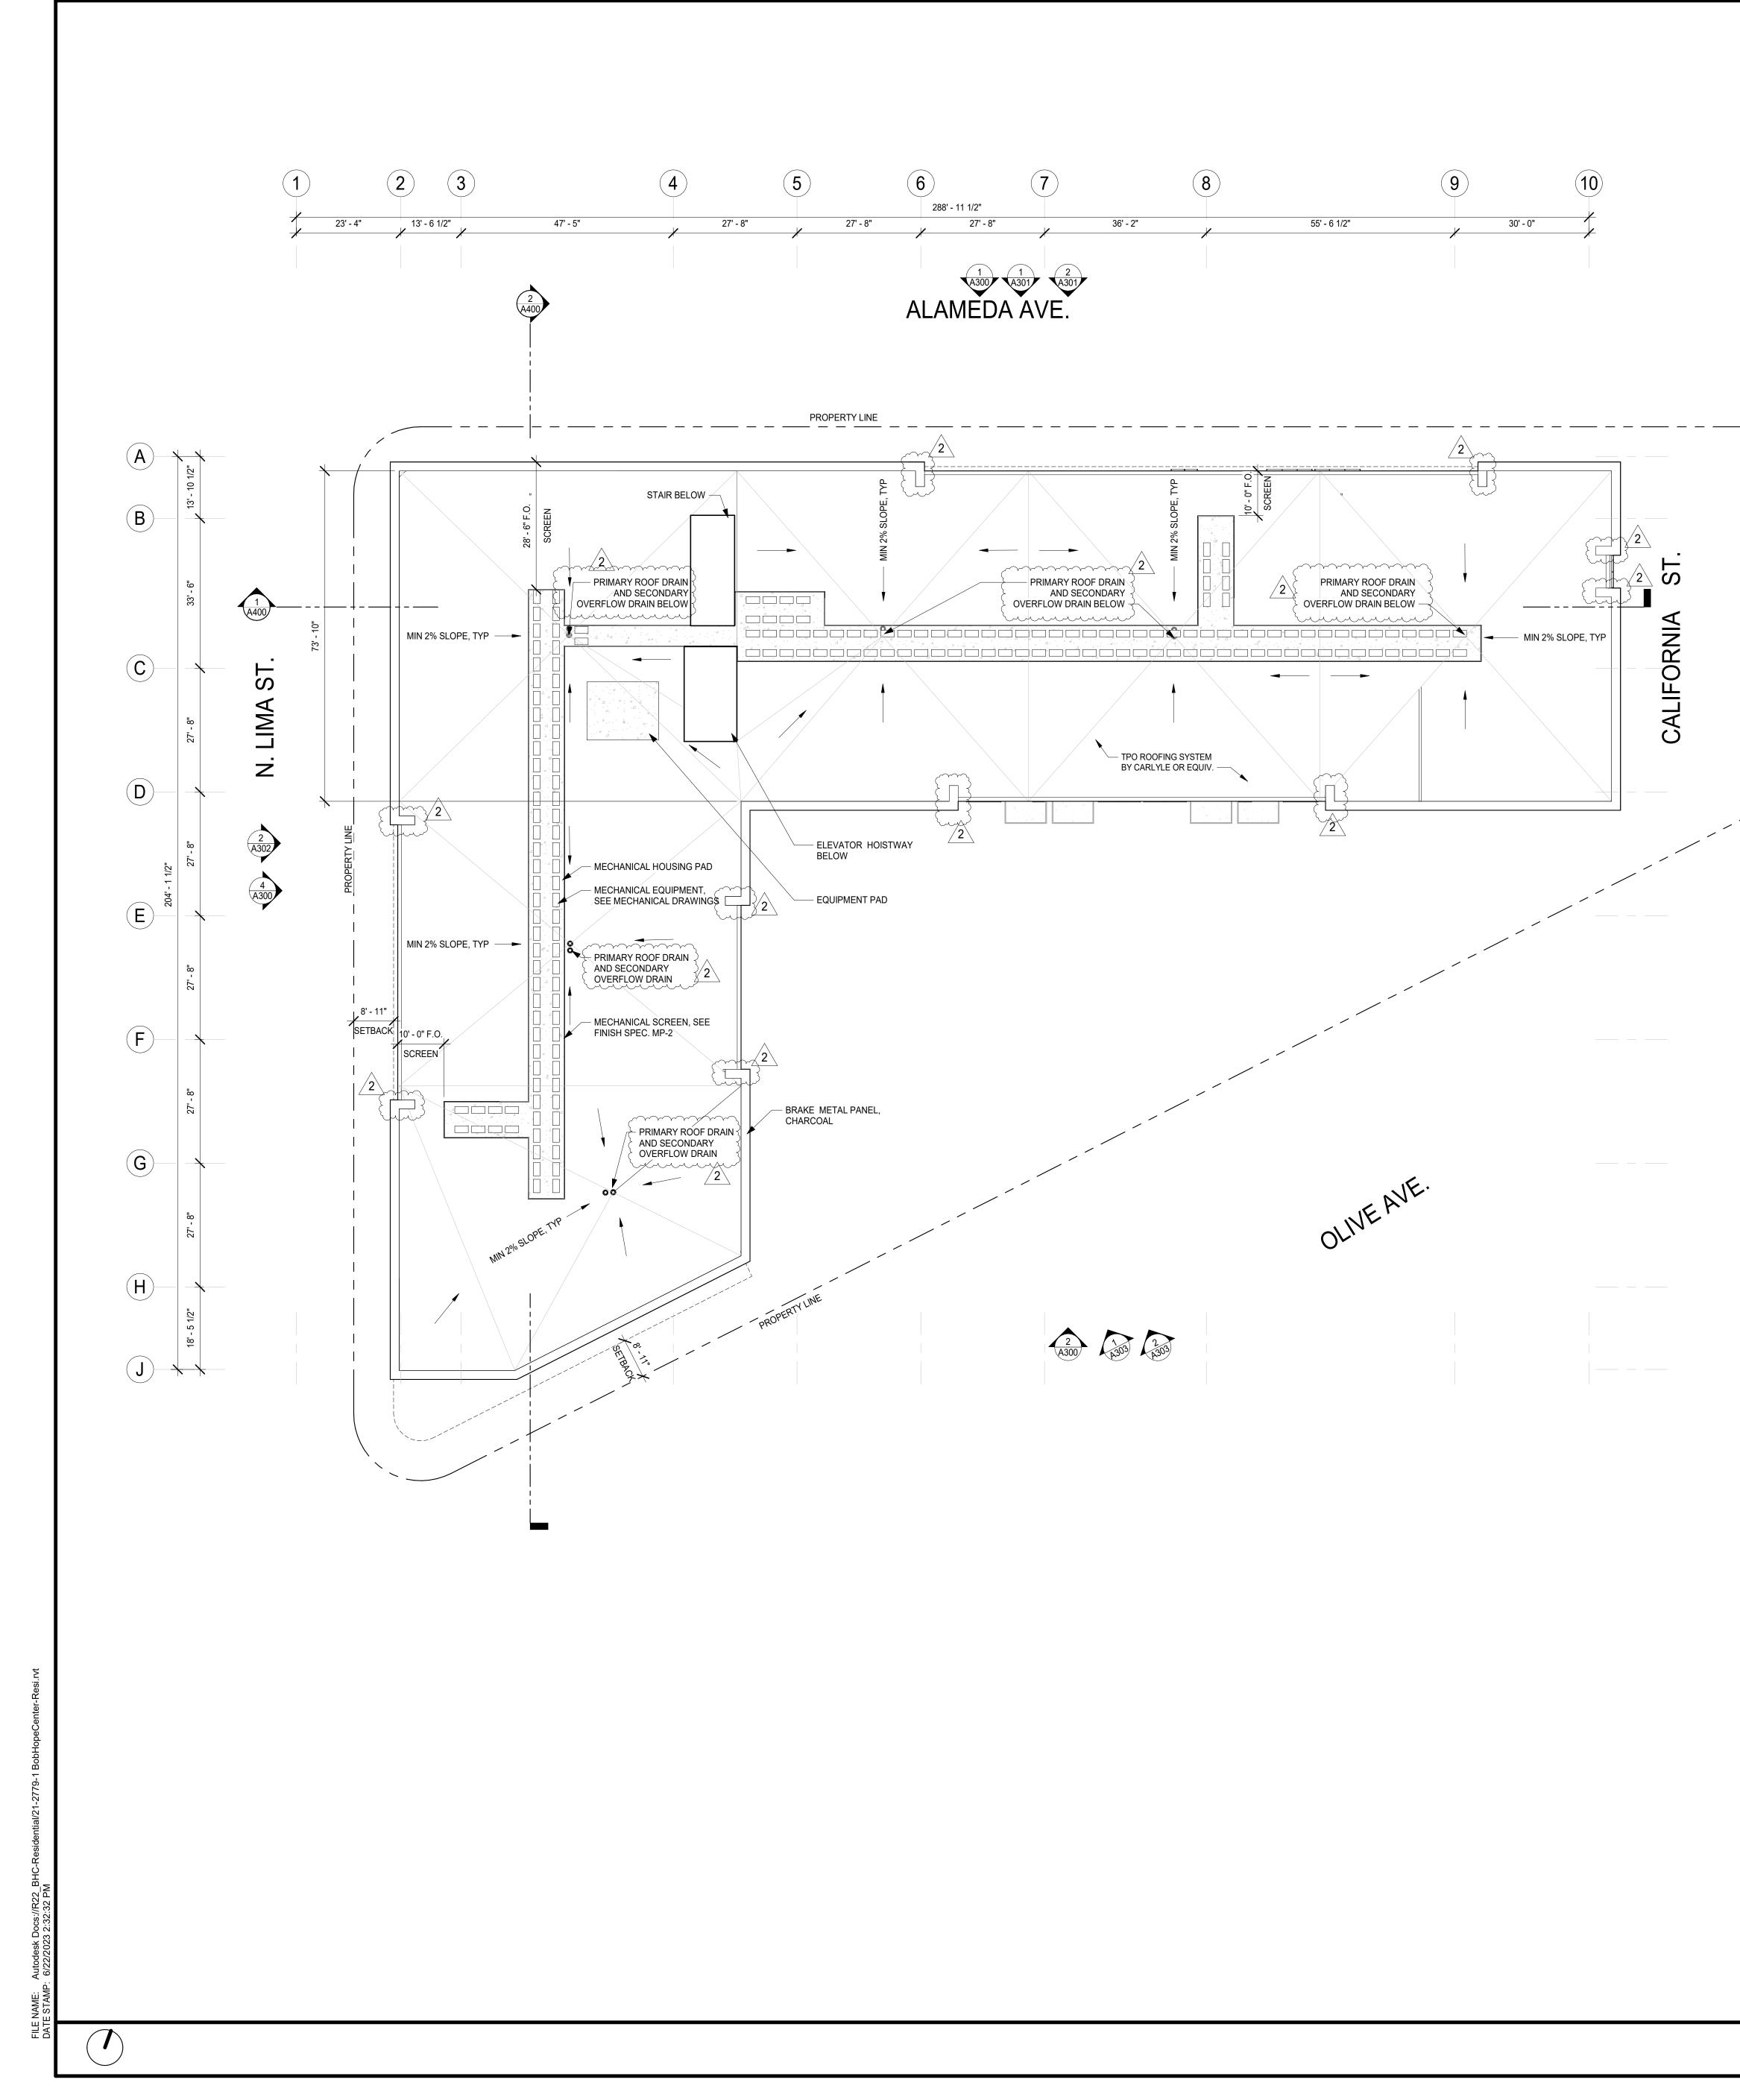


|                                   | KEYNOTES  |
|-----------------------------------|---|
|                                   |   |
|                                   |   |
| 1<br>(A302)                       |   |
|                                   |   |
| 3<br>A300                         |   |
|                                   |   |
|                                   |   |
|                                   | 1. SEE SHEETS A003 AND A004 FOR GENERAL NOTES.  |
|                                   | <ol> <li>PROVIDE NEW UL CLASS 'A' ROOF THROUGHOUT ENTIRE ROOF AREA, UP AND AROUND ALL WALL, PARAPETS<br/>CRICKETS, MECHANICAL PLATFORMS AND VENTS.</li> <li>ROOFING SPECIFICATIONS: ROOFING MEMBRANE AND INSULATION BY GAF, PROVIDE GAF MECHANICALLY</li> </ol>   |
|                                   | <ul> <li>ATTACHED SINGLE-PLY EVERGUARD TPO 80 MIL ROOFING MEMBRANE.SYSTEM (UL1306) WITH 2 LAYERS OF 2. POLYISO INSULATION (DO NOT EXCEED 3" THICK INSULATION) FOR A MINIMUM R-30 R VALUE.</li> <li>PROVIDE GAF ROOFING ACCESSORIES INCLUDING; VENTS BOOTS, SQUARE TUBE WRAP, 36" CORNER CURB WRAP, INSIDE CORNER, DETAILING MEMBRANE, FLASHING STRIP, SEALER POCKET AND TPO COATED METAL</li> </ul> |
|                                   | <ul> <li>DRAINS .</li> <li>5. INSTALL ALL ROOFING ACCESSORIES AND ROOFING SYSTEM PER MANUFACTURER'S REQUIREMENTS. PROVI<br/>NEW ROOF WITH MINIMUM 2% SLOPE TO DRAINS.</li> </ul>  |
|                                   | <ol> <li>SEE SHEET AXXX FOR ROOF PENETRATION DETAILS</li> <li>ALL LIGHTING TO BE SHIELDED TO ELIMINATE GLARE ONTO ADJACENT PROPERTIES PER BMC 10-1-2017 (H) (1)</li> <li>CARPORTS, GARAGES, PARKING AREAS, AND DRIVEWAYS SHALL CONTAIN SECURITY LIGHTING. PRIMARY<br/>PEDESTRIAN SAFETY PER BMC 10-1-2017 (G)(2)</li> </ol>   |
|                                   | <ul> <li>PEDESTRIAN SAFETY PER BMC 10-1-2017 (G)(2)</li> <li>9. LIGHTS CONFORMING TO STANDARDS PRESCRIBED BY THE PUBLIC WORKS DIRECTOR SHALL BE INSTALLED<br/>ALL NIGHTIME PARKING LOTS USED FOR PUBLIC PARKING OR FOR COMMERCIAL PURPOSES. PER BMC<br/>10-1-1420.</li> </ul>   |
|                                   | <ol> <li>PER TABLE N-5 OF THE BURBANK 2035 GENERAL PLAN THIS PROJECT WILL BE CONSTRUCTED IN A WAY TO<br/>ACHIEVE INTERIOR NOISE LEVELS US 45DBA MAX. PER TABLE N-3 MAXIMUM ALLOWABLE NOISE EXPOSURE -<br/>TRANSPORTATION SOURCES OF THE GENERAL PLAN.</li> <li>THIS PROJECT WILL BE CONSTRUCTED INCORPORATING BUILDING DESIGN FEATURES THAT MINIMIZE THE</li> </ol>                                 |
|                                   | CONSUPTION OF ENERGY, WATER, AND OTHER NATURAL RESOURCES CONSISTENT WITH THE CITY'S BUILDIN<br>AND ENERGY CODES.  |
|                                   | LEGEND  |
|                                   | N.I.C. NOT IN CONTRACT  |
|                                   |   |
|                                   |   |
|                                   | ROOF CRICKET  |
|                                   | - SLOPE 1:12 ROOF SLOPE   |
|                                   | ROOF HATCH  |
|                                   | WALK PAD  |
|                                   | ALIGN — ALIGN ELEMENTS  |
|                                   | <u>¥                                    </u>  |
|                                   | PARAPET. WALL TYPE TO MATCH BELOW   |
|                                   |   |
|                                   |   |
|                                   |   |
|                                   |   |
| <u>ROOF PLAN</u><br>1/16" = 1'-0" | 1   |
|                                   |   |

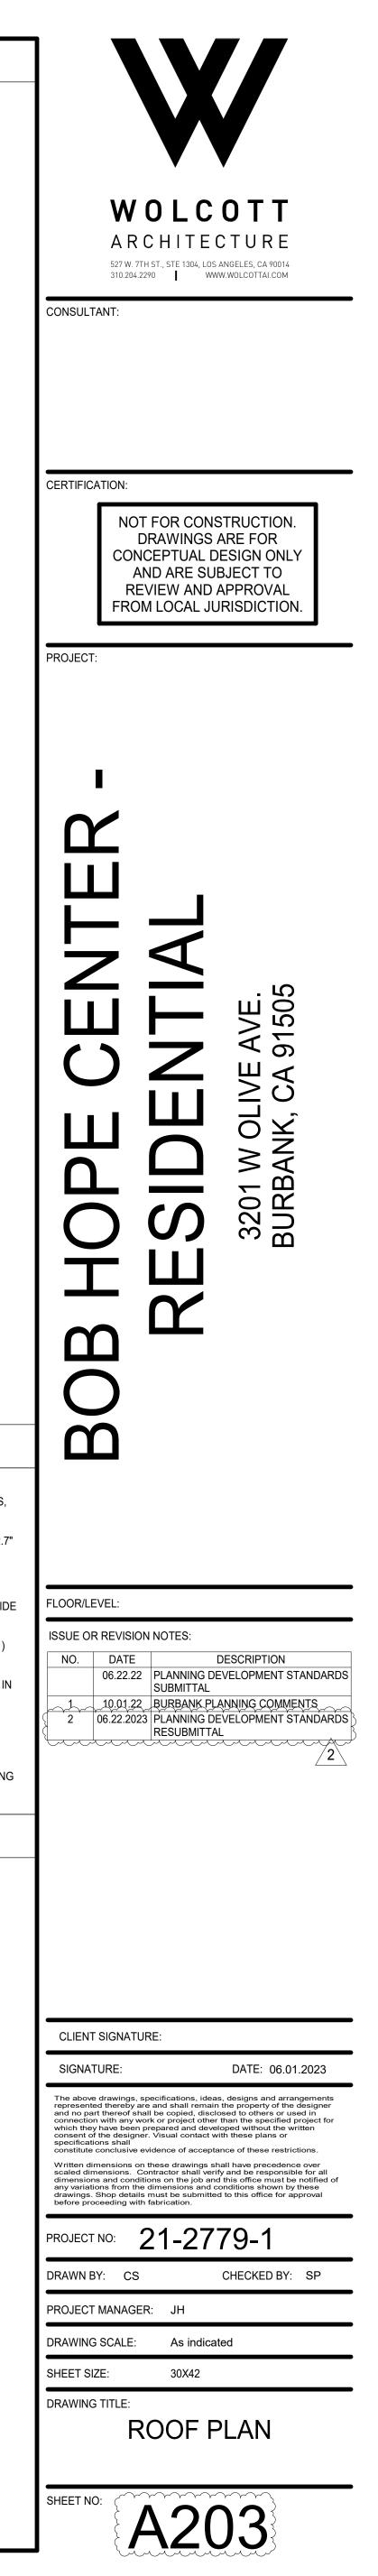


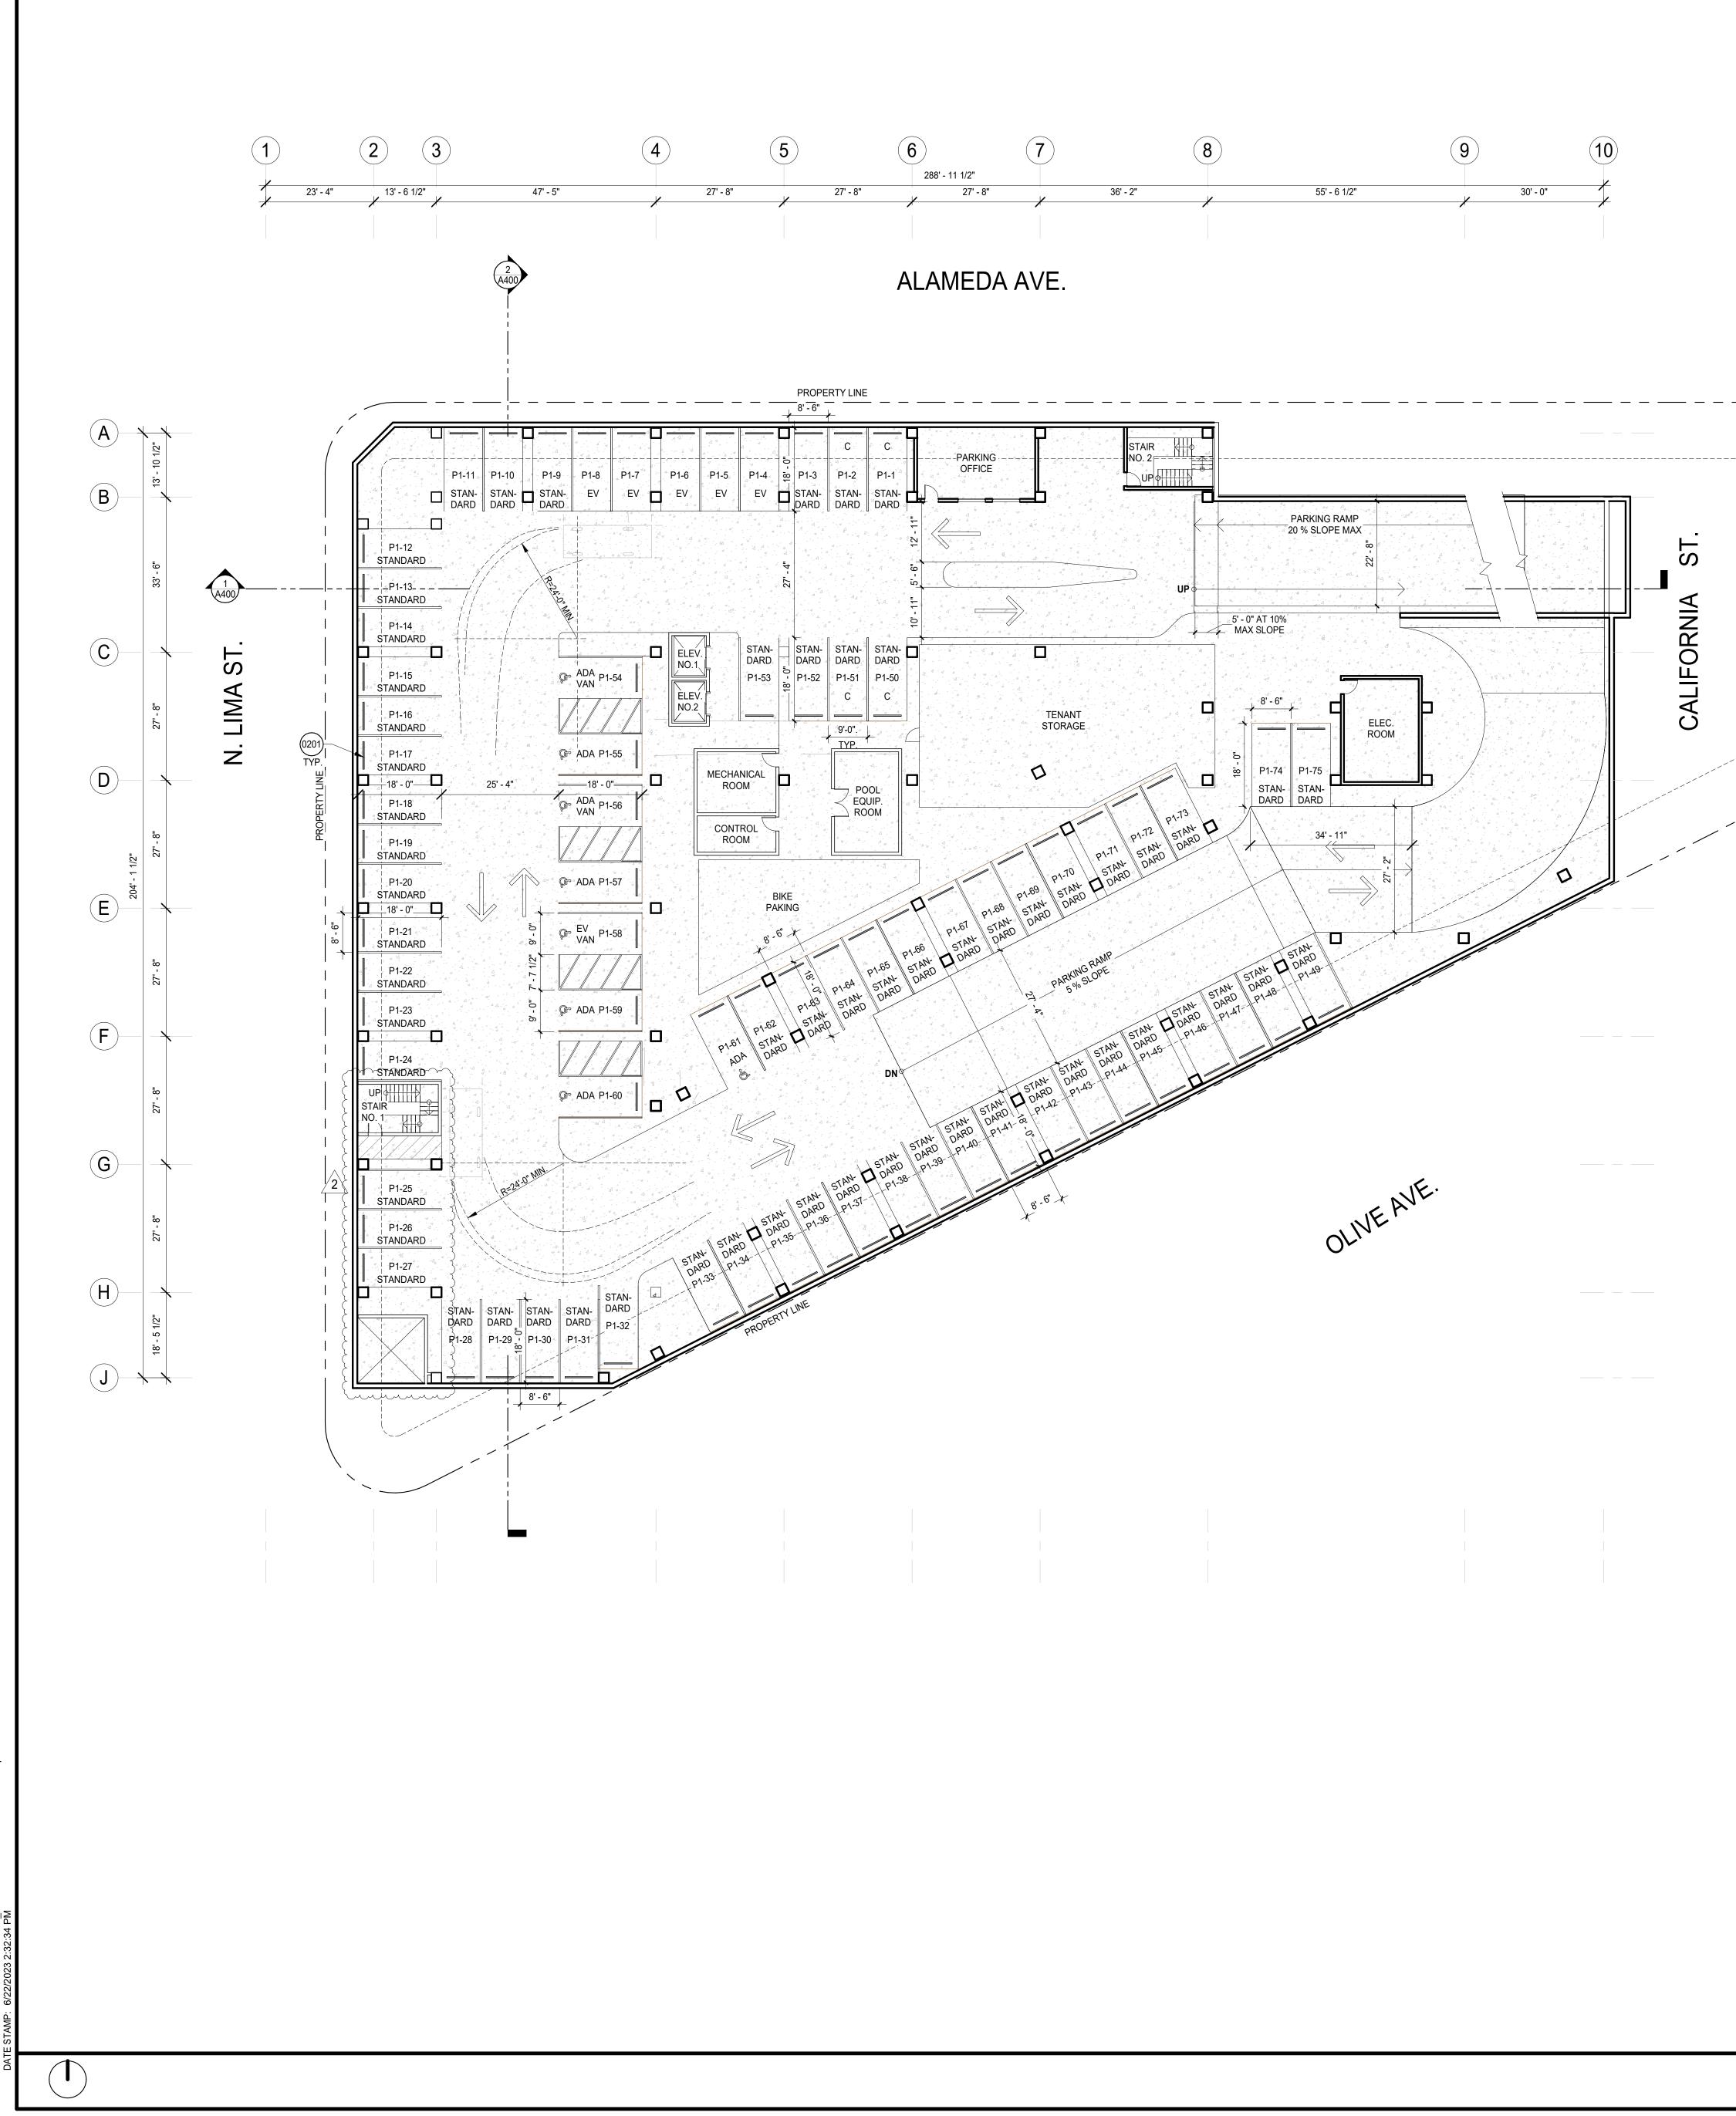

|                  | 0201 WHEELSTOP, TY                             | P. AT ALL STALLS.  |                        |                             |
|------------------|--|--|------------------------|-----------------------------|
|                  |  |  |                        |                             |
|                  |  |  |                        |                             |
|                  |  | GENERAL  | NOTES                  |                             |
|                  |  | ND A004 FOR GENERAL NOTES.   |                        |                             |
|                  |  | 001 FOR SYMBOLS AND ABBREVIATION<br>OMPLY WITH CURRENTLY ADOPTED IO                                      |                        | BY JURISDICTION HAVING      |
|                  | CONTRACTOR SHAL                                | DIMENSIONS OR OBJECTS OF ANY KIN<br>L VERIFY ALL CONDITIONS AND DIMEI<br>K. CONTRACTOR SHALL BRING ANY D | NSIONS IN THE FIELD BE | FORE PROCEEDING WITH        |
|                  | 5. ALL DIMENSIONS AR                           | ITION PRIOR TO PROCEEDING WITH A<br>E TO FACE STUD U.O.N. FINISH FLOO<br>NCRETE UNDERLAYMENT U.O.N. CEIL | R ELEVATIONS ARE TO T  |                             |
|                  | SURFACES U.O.N.                                | ED "MIN." INDICATE A MINIMUM CLEAR.  |                        |                             |
|                  | 7. ALL FRAMING MEMB<br>CONDUITS AND DUC        | ERS SHALL BE SO ARRANGED AND SI<br>TWORK WITH A MINIMUM OF CUTTING<br>ES, BACK-UP PLATES AND SUPPORTIN   | G. CONTRACTOR SHALL    | PROVIDE AND INSTALL ALL     |
|                  | ALL WALL MOUNTED<br>ACCESSORIES, GRA           | OR SUSPENDED MECHANICAL AND E  | ELECTRICAL EQUIPMEN    | I, FIXTURES, BATHROOM       |
|                  | SECTION 2303.2. WO<br>SHEATHING, SILL PL/      | OD FRAMING TO INCLUDE, BUT NOT L<br>ATES, TOP PLATES, ETC.<br>ONFIGURATION AT ALL FAN COIL UNIT          | IMITED TO: STUDS, BLO  | CKING, EXTERIOR PLYWOOD     |
|                  | MAINTAIN FIRE-RATE                             | ED ASSEMBLY. REFER TO MECHANICA  | AL AND STRUCTURAL DF   | AWINGS FOR ADDITIONAL       |
|                  | 11. ALL FINISH WALL SU                         | RFACES TO BE FLUSH U.O.N. PROVID<br>WALLS AND CEILINGS TO BE TAPED,                                      | E FURRING AS REQUIRE   | ED.                         |
|                  | 14. REFER TO SHEET A7<br>15. REFER TO SHEET A7 | 700 FOR WALL TYPES.<br>700 FOR DOOR SCHEDULE AND DETAI<br>710 FOR FINISH, LIGHT FIXTURE, APPL            |                        |                             |
|                  | CARPORTS, GARAGE                               | SHIELDED TO ELIMINATE GLARE ONT<br>ES, PARKING AREAS, AND DRIVEWAYS                                      |                        |                             |
|                  | 17. (NOT USED)<br>18. LIGHTS CONFORMIN         | Y PER BMC 10-1-2017 (G)(2)<br>IG TO STANDARDS PRESCRIBED BY T  |                        |                             |
|                  | 10-1-1420.<br>19. PER TABLE N-5 OF TI          | ING LOTS USED FOR PUBLIC PARKING   | IIS PROJECT WILL BE CO | DNSTRUCTED IN A WAY TO      |
|                  | TRANSPORTATION S<br>20. THIS PROJECT WILL      | NOISE LEVELS US 45DBA MAX. PER TA<br>SOURCES OF THE GENERAL PLAN.<br>BE CONSTRUCTED INCORPORATING        | BUILDING DESIGN FEAT   | URES THAT MINIMIZE THE      |
|                  | CONSUPTION OF EN<br>AND ENERGY CODES           | ERGY, WATER, AND OTHER NATURAL<br>S.   | . RESOURCES CONSISTI   | ENT WITH THE CITY'S BUILDIN |
|                  |  | LEGE   | ND                     |                             |
|                  | N.I.C.   | NOT IN CONTRACT  | ALIGN —                | ALIGN ELEMENTS              |
|                  |  |  | ♥♥<br>RM NAME          |                             |
|                  |  | EXISTING MILLWORK  | #                      | ROOM NAME AND NUMBE         |
|                  |  | NEW MILLWORK   | F.E.C.                 | FIRE EXTINGUISHER CAB       |
|                  |  | EXISTING PARTITION   |                        | NEW PLUMBING FIXTURE        |
|                  |  |  |                        |                             |
|                  |  | EXISTING DOOR  |                        |                             |
|                  | C#   | — WALL TAG. REFER TO A800  |                        |                             |
|                  |  | NEW PARTITION PER PLAN   |                        |                             |
|                  | 4" TYP.  |  |                        |                             |
|                  |  | NEW DOOR   |                        |                             |
|                  |  |  |                        |                             |
|                  |  |  |                        |                             |
|                  | <u>&lt; 1001</u> >                             | DOOR NUMBER. REFER TO A700   |                        |                             |
|                  |  |  |                        |                             |
|                  |  | SYSTEM PER SCHEDULE.   |                        |                             |
| FLOOR PLAN - P-1 | $\langle A \rangle$                            | NEW PLUMBING FIXTURE,<br>APPLIANCE, OR EQUIPMENT.<br>REFER TO A710                                       |                        |                             |
| <u> </u>         |  |  |                        |                             |
|                  |  |  |                        |                             |
|                  |  |  |                        |                             |


KEYNOTES

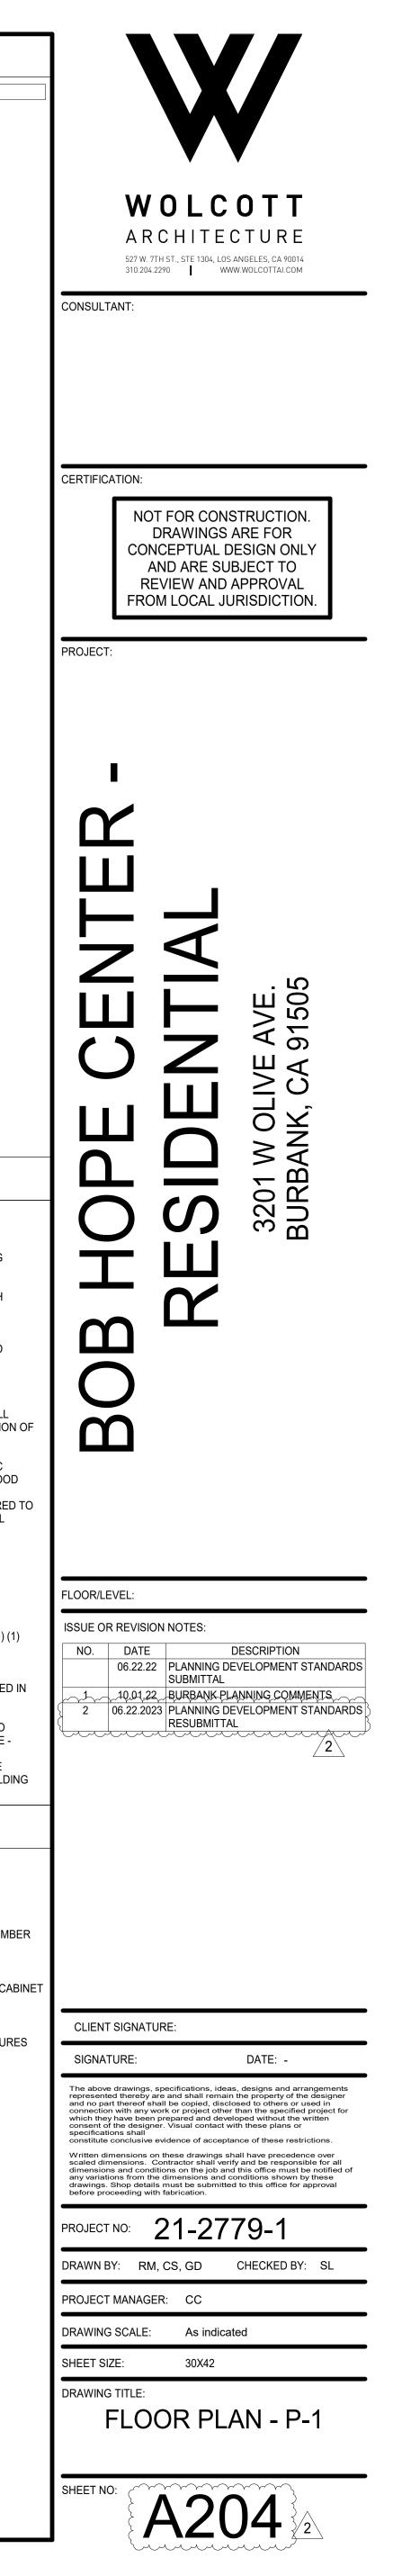


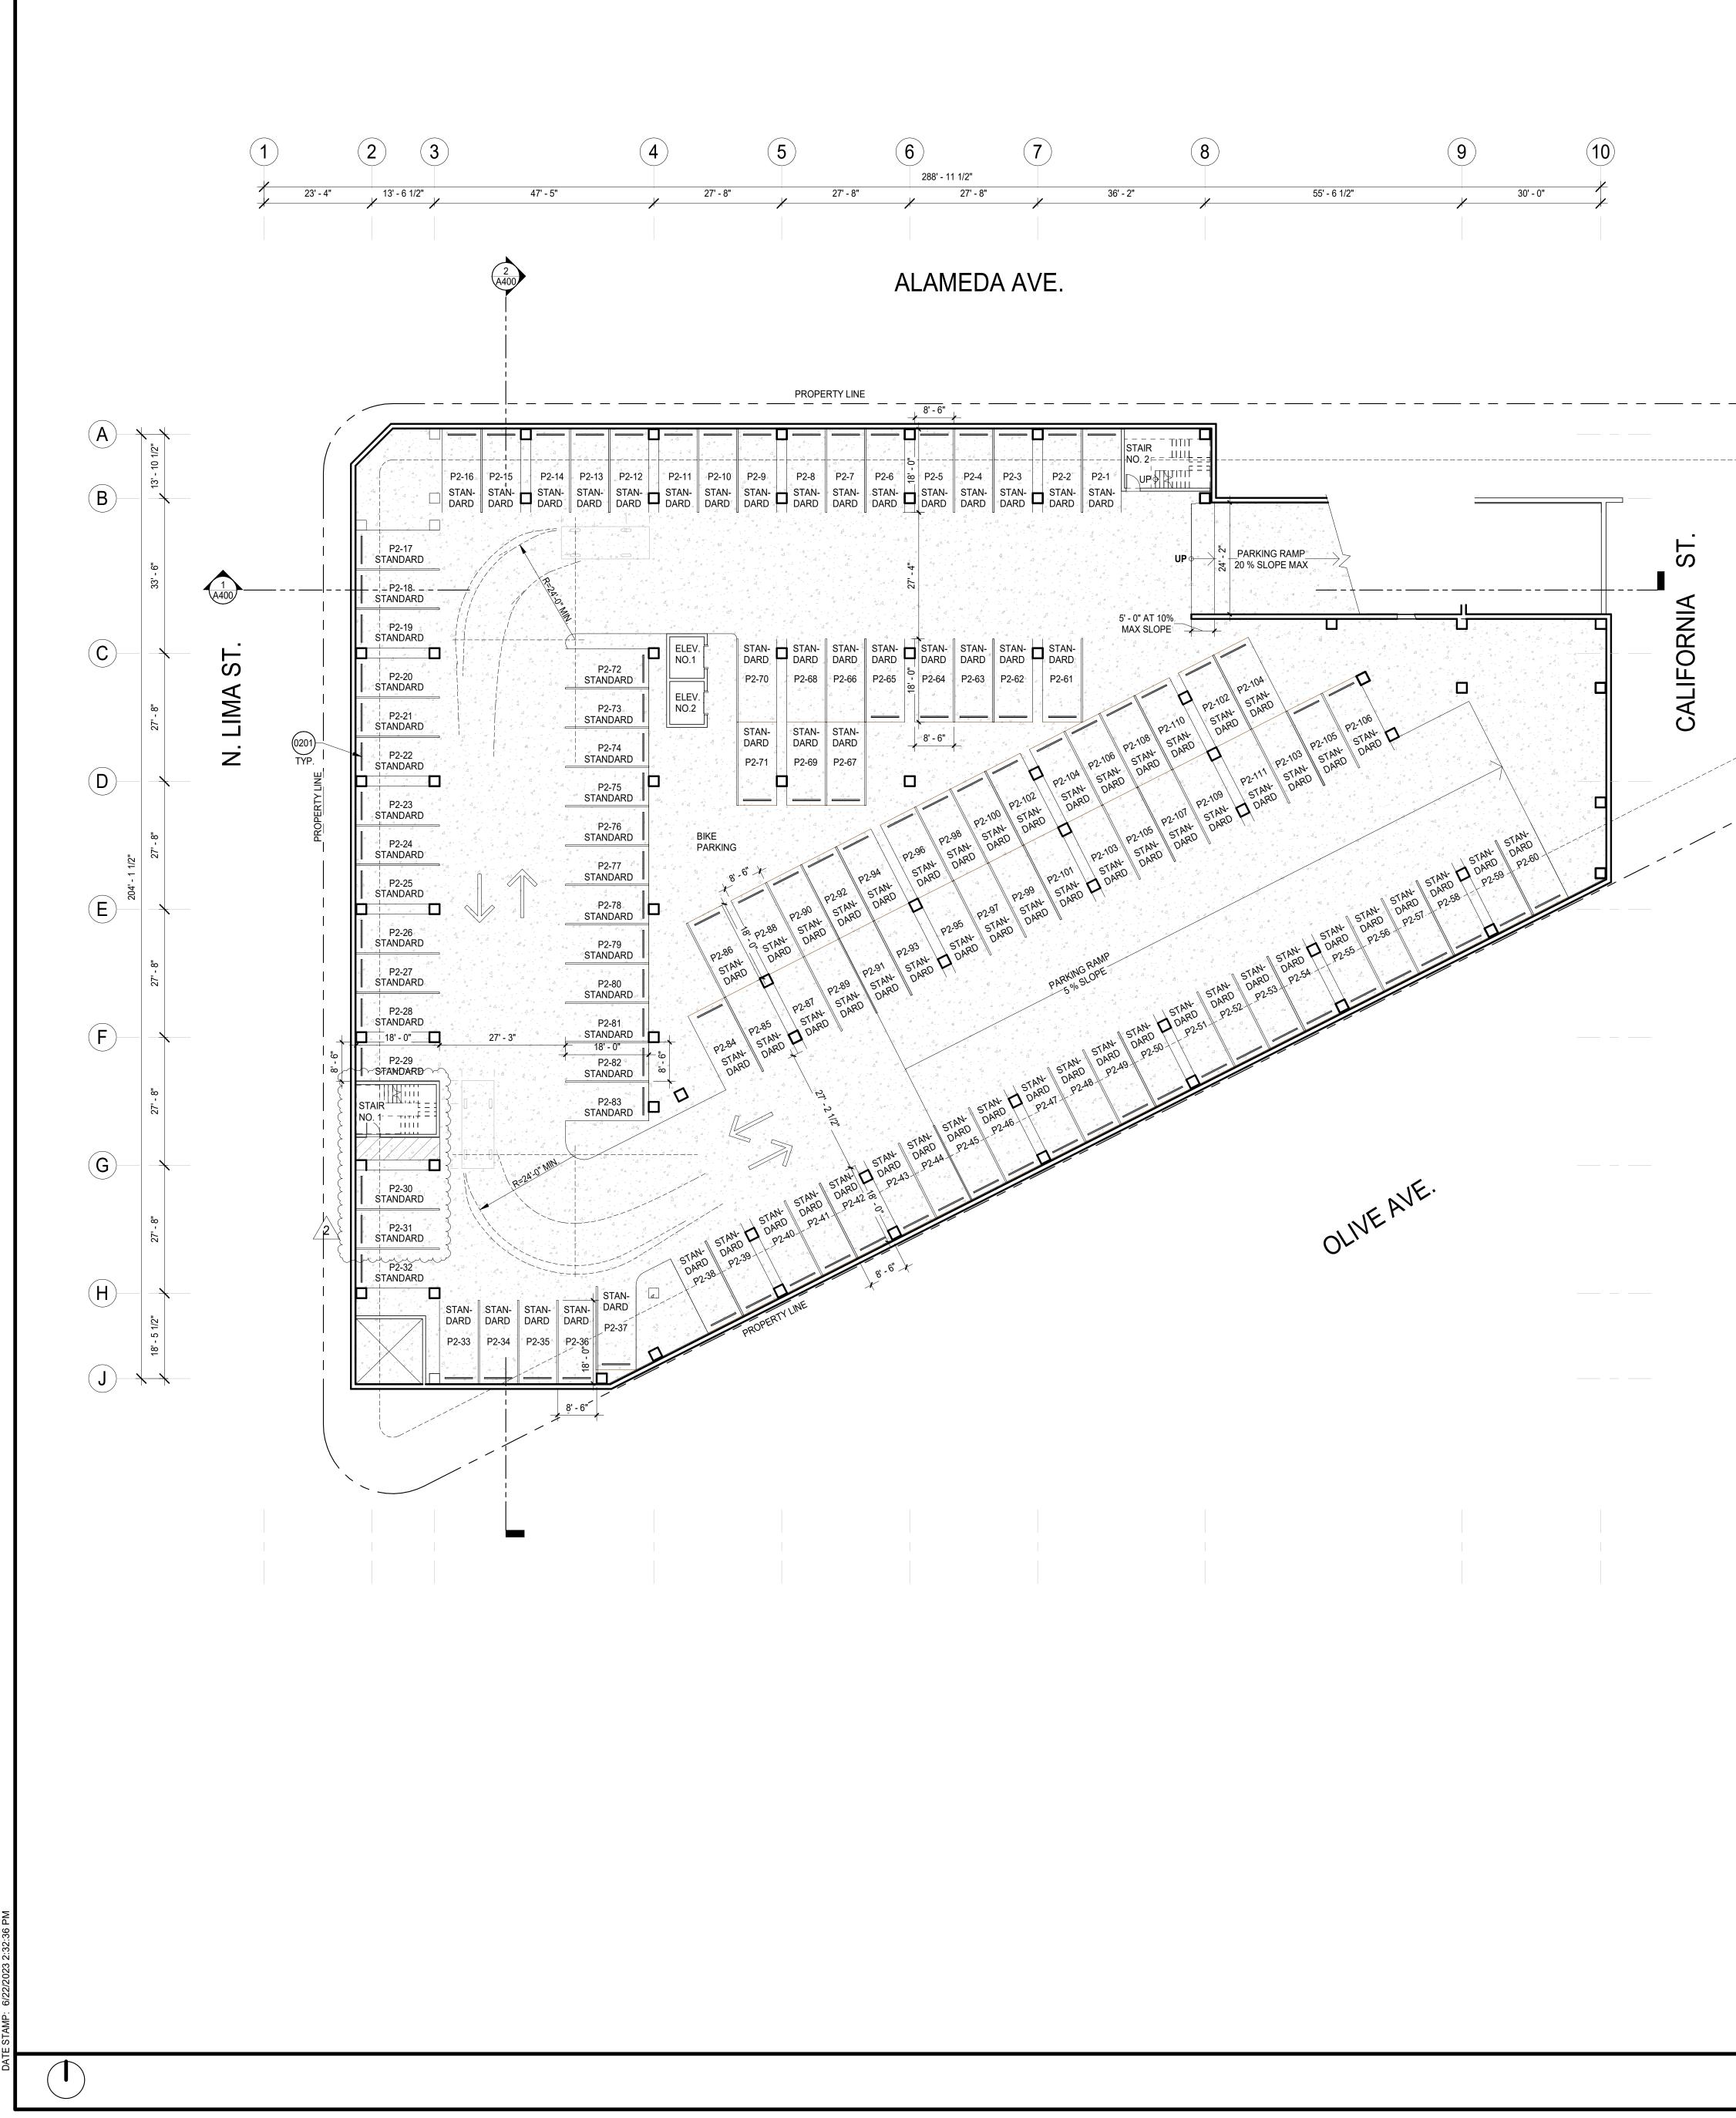


|                     |  | KE I NC   | JIES  |                          |
|---------------------|--|---|---|--------------------------|
|                     | 0201 WHEELST   | OP, TYP. AT ALL STALLS.   |   |                          |
|                     |  |   |   |                          |
|                     |  |   |   |                          |
|                     |  | GENERAL   | NOTES                                       |                          |
|                     |  |   |   |                          |
|                     | <ol> <li>REFER TO SHI</li> <li>ALL WORK SHI</li> </ol> | A003 AND A004 FOR GENERAL NOTES.<br>EET A001 FOR SYMBOLS AND ABBREVIATIC<br>ALL COMPLY WITH CURRENTLY ADOPTED I     |   | BY JURISDICTION HAVING   |
|                     | CONTRACTOR   | HALL DIMENSIONS OR OBJECTS OF ANY KIR<br>SHALL VERIFY ALL CONDITIONS AND DIME                                       | NSIONS IN THE FIELD BE                      | FORE PROCEEDING WITH     |
|                     | ARCHITECT'S<br>5. ALL DIMENSIO                         | WORK. CONTRACTOR SHALL BRING ANY E<br>ATTENTION PRIOR TO PROCEEDING WITH A<br>WARE TO FACE STUD U.O.N. FINISH FLOO  | ANY RELATED WORK.<br>DR ELEVATIONS ARE TO T | TOP OF CONCRETE SLAB     |
|                     | SURFACES U.<br>6. DIMENSIONS M                         | MARKED "MIN." INDICATE A MINIMUM CLEAF  |   |                          |
|                     | CONDUITS AN  | MEMBERS SHALL BE SO ARRANGED AND S<br>ID DUCTWORK WITH A MINIMUM OF CUTTIN<br>BRACES, BACK-UP PLATES AND SUPPORTI   | G. CONTRACTOR SHALL                         | PROVIDE AND INSTALL ALL  |
|                     | ALL WALL MOU<br>ACCESSORIES                            | UNTED OR SUSPENDED MECHANICAL AND<br>S, GRAB BARS, MILLWORK.<br>AMING IN EXTERIOR WALLS TO BE FIRE-RE               | ELECTRICAL EQUIPMENT                        | T, FIXTURES, BATHROOM    |
|                     | SECTION 2303<br>SHEATHING, S                           | 2.2. WOOD FRAMING TO INCLUDE, BUT NOT<br>SILL PLATES, TOP PLATES, ETC.<br>ING CONFIGURATION AT ALL FAN COIL UNI     | LIMITED TO: STUDS, BLO                      | CKING, EXTERIOR PLYWOOD  |
|                     | INFORMATION  | E-RATED ASSEMBLY. REFER TO MECHANIC<br>I.<br>AMING IN CONTACT WITH CONCRETE IS TO                                   |   |                          |
|                     | 12. ALL GYPSUM E<br>13. REFER TO SHI                   | ALL SURFACES TO BE FLUSH U.O.N. PROVIE<br>BOARD WALLS AND CEILINGS TO BE TAPEE<br>EET A800 FOR WALL TYPES.          | ), SANDED, AND PRIMED <sup>-</sup>          | TO LEVEL 4 FINISH U.O.N. |
|                     | 15. REFER TO SHI<br>SCHEDULES.                         | EET A700 FOR DOOR SCHEDULE AND DETA<br>EET A710 FOR FINISH, LIGHT FIXTURE, APPI                                     | LIANCE, EQUIPMENT, AND                      | ) PLUMBING FIXTURE       |
|                     | CARPORTS, G<br>PEDESTRIAN S                            | TO BE SHIELDED TO ELIMINATE GLARE ON<br>ARAGES, PARKING AREAS, AND DRIVEWAY<br>SAFETY PER BMC 10-1-2017 (G)(2)      |   |                          |
|                     |  | ORMING TO STANDARDS PRESCRIBED BY 1<br>PARKING LOTS USED FOR PUBLIC PARKIN  |   |                          |
|                     | 19. PER TABLE N-<br>ACHIEVE INTE                       | 5 OF THE BURBANK 2035 GENERAL PLAN TI<br>RIOR NOISE LEVELS US 45DBA MAX. PER T<br>TION SOURCES OF THE GENERAL PLAN. |   |                          |
|                     | 20. THIS PROJECT                                       | T WILL BE CONSTRUCTED INCORPORATING<br>OF ENERGY, WATER, AND OTHER NATURA   |   |                          |
|                     |  | LEGE  | ND  |                          |
|                     | N.I.C.   | NOT IN CONTRACT   | ALIGN —                                     | ALIGN ELEMENTS           |
|                     |  |   | <u> </u>                                    |                          |
|                     |  |   | RM NAME<br>#                                | ROOM NAME AND NUMBE      |
|                     |  | NEW MILLWORK  | F.E.C.                                      | FIRE EXTINGUISHER CAB    |
|                     |  |   |   | NEW PLUMBING FIXTURE     |
|                     |  |   |   |                          |
|                     |  | EXISTING DOOR   |   |                          |
|                     | C# -   | WALL TAG. REFER TO A800   |   |                          |
|                     |  | NEW PARTITION PER PLAN  |   |                          |
|                     | 4" TYP.<br>4" TYP.                                     |   |   |                          |
|                     |  | NEW DOOR  |   |                          |
|                     |  |   |   |                          |
|                     | < <u>1001</u> >  | DOOR NUMBER. REFER TO A700  |   |                          |
|                     | <##  | WINDOW TAG. REFER TO A700   |   |                          |
|                     |  | SYSTEM PER SCHEDULE.  |   |                          |
| FLOOR PLAN - P-2    | $\langle \mathbf{A} \rangle$                           | NEW PLUMBING FIXTURE,<br>APPLIANCE, OR EQUIPMENT.<br>REFER TO A710  |   |                          |
| <u>1/16" = 1'-0</u> |  |   |   |                          |
|                     |  |   |   |                          |
|                     |  |   |   |                          |

**KEYNOTES** 

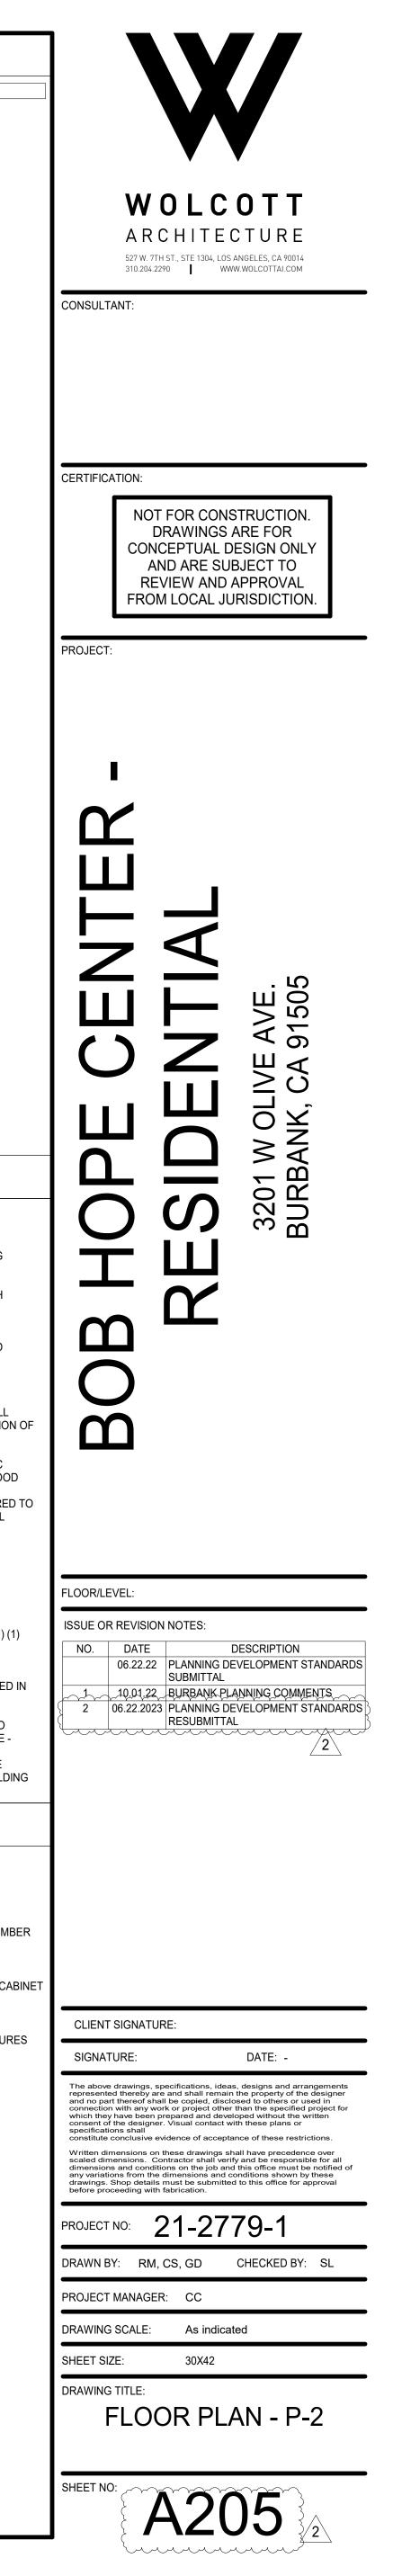

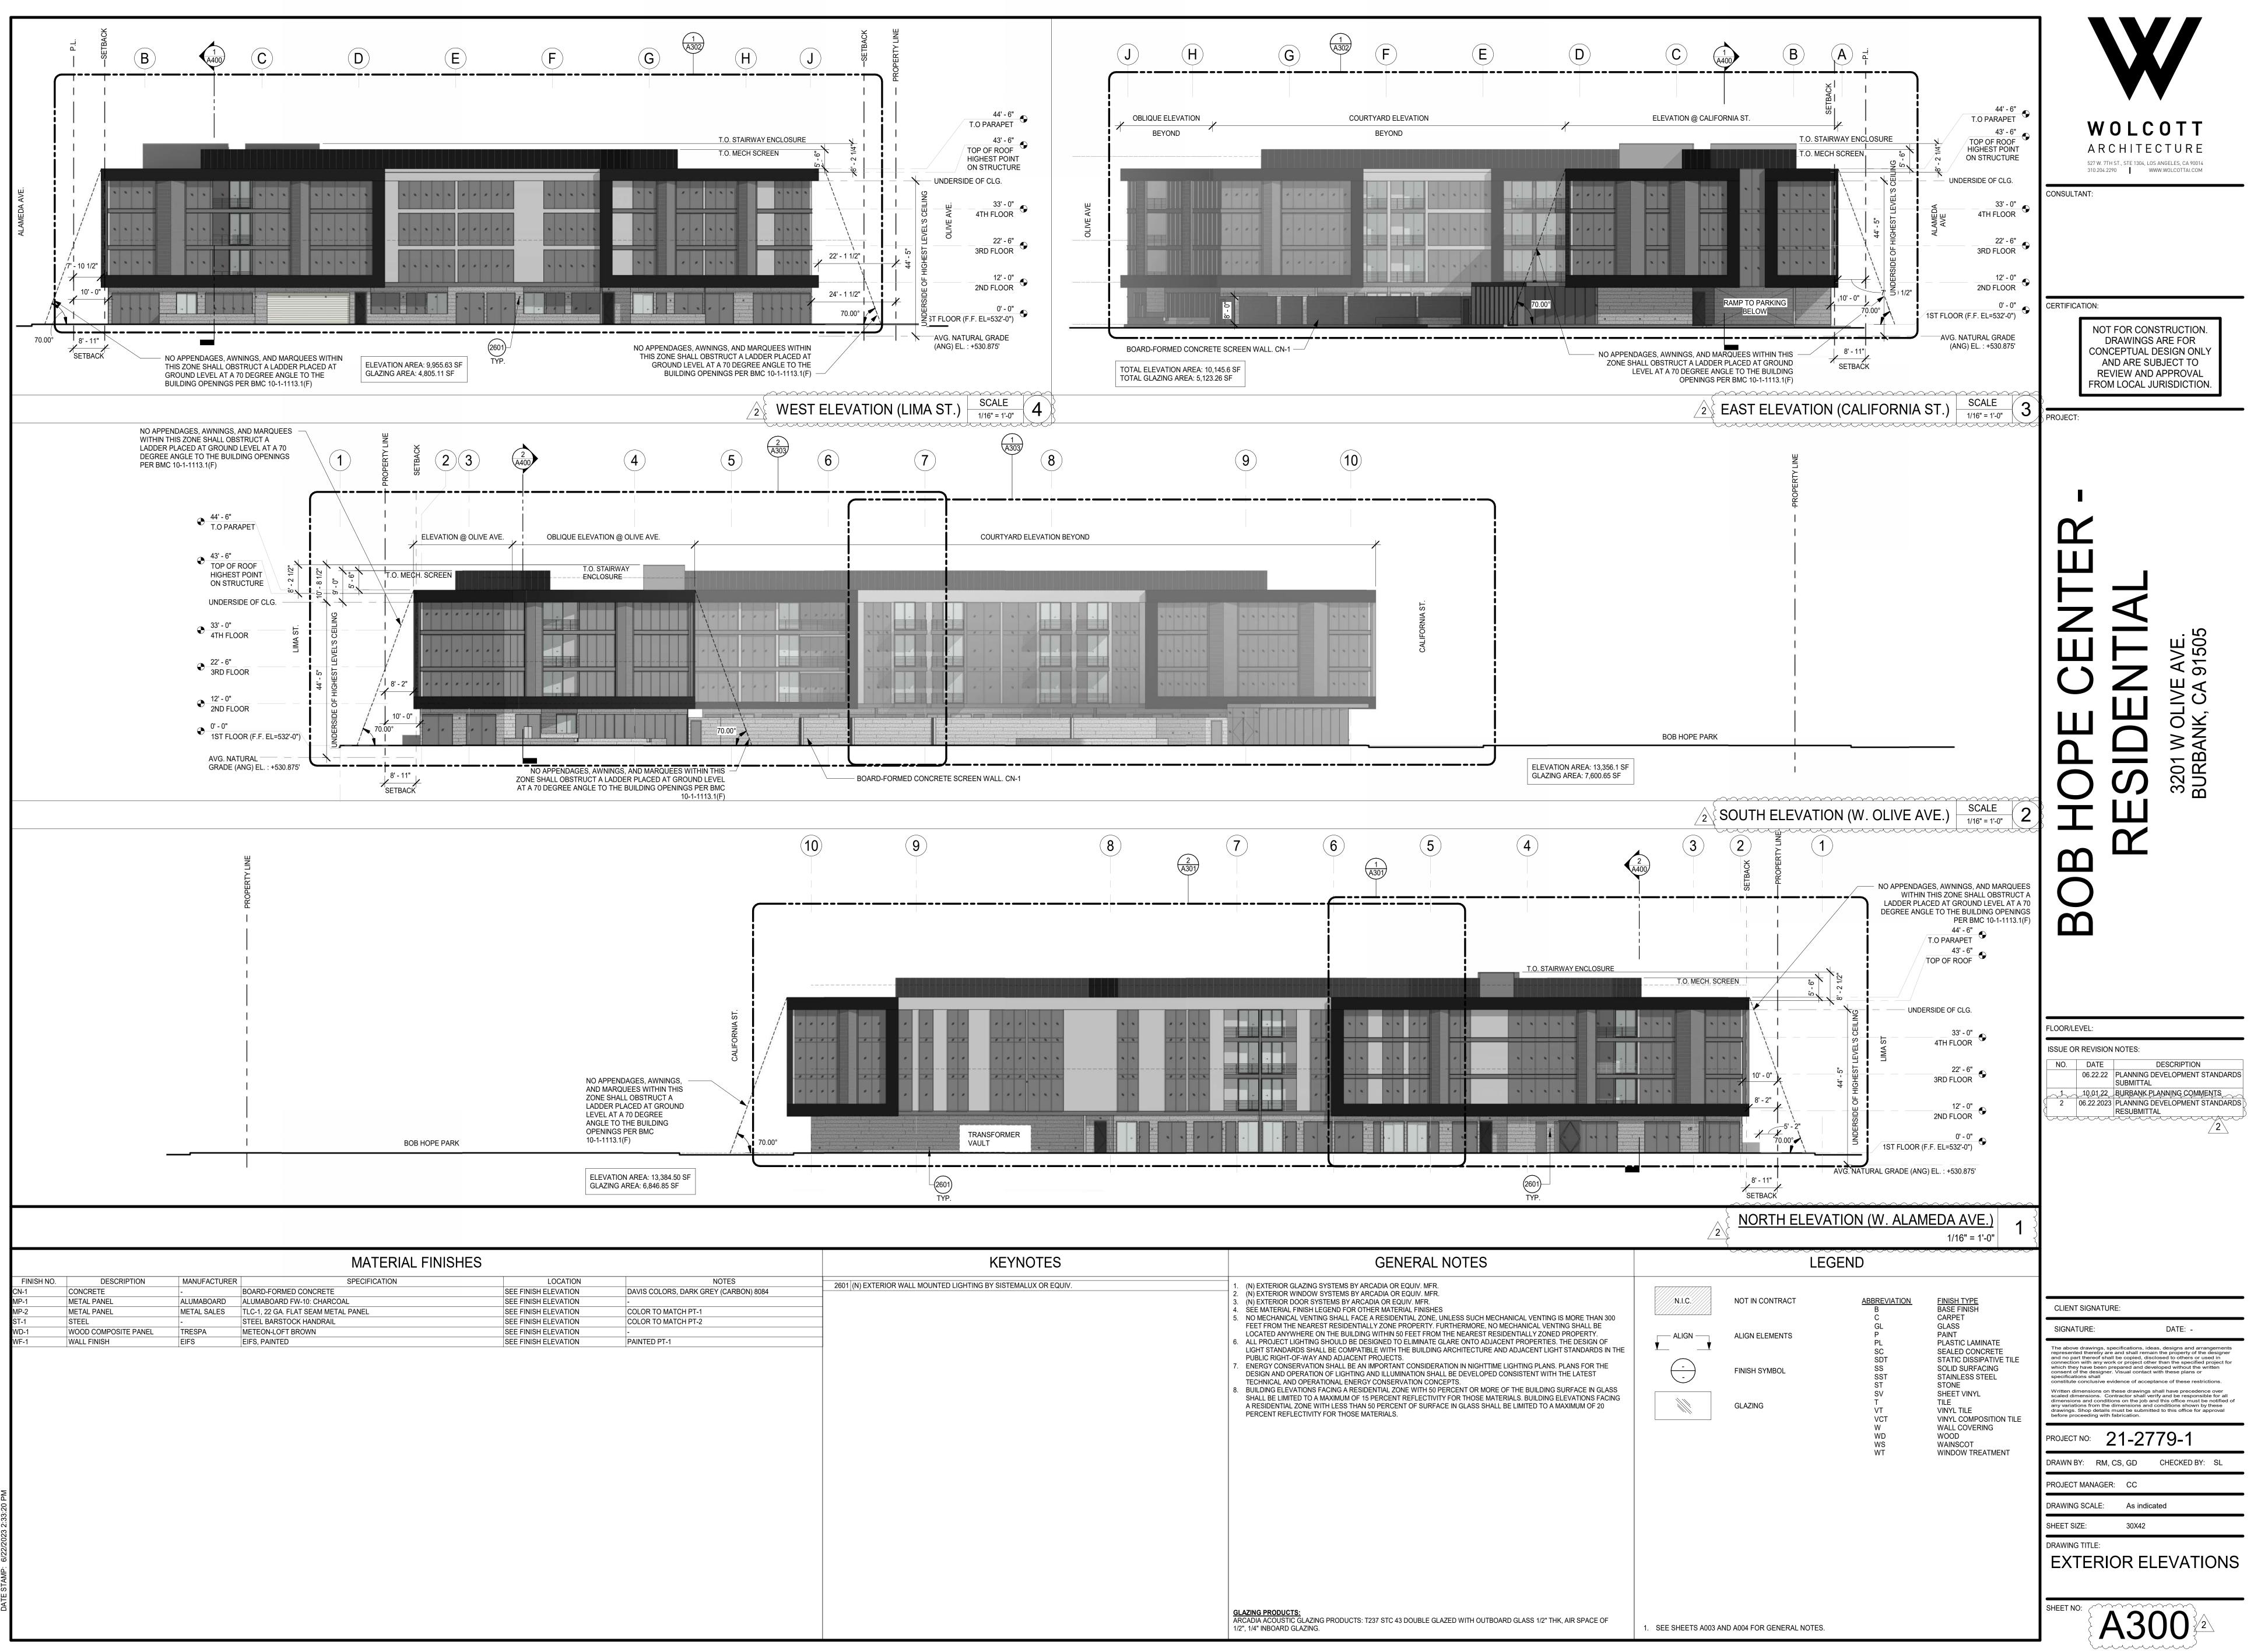


E NAME: Autodesk Docs://R22\_BHC-Residential/21-2779-1 BobHopeCenter-Re-

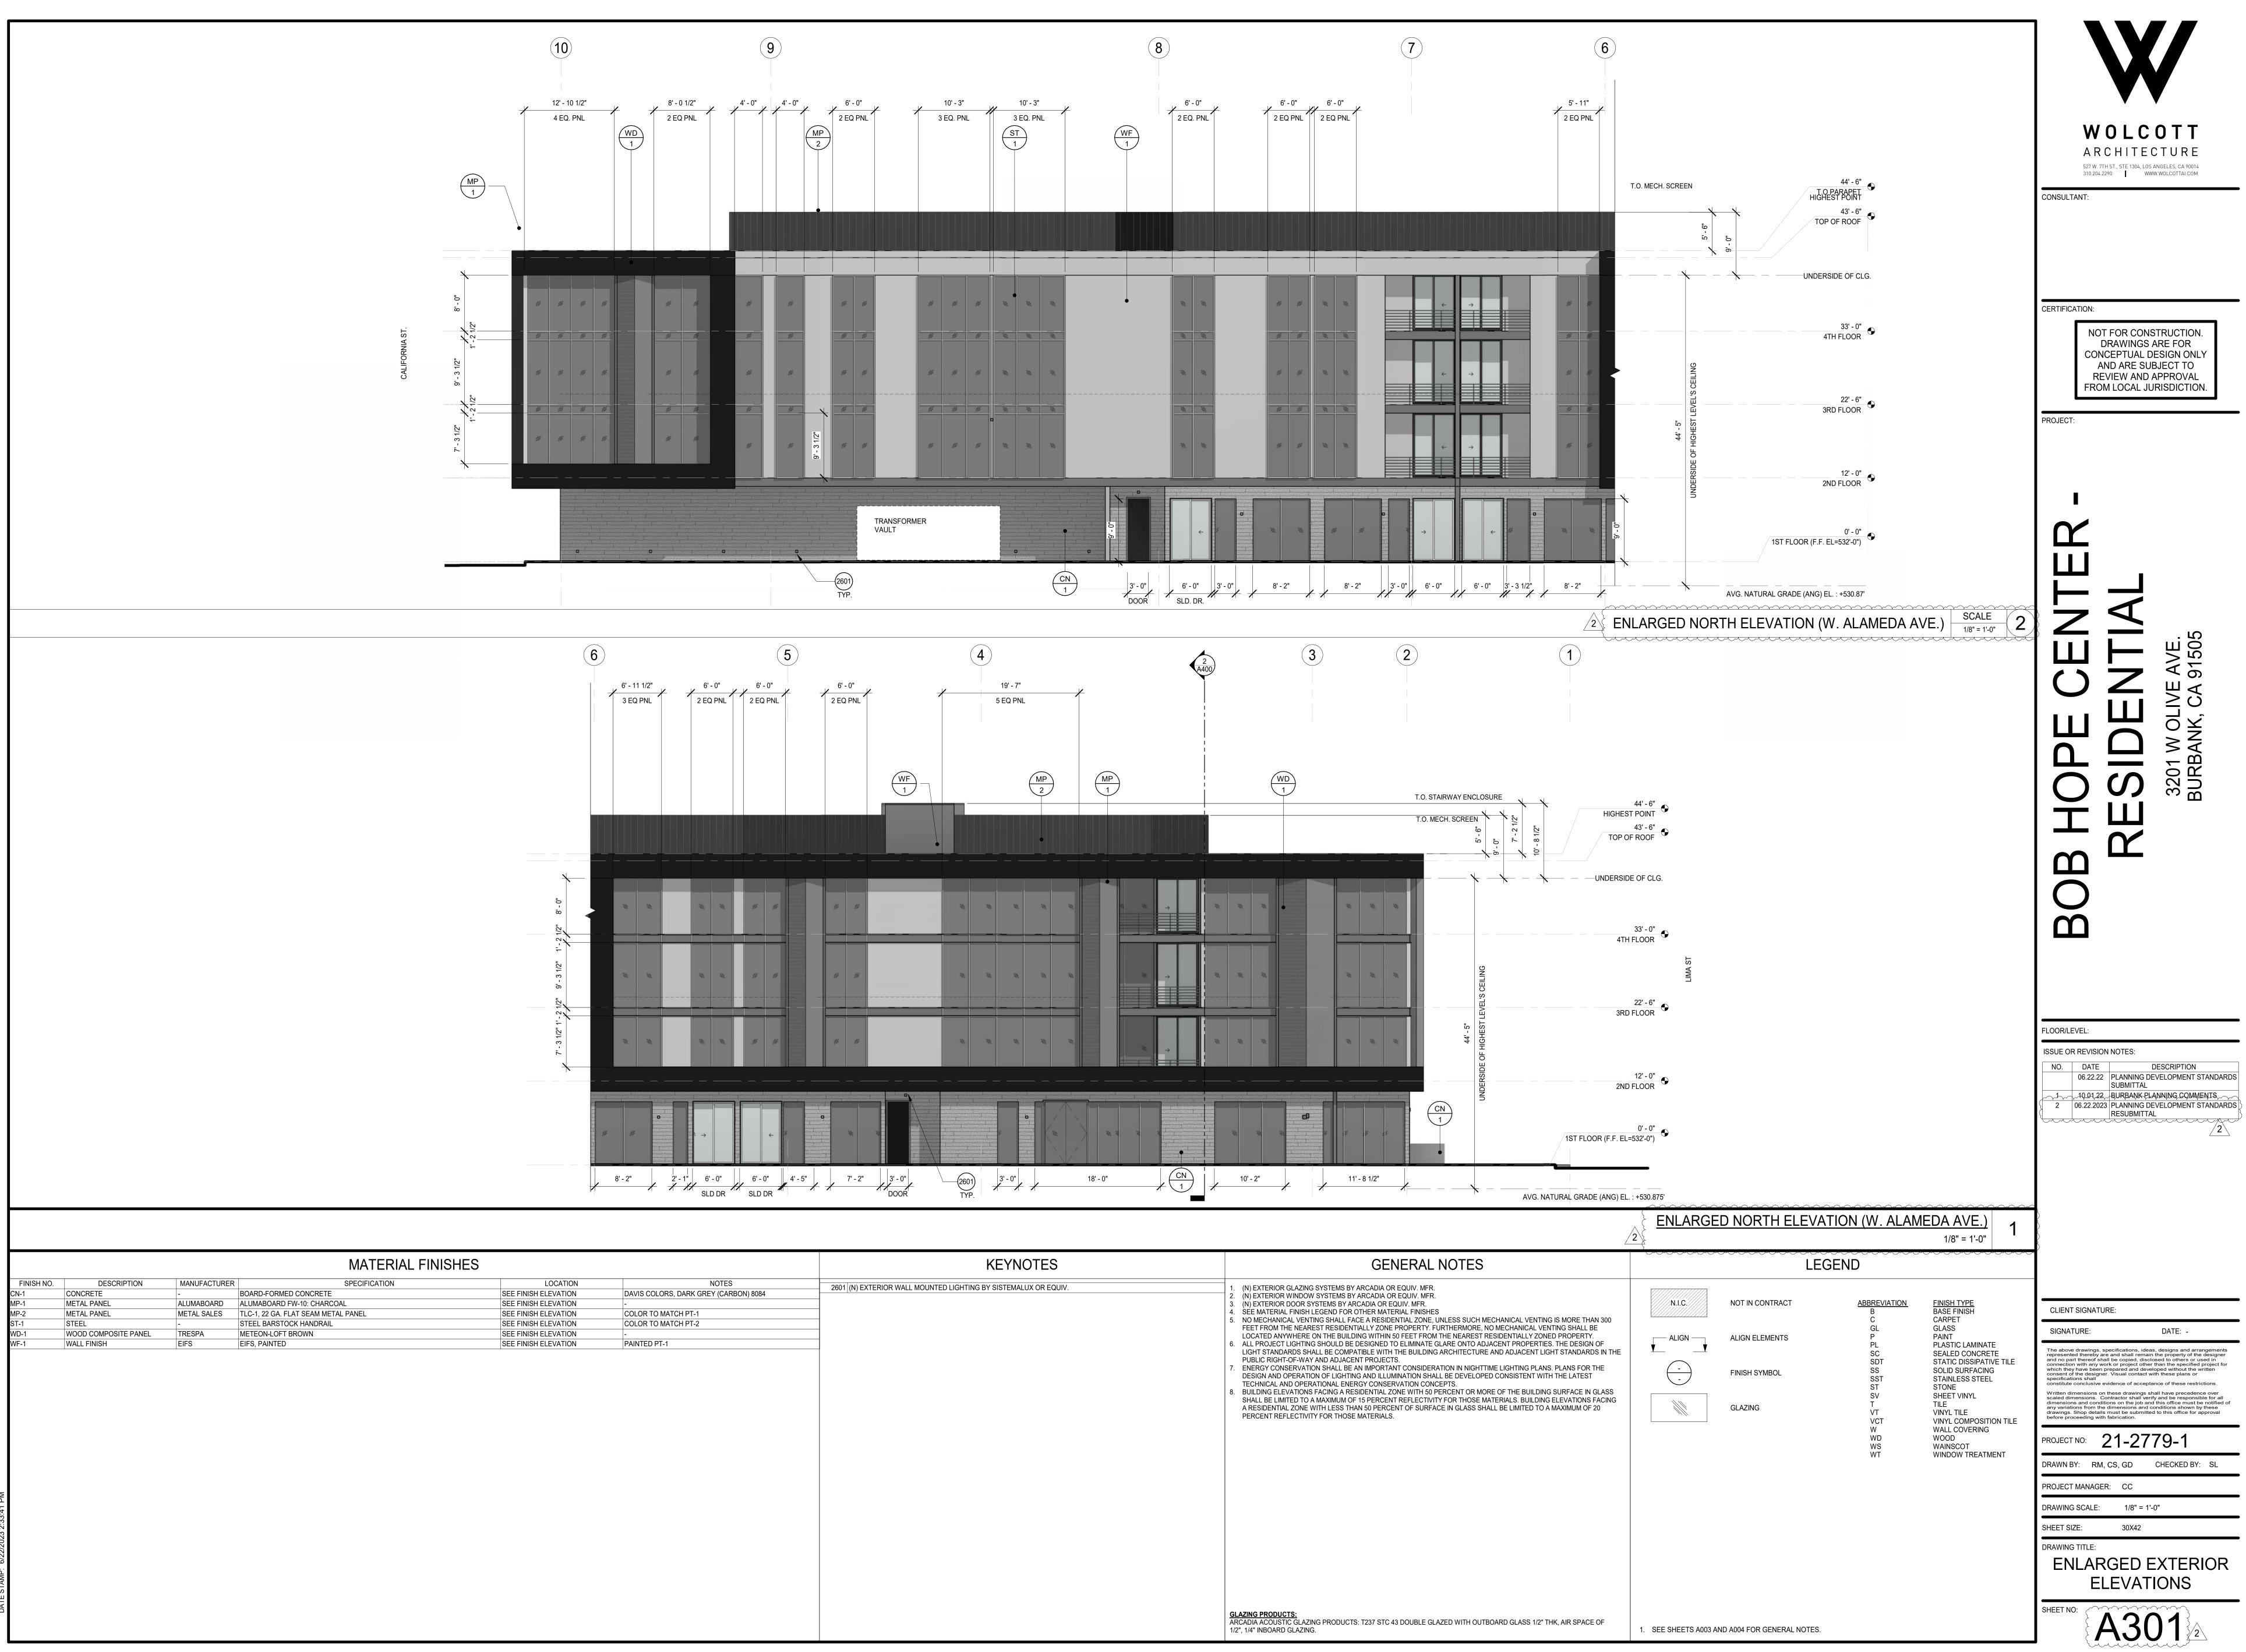


|                                       | KEYNOTES  |  |
|---------------------------------------|---|--|
| NOTES                                 | 2601 (N) EXTERIOR WALL MOUNTED LIGHTING BY SISTEMALUX OR EQUIV. | 1. (N) EXTERIOR GLAZING S  |
| DAVIS COLORS, DARK GREY (CARBON) 8084 | 2001 (N) EXTERIOR WALL MOUNTED LIGHTING BY SISTEMALOX OR EQUIV. | 2. (N) EXTERIOR GLAZING S  |
| -                                     |   | 3. (N) EXTERIOR DOOR SYS   |
| COLOR TO MATCH PT-1                   |   | 4. SÉE MATERIAL FINISH LE  |
| COLOR TO MATCH PT-2                   |   | 5. NO MECHANICAL VENTIN<br>FEET FROM THE NEARES  |
| -                                     |   | LOCATED ANYWHERE ON  |
| PAINTED PT-1                          |   | <ol> <li>ALL PROJECT LIGHTING S<br/>LIGHT STANDARDS SHAL<br/>PUBLIC RIGHT-OF-WAY A</li> <li>ENERGY CONSERVATION<br/>DESIGN AND OPERATION<br/>TECHNICAL AND OPERAT</li> <li>BUILDING ELEVATIONS F/<br/>SHALL BE LIMITED TO A M<br/>A RESIDENTIAL ZONE WIT<br/>PERCENT REFLECTIVITY</li> </ol> |
|                                       |   | <u>GLAZING PRODUCTS:</u><br>ARCADIA ACOUSTIC GLAZING<br>1/2", 1/4" INBOARD GLAZING.  |
|                                       |   |  |




|  | KEYNOTES  |   |
|--|---|---|
| NOTES DAVIS COLORS, DARK GREY (CARBON) 8084 - COLOR TO MATCH PT-1 COLOR TO MATCH PT-2 - PAINTED PT-1 | 2601 (N) EXTERIOR WALL MOUNTED LIGHTING BY SISTEMALUX OR EQUIV. | 1. (N) EXTERIOR GLAZING<br>2. (N) EXTERIOR WINDOW<br>3. (N) EXTERIOR DOOR SN<br>4. SEE MATERIAL FINISH I<br>5. NO MECHANICAL VENT<br>FEET FROM THE NEARE<br>LOCATED ANYWHERE (<br>6. ALL PROJECT LIGHTING<br>LIGHT STANDARDS SH<br>PUBLIC RIGHT-OF-WAY<br>7. ENERGY CONSERVATION<br>DESIGN AND OPERATION<br>TECHNICAL AND OPERATION<br>8. BUILDING ELEVATIONS<br>SHALL BE LIMITED TO A<br>A RESIDENTIAL ZONE V<br>PERCENT REFLECTIVIT |
|  |   | ARCADIA ACOUSTIC GLAZIN<br>1/2", 1/4" INBOARD GLAZING   |

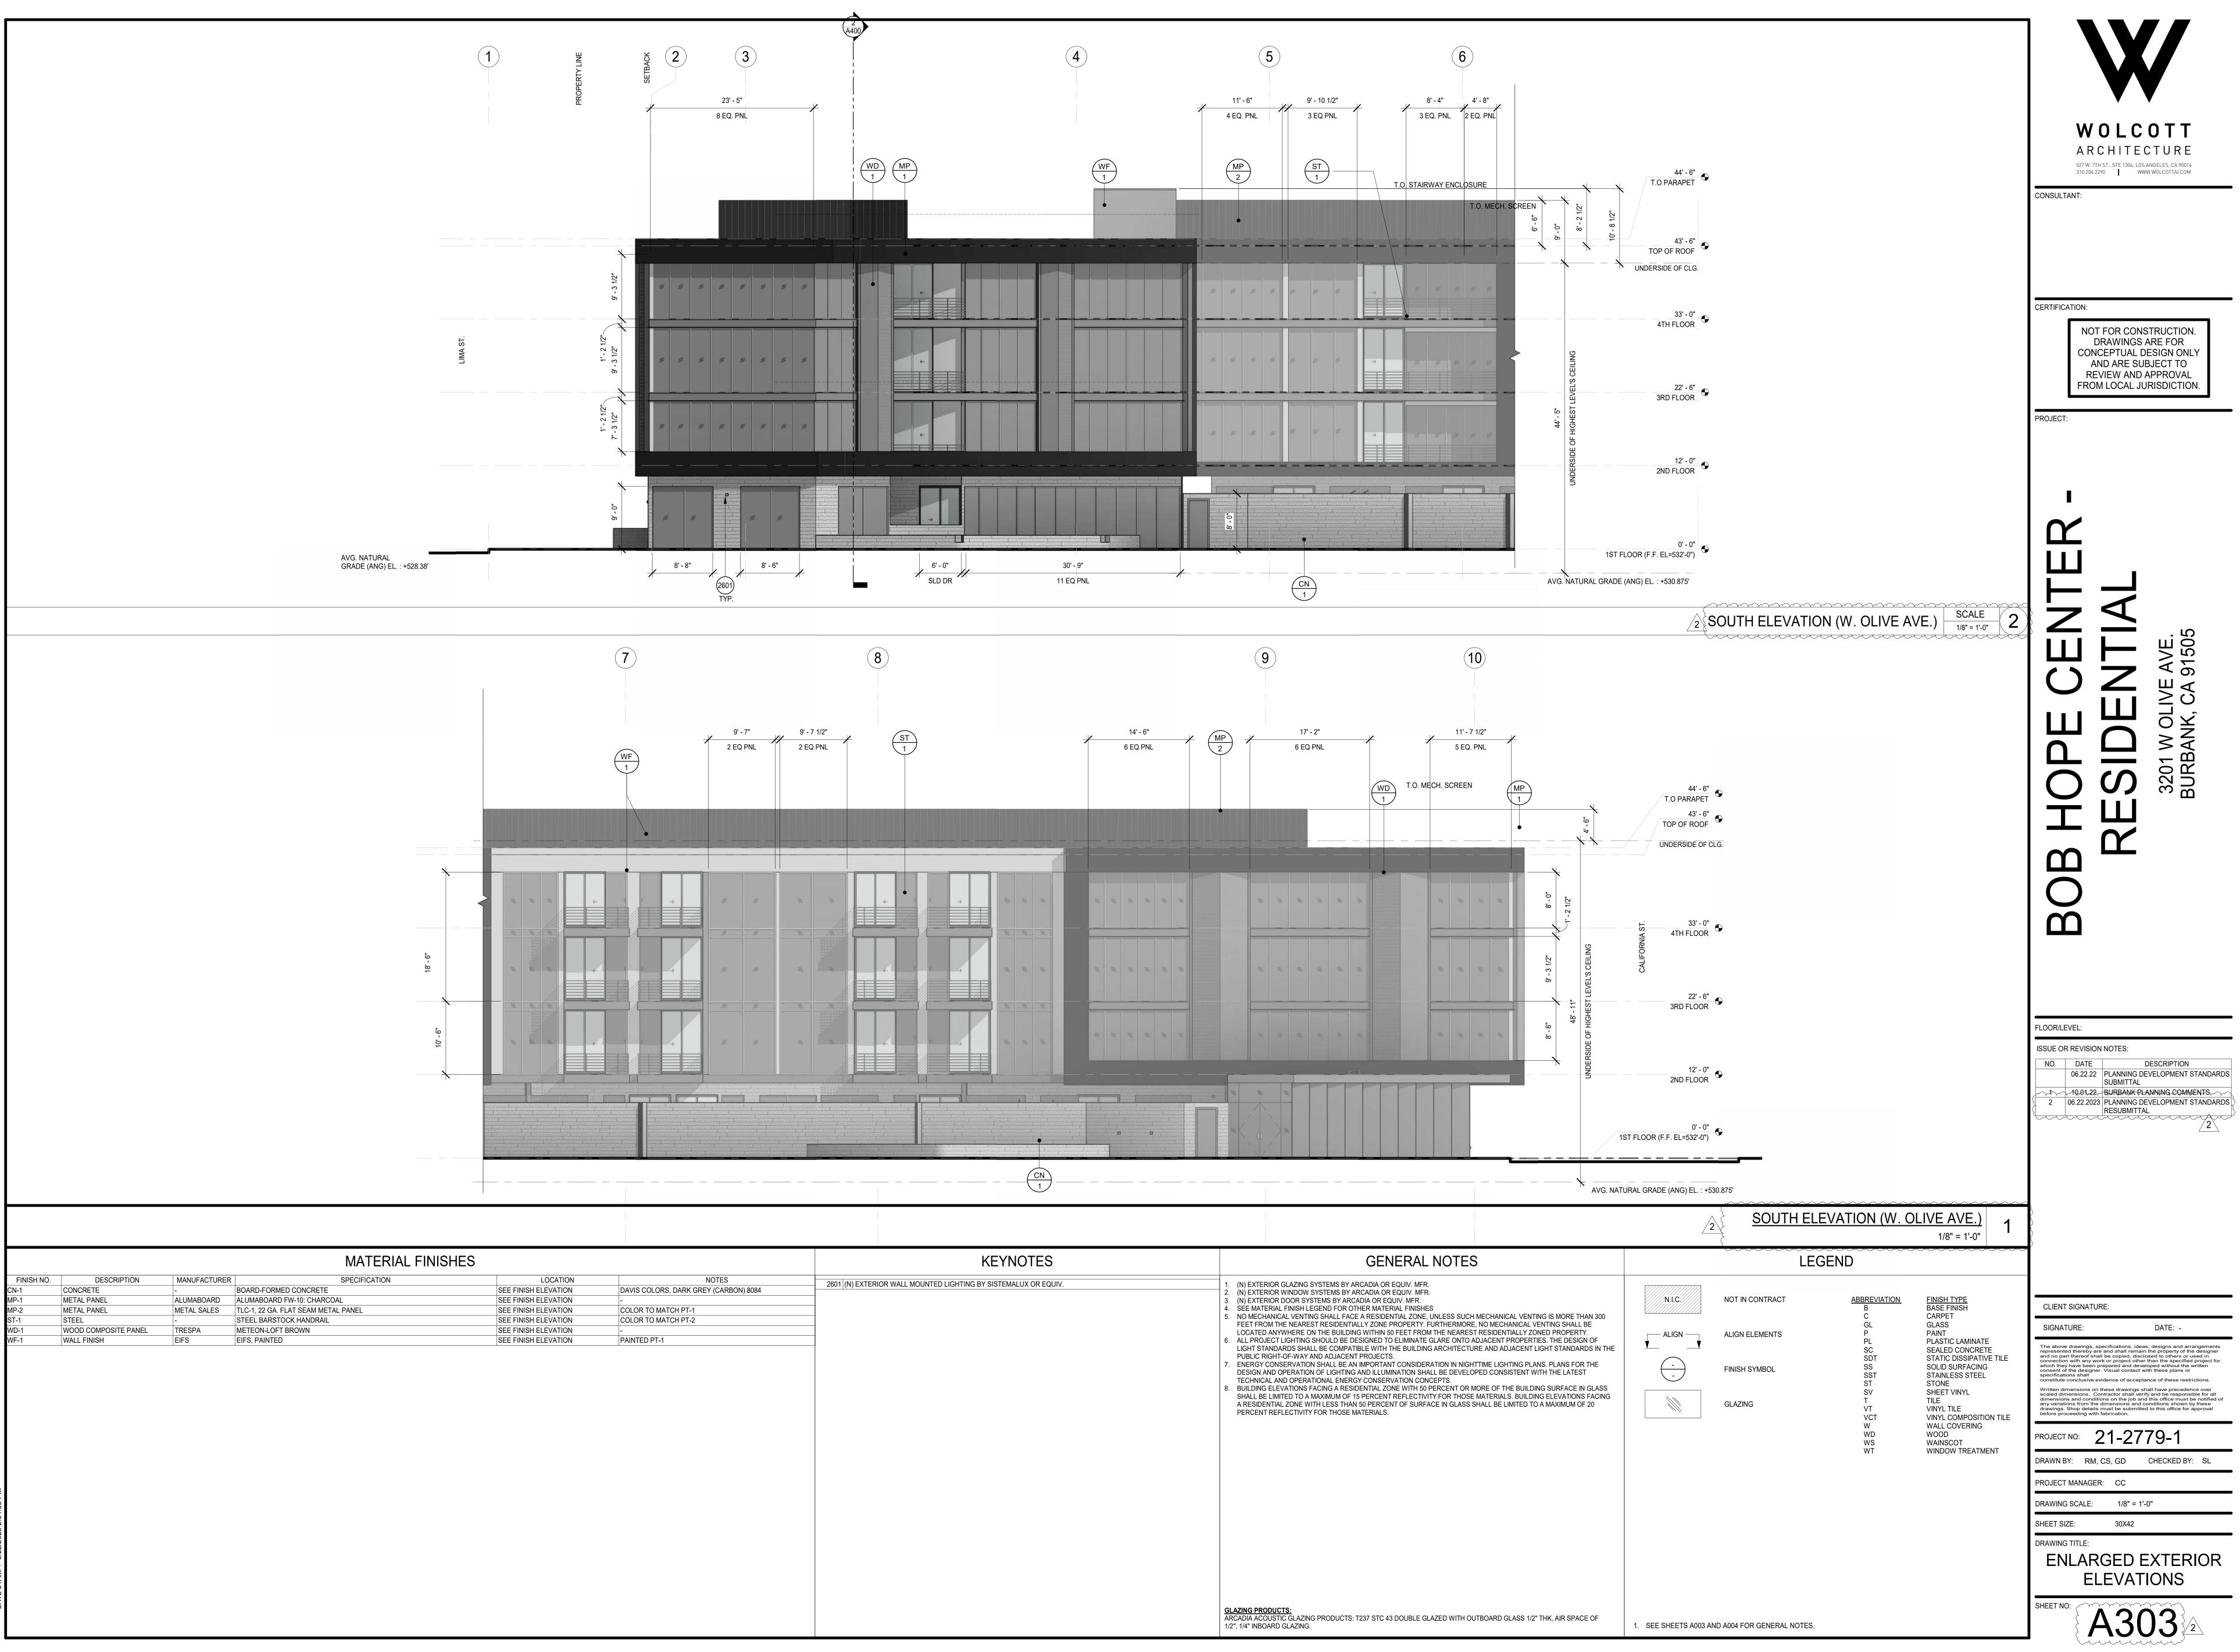


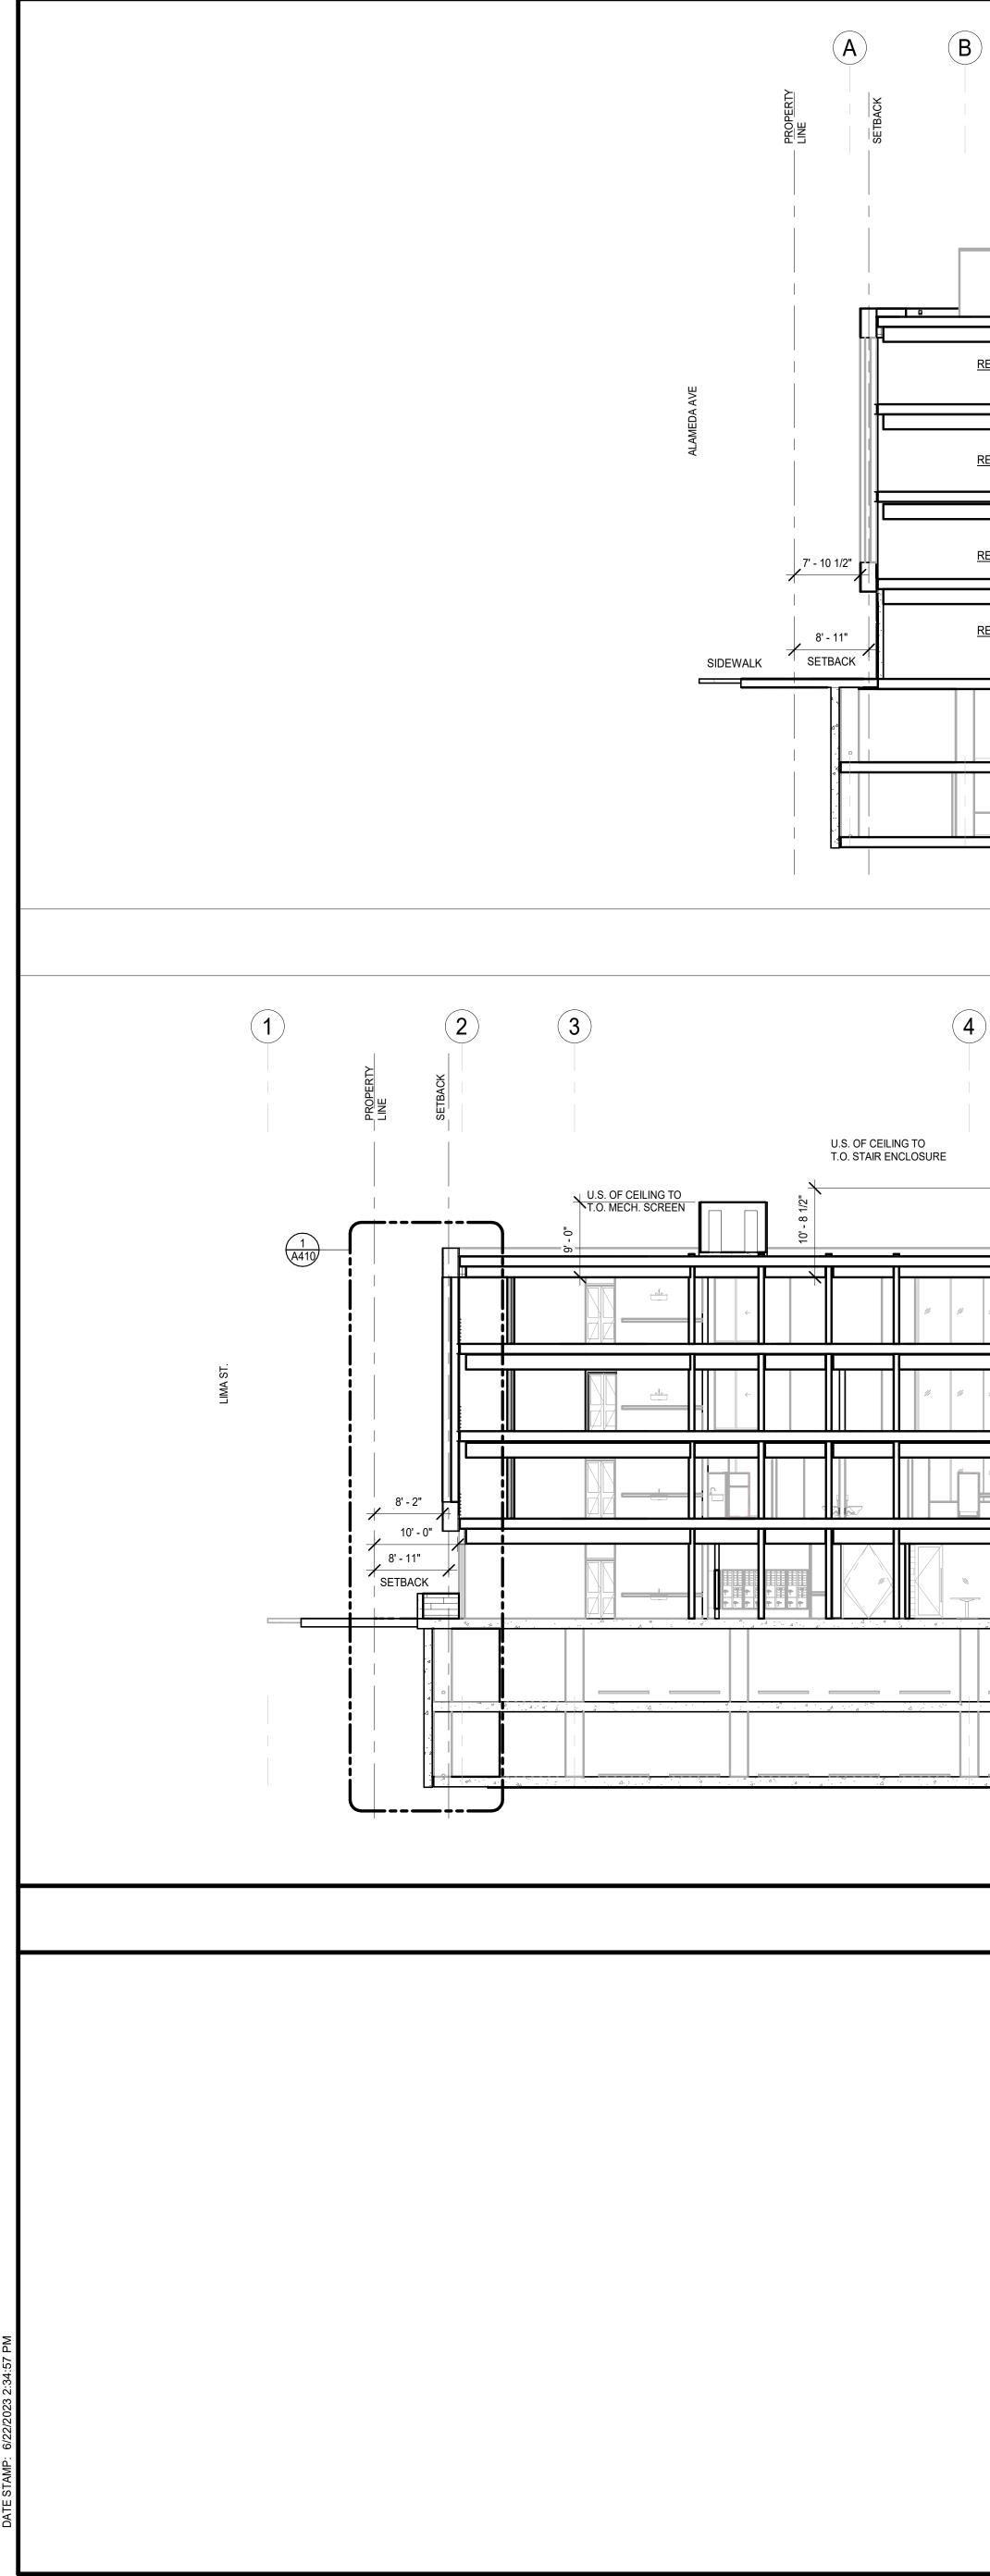


| )                 | C                                       | D                           | E      | F                                      |   |
|-------------------|---|-----------------------------|--------|--|---|
|                   |   |                             |        |  | MECHANICAL SCREEN<br>FINISH SPEC MP-2<br>MECHANICAL EQUIPM<br>MECHANICAL DRAWIN |
|                   |   |                             |        |  |   |
| RESIDENTIAL FLOOR |   |                             |        |  |   |
| RESIDENTIAL FLOOR |   |                             |        |  | STAF  |
| RESIDENTIAL FLOOR |   |                             |        |  |   |
| RESIDENTIAL FLOOR |   |                             |        |  |   |
| PARKING P-1       |   |                             |        |  |   |
| PARKING P-2       |   |                             |        |  |   |
|                   | (5)                                     | (6)                         | 7      |  | (8)   |
|                   |   |                             |        | 9<br>A410                              |   |
|                   | U.S. OF CEILING TO<br>T.O. MECH. SCREEN |                             |        | J.S. OF CEILING TO<br>.O. MECH. SCREEN |   |
| STAIRWAY #1       | U.S. OF CEILING TO<br>T.O. MECH. SCREEN | N<br>RESIDENTIAL FLOOR<br>↔ |        | J.S. OF CEILING TO<br>.O. MECH. SCREEN |   |
|                   | U.S. OF CEILING TO<br>T.O. MECH. SCREEN |                             | -<br>0 | J.S. OF CEILING TO<br>TO. MECH. SCREEN |   |
|                   | U.S. OF CEILING TO<br>T.O. MECH. SCREEN |                             |        | U.S. OF CEILING TO<br>O. MECH. SCREEN  |   |
|                   |   | RESIDENTIAL FLOOR           |        | D.S. OF CEILING TO<br>O. MECH. SCREEN  |   |
|                   | U.S. OF CEILING TO<br>T.O. MECH. SCREEN | RESIDENTIAL FLOOR           |        | D.S. OF CEILING TO<br>O. MECH. SCREEN  |   |
|                   |   | RESIDENTIAL FLOOR           |        | D.S. OF CEILING TO<br>O. MECH. SCREEN  |   |

| KEYNOTES |                        |
|----------|------------------------|
|          | 1. SEE SHEETS A003 AND |
|          |                        |
|          |                        |
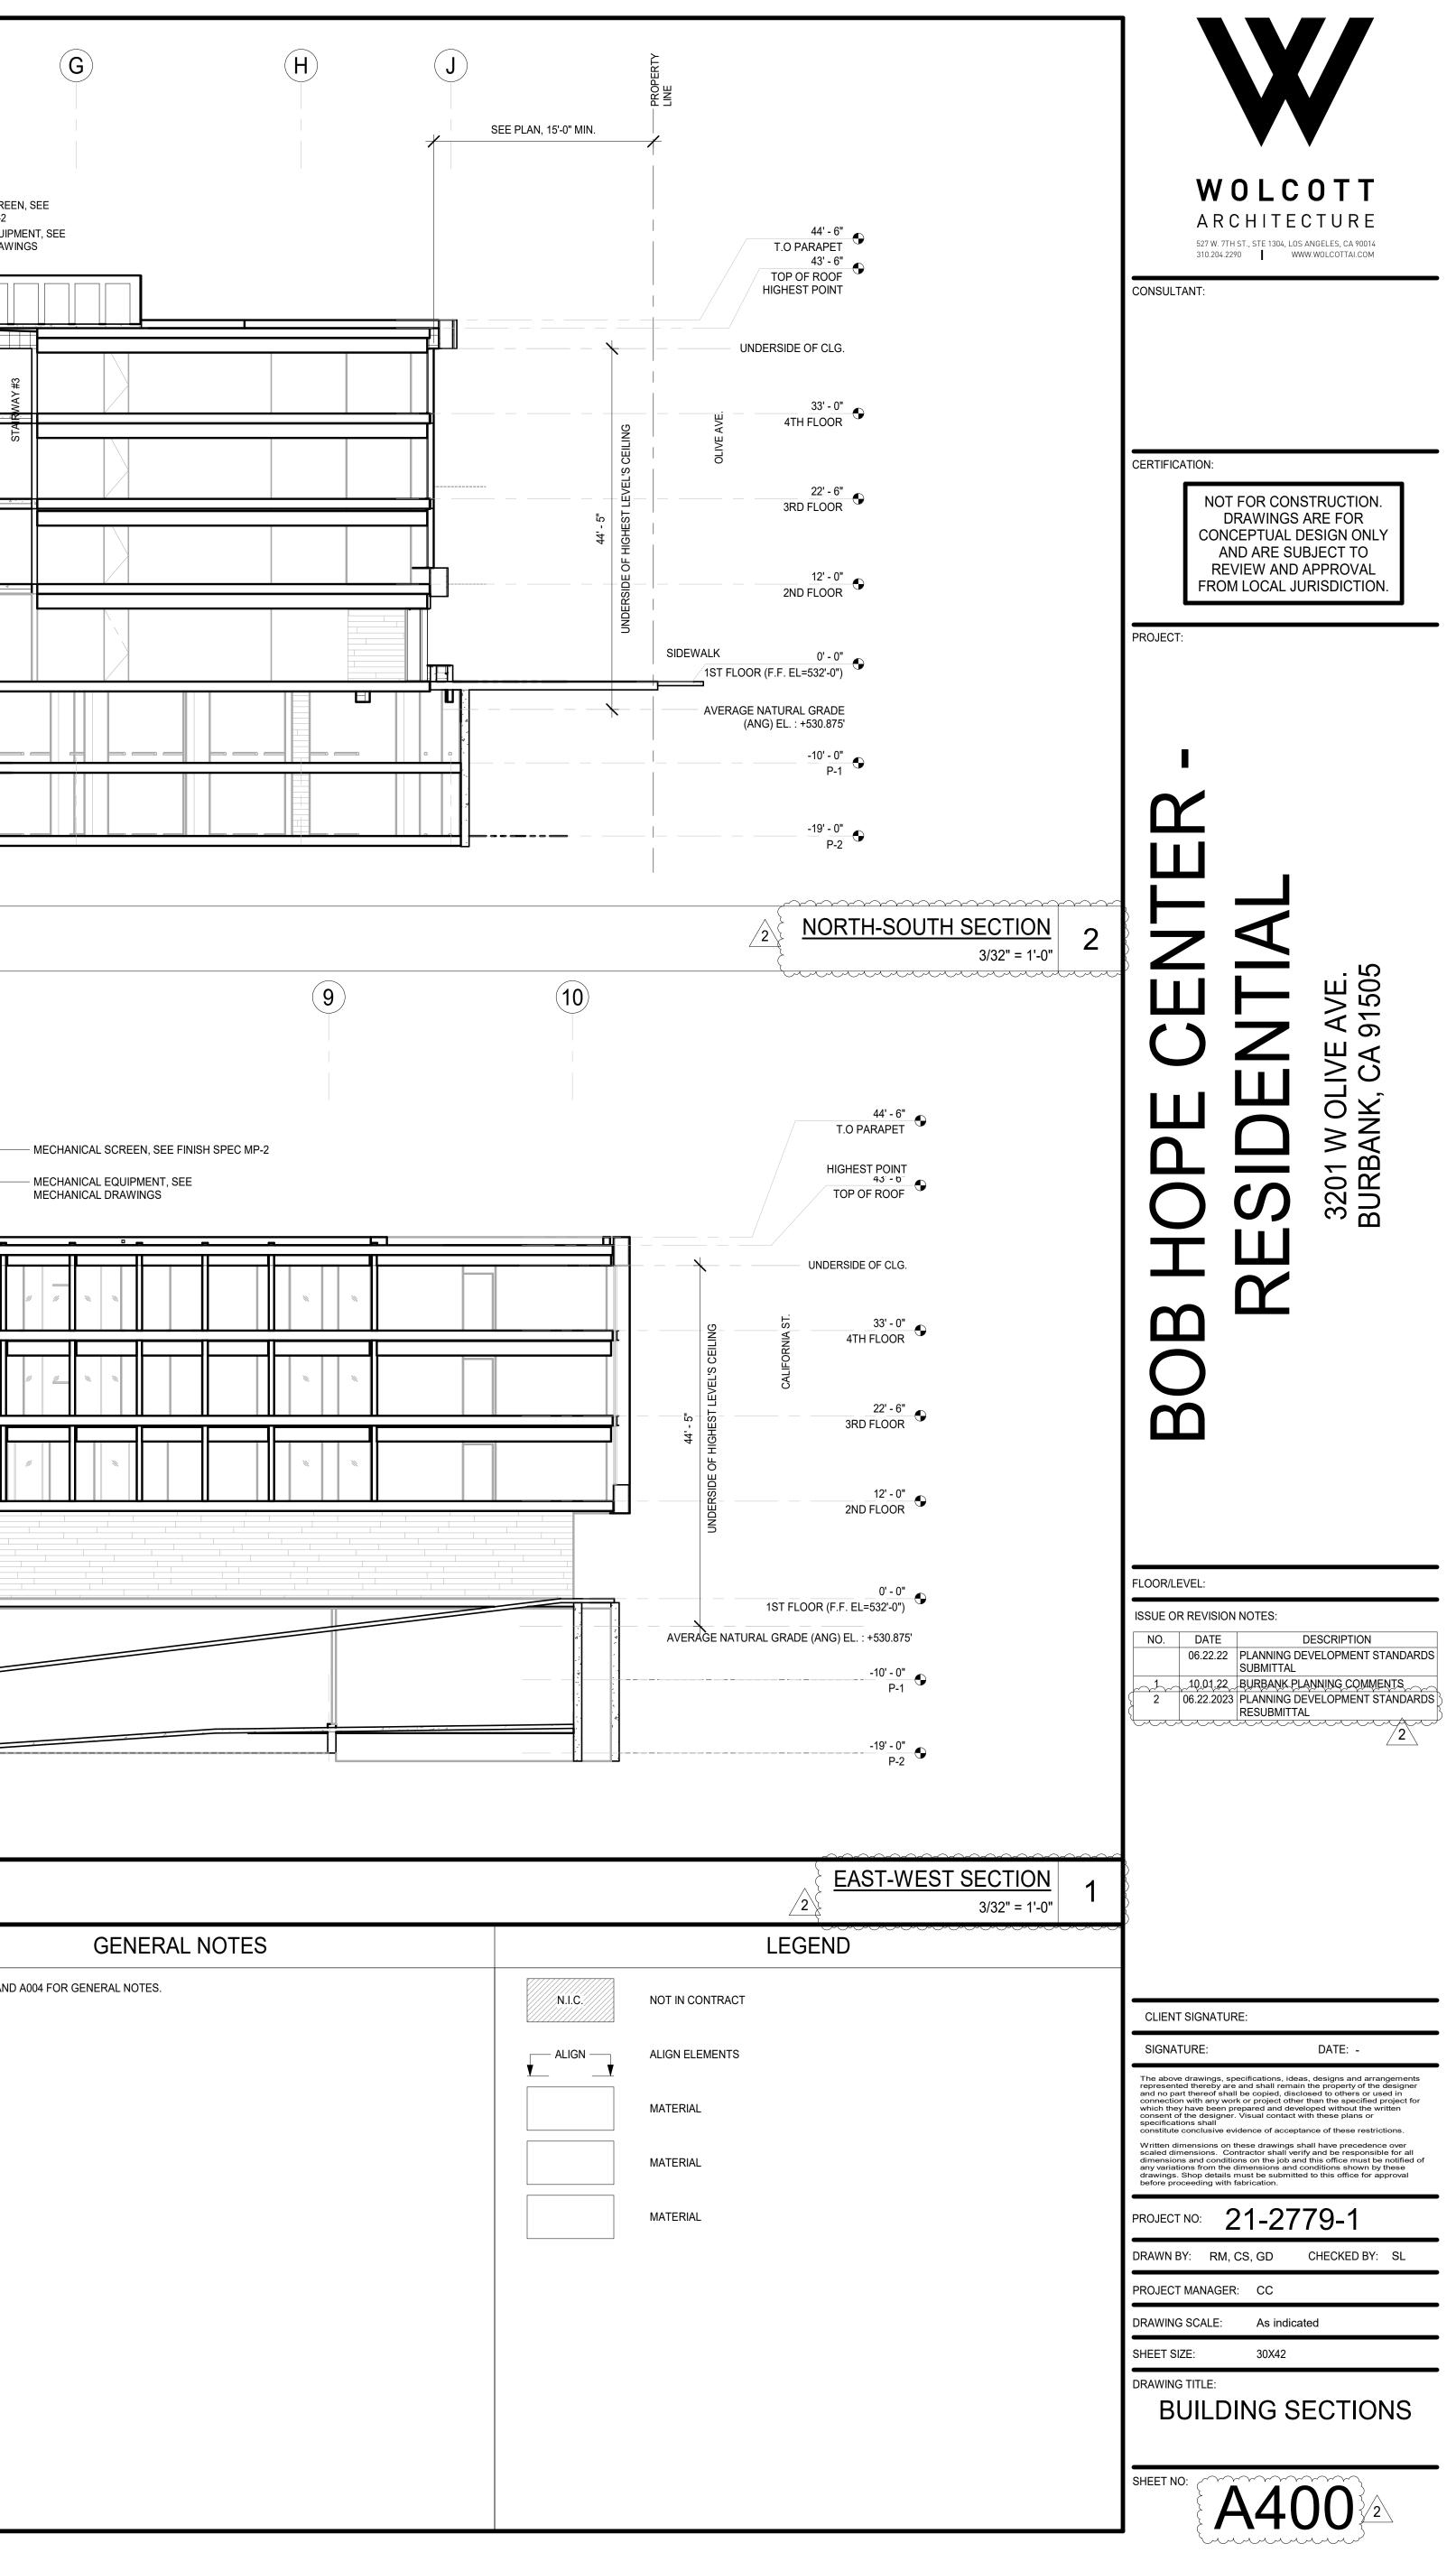


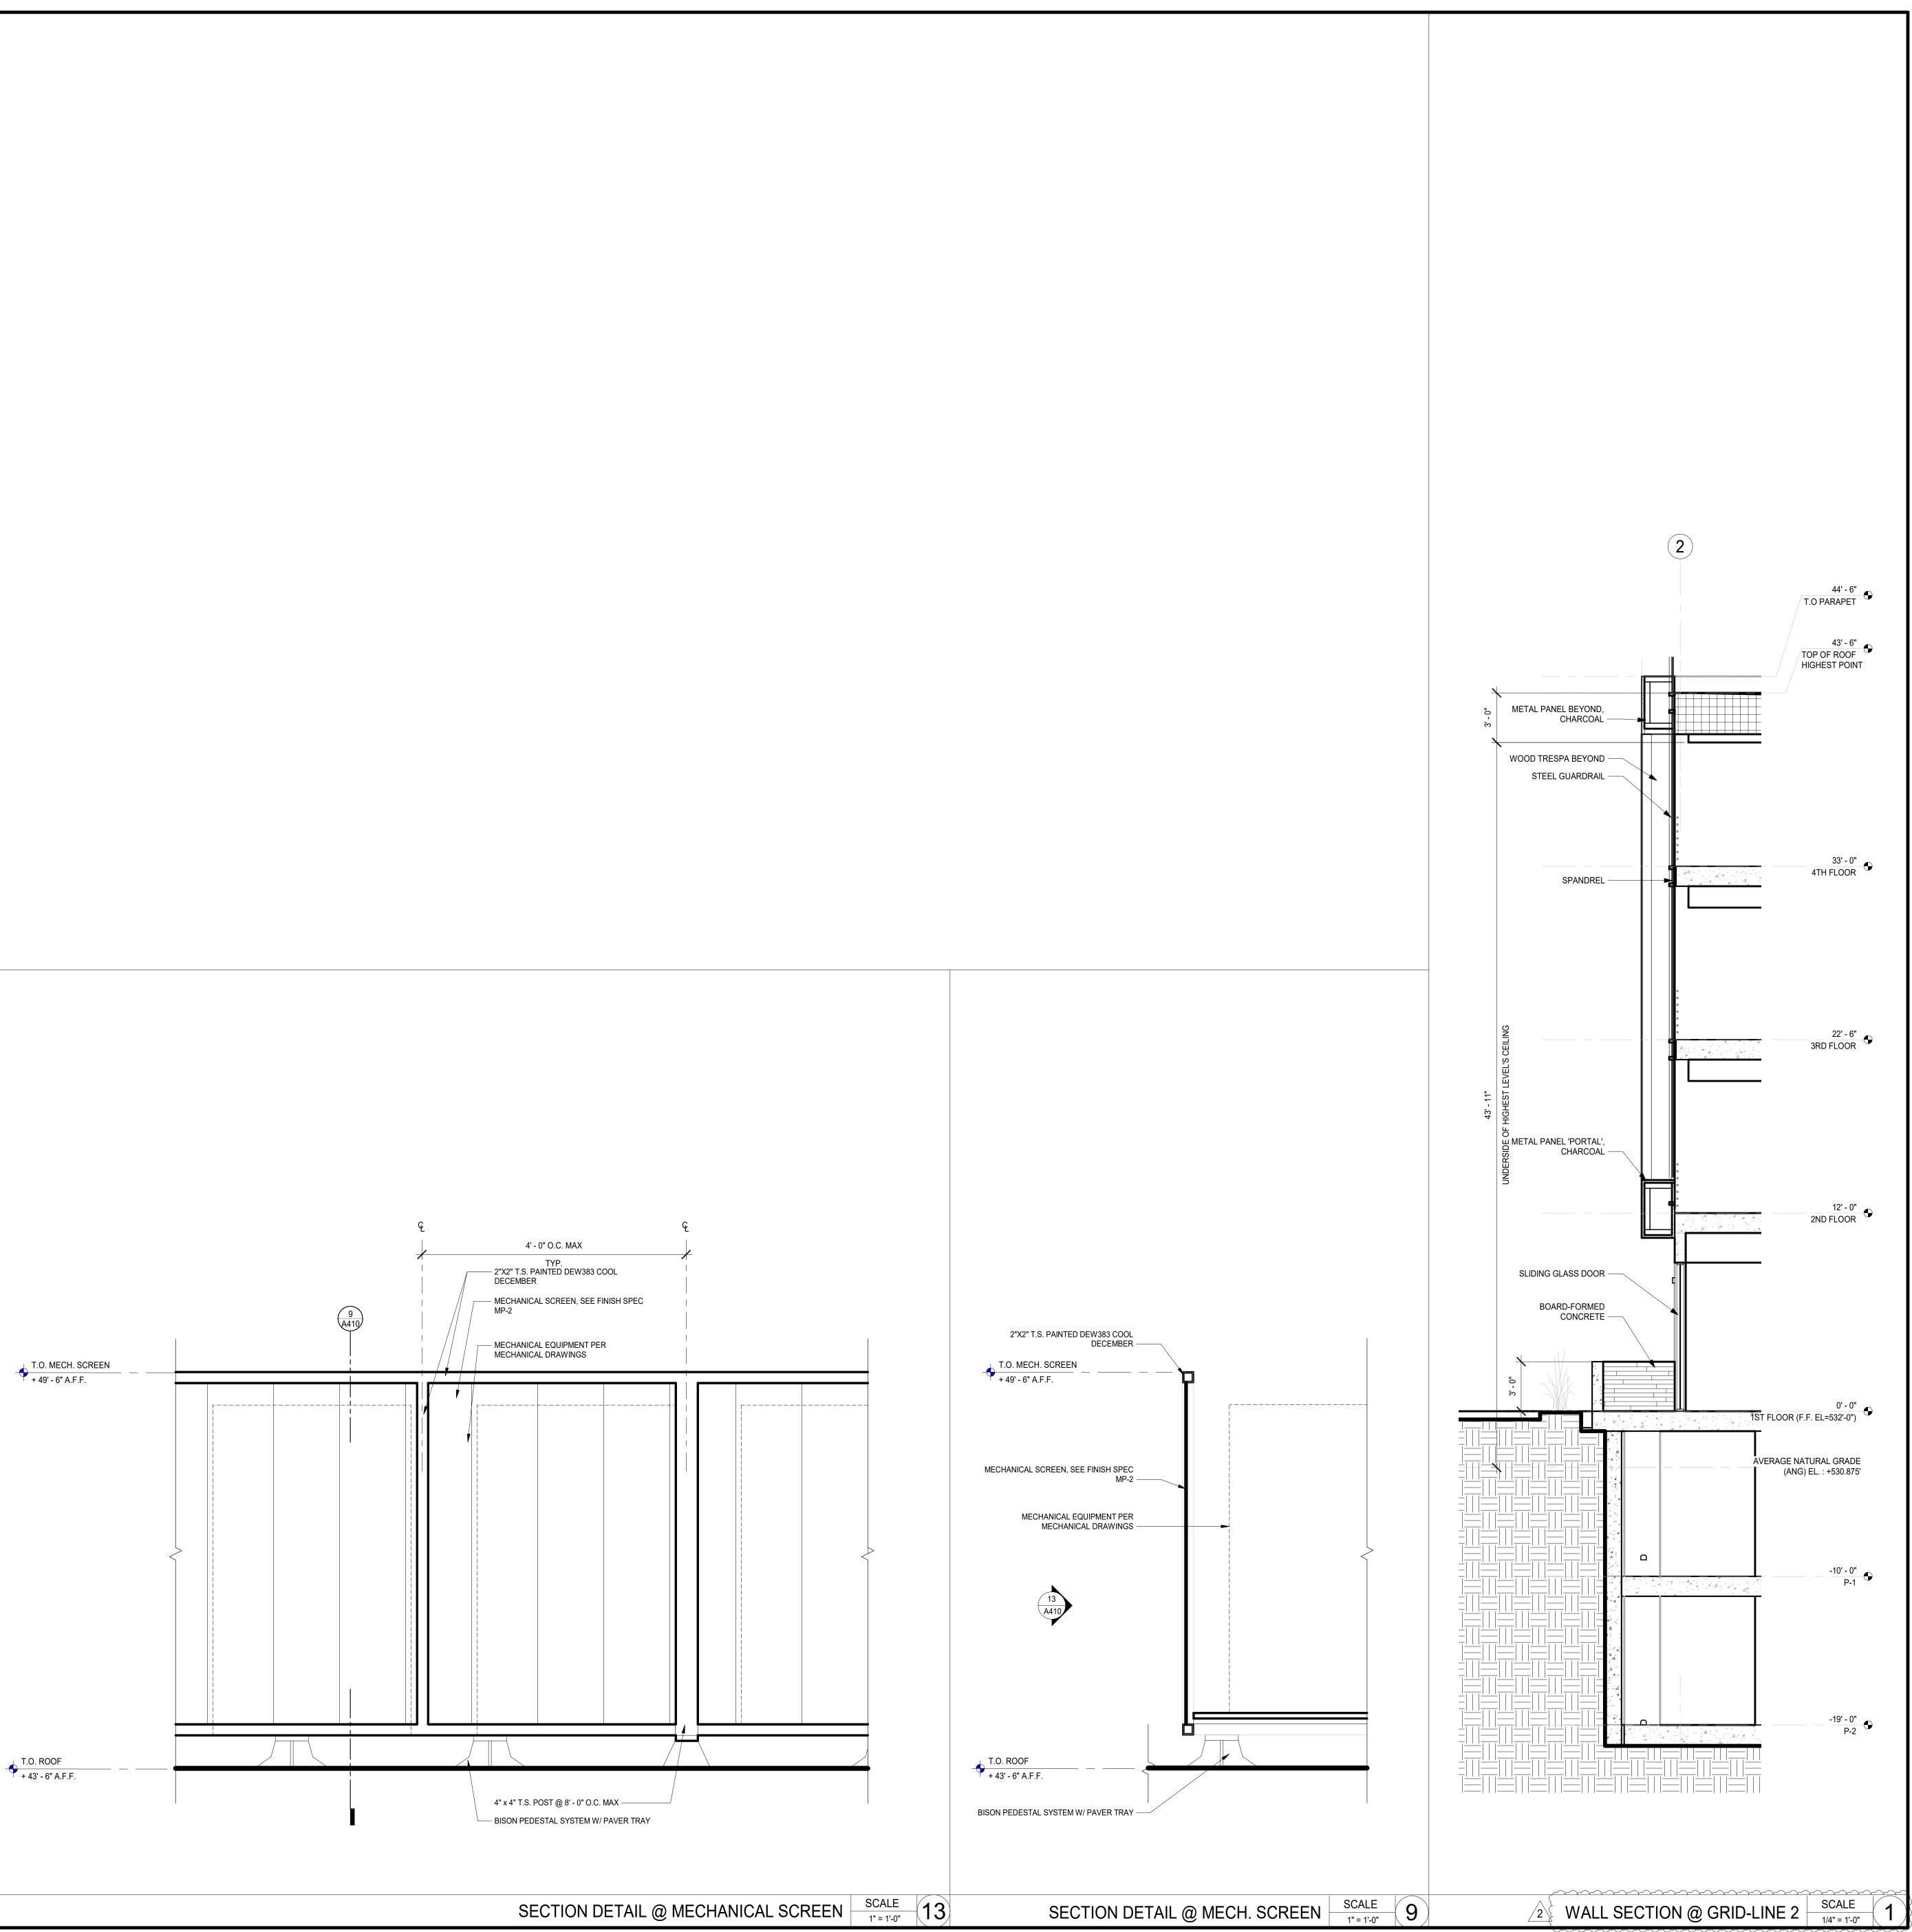


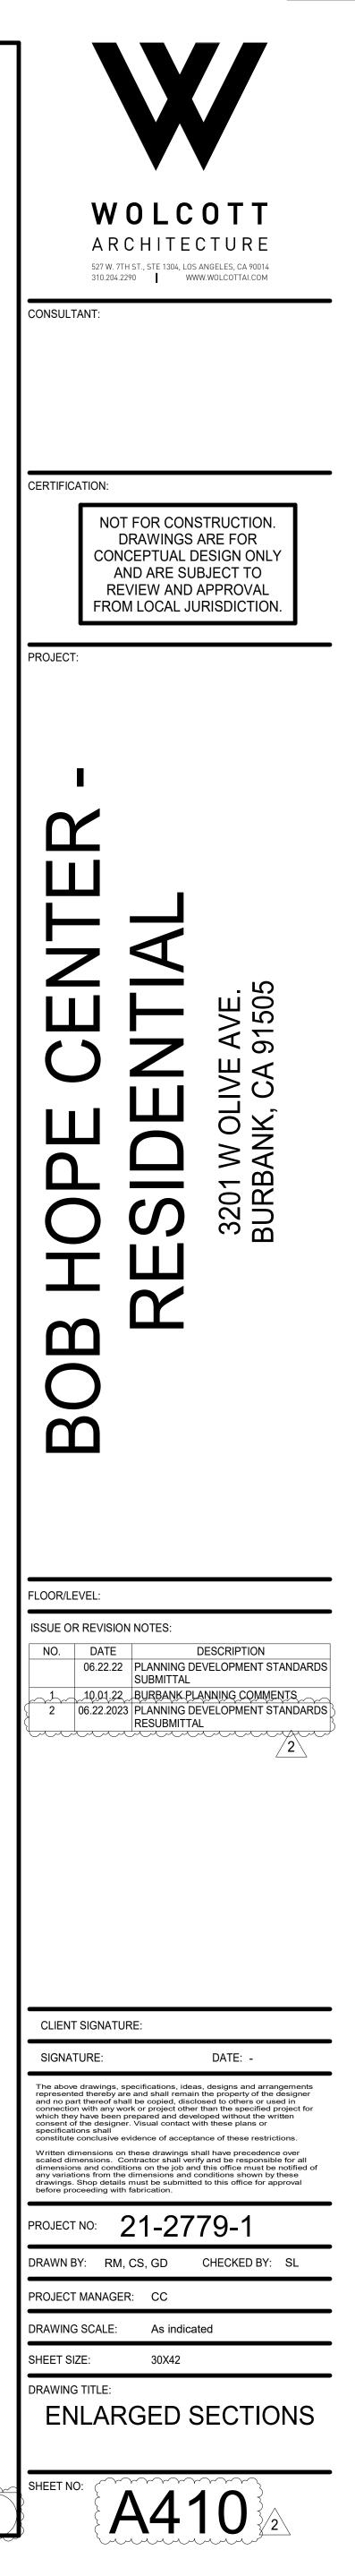


E NAME: Autodesk Docs://R22\_BHC-Residential/21-2779-1 BobHopeCenter-Resi.rvt




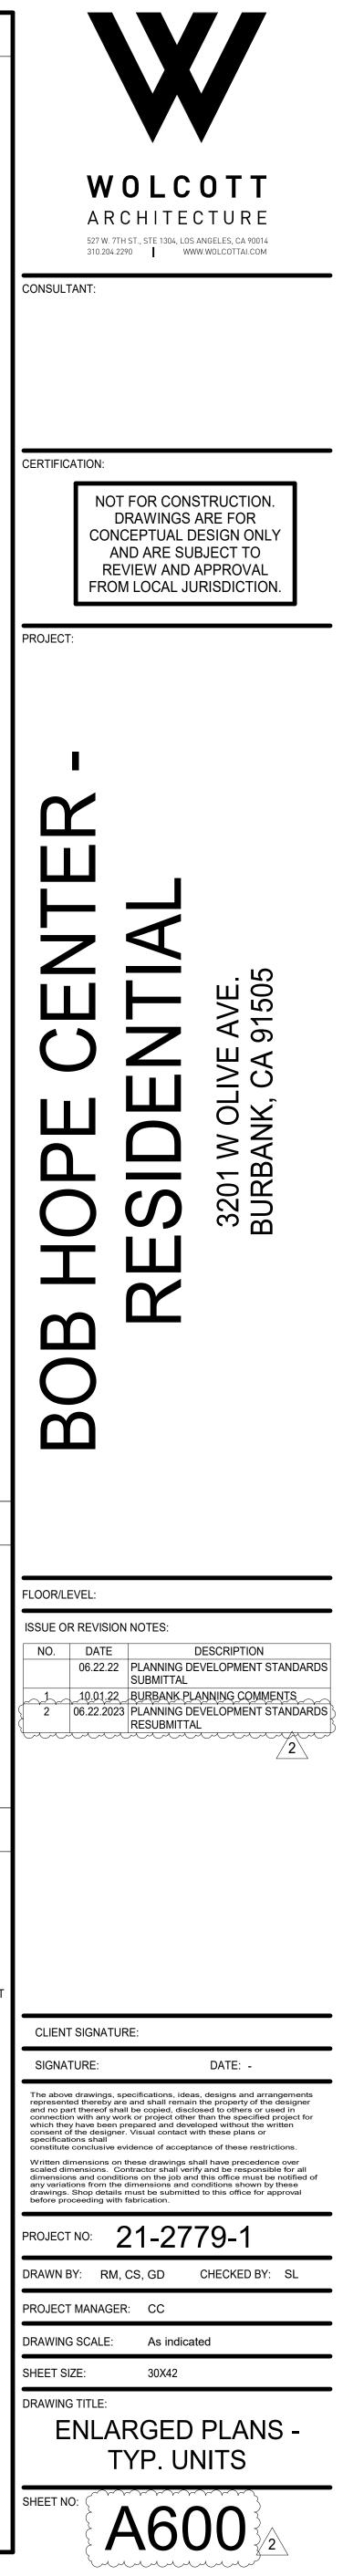

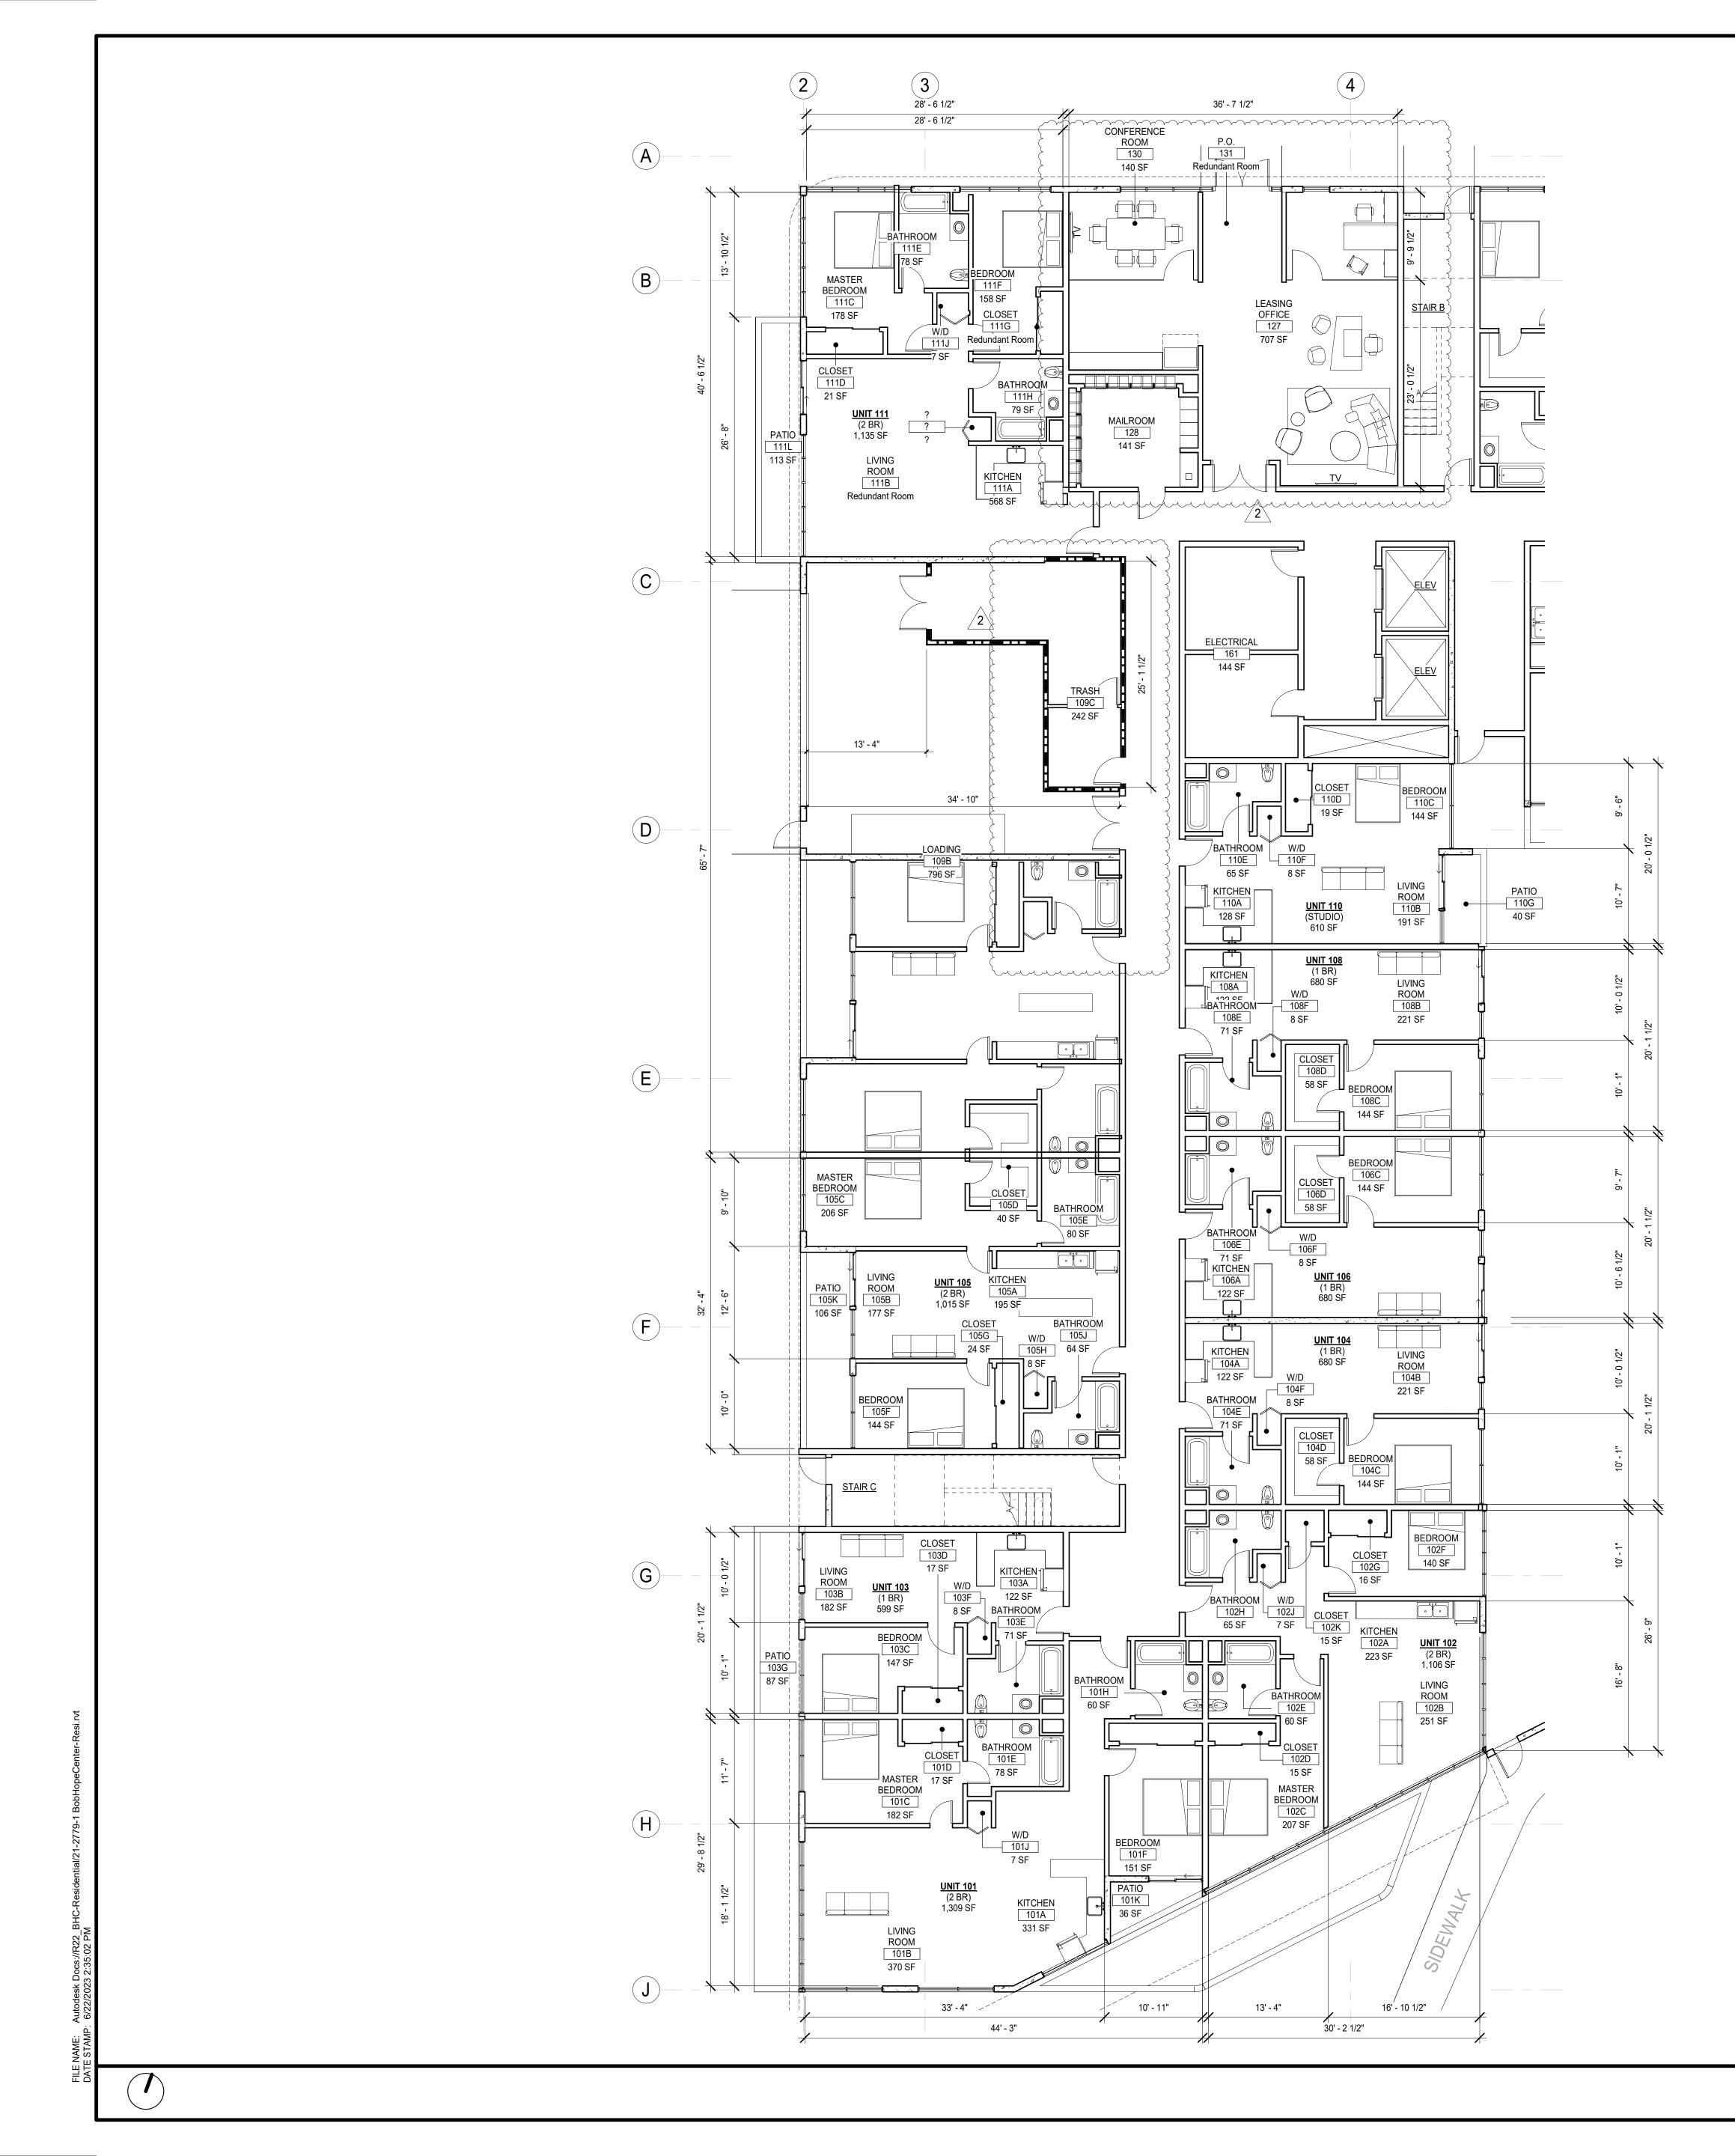


|                          |  |  | тго  |                              |
|--------------------------|--|--|--|------------------------------|
|                          |  | KEYNO  | IES  |                              |
|                          |  |  |  |                              |
|                          |  |  |  |                              |
|                          |  | KEYPLAN /  | AREA A   |                              |
|                          |  |  |  |                              |
|                          |  |  |  |                              |
|                          |  | GENERAL  | NOTES  |                              |
|                          |  | ND A004 FOR GENERAL NOTES.   |  |                              |
|                          | 3. ALL WORK SHALL CO<br>AUTHORITY.             | 01 FOR SYMBOLS AND ABBREVIATION<br>OMPLY WITH CURRENTLY ADOPTED IC<br>VIMENSIONS OR OBJECTS OF ANY KINI    | C, NFPA, IAPMO, ASME B                         |                              |
|                          | CONTRACTOR SHALL<br>SUBSEQUENT WORK            | L VERIFY ALL CONDITIONS AND DIMEN<br>C. CONTRACTOR SHALL BRING ANY DIS<br>TION PRIOR TO PROCEEDING WITH AI | SIONS IN THE FIELD BEF<br>SCREPANCIES OR CLARI | ORE PROCEEDING WITH          |
|                          | 5. ALL DIMENSIONS AR                           | E TO FACE STUD U.O.N. FINISH FLOOF<br>NCRETE UNDERLAYMENT U.O.N. CEILI                                     | R ELEVATIONS ARE TO TO                         |                              |
|                          | MATERIALS ARE INST<br>7. ALL FRAMING MEMBE     | ERS SHALL BE SO ARRANGED AND SP  | PACED AS TO PERMIT INS                         | TALLATION OF PIPE            |
|                          | STIFFENERS, BRACE<br>ALL WALL MOUNTED          | TWORK WITH A MINIMUM OF CUTTING<br>S, BACK-UP PLATES AND SUPPORTING<br>OR SUSPENDED MECHANICAL AND E       | G BRACKETS AS REQUIR                           | ED FOR THE INSTALLATION OF   |
|                          | SECTION 2303.2. WO                             | IN EXTERIOR WALLS TO BE FIRE-RET<br>OD FRAMING TO INCLUDE, BUT NOT L                                       |  |                              |
|                          | 9. ADJUST FRAMING CO                           | ATES, TOP PLATES, ETC.<br>DNFIGURATION AT ALL FAN COIL UNIT<br>D ASSEMBLY. REFER TO MECHANICA              |  |                              |
|                          | 10. ALL WOOD FRAMING<br>11. ALL FINISH WALL SU | IN CONTACT WITH CONCRETE IS TO<br>RFACES TO BE FLUSH U.O.N. PROVIDE<br>WALLS AND CEILINGS TO BE TAPED,     | E FURRING AS REQUIRED                          | D.                           |
|                          | 13. REFER TO SHEET A8<br>14. REFER TO SHEET A7 |  | S AND WINDOW SCHED                             | ULE AND DETAILS.             |
|                          | SCHEDULES.<br>16. ALL LIGHTING TO BE           | SHIELDED TO ELIMINATE GLARE ONT  | O ADJACENT PROPERTIE                           | ES PER BMC 10-1-2017 (H) (1) |
|                          | 17. (NOT USED)<br>18. LIGHTS CONFORMIN         | Y PER BMC 10-1-2017 (G)(2)<br>G TO STANDARDS PRESCRIBED BY TH  |  |                              |
|                          | 10-1-1420.<br>19. PER TABLE N-5 OF TH          | NG LOTS USED FOR PUBLIC PARKING<br>HE BURBANK 2035 GENERAL PLAN TH   | IS PROJECT WILL BE COM                         | NSTRUCTED IN A WAY TO        |
|                          | TRANSPORTATION S<br>20. THIS PROJECT WILL      | NOISE LEVELS US 45DBA MAX. PER TA<br>OURCES OF THE GENERAL PLAN.<br>BE CONSTRUCTED INCORPORATING I         | BUILDING DESIGN FEATU                          | IRES THAT MINIMIZE THE       |
|                          | AND ENERGY CODES                               |  |  |                              |
|                          |  | LEGE   | ND   |                              |
|                          | N.I.C.   | NOT IN CONTRACT  | ALIGN  | ALIGN ELEMENTS               |
|                          |  | EXISTING MILLWORK  | RM NAME<br>#                                   | ROOM NAME AND NUMBER         |
|                          |  | NEW MILLWORK   | F.E.C.   | FIRE EXTINGUISHER CABINET    |
|                          |  | NEW WILLWORK   |  | FIRE EXTINGUISHER CABINET    |
|                          |  | EXISTING PARTITION   |  | NEW PLUMBING FIXTURES        |
|                          |  | EXISTING DOOR  |  |                              |
|                          | C#   | — WALL TAG. REFER TO A800  |  |                              |
|                          |  | NEW PARTITION PER PLAN   |  |                              |
|                          | 4" TYP.  |  |  |                              |
|                          |  | NEW DOOR   |  |                              |
|                          |  |  |  |                              |
|                          | < 1001 >                                       | DOOR NUMBER. REFER TO A700   |  |                              |
|                          | √##>   | — WINDOW TAG. REFER TO A700  |  |                              |
|                          |  | NEW GLAZING OR STOREFRONT<br>SYSTEM PER SCHEDULE.  |  |                              |
|                          | $\langle \overline{A} \rangle$                 | NEW PLUMBING FIXTURE,<br>APPLIANCE, OR EQUIPMENT.  |  |                              |
| AREA A<br>1/8" = 1'-0" 1 |  | REFER TO A710  |  |                              |
| -                        | 1  |  |  |                              |

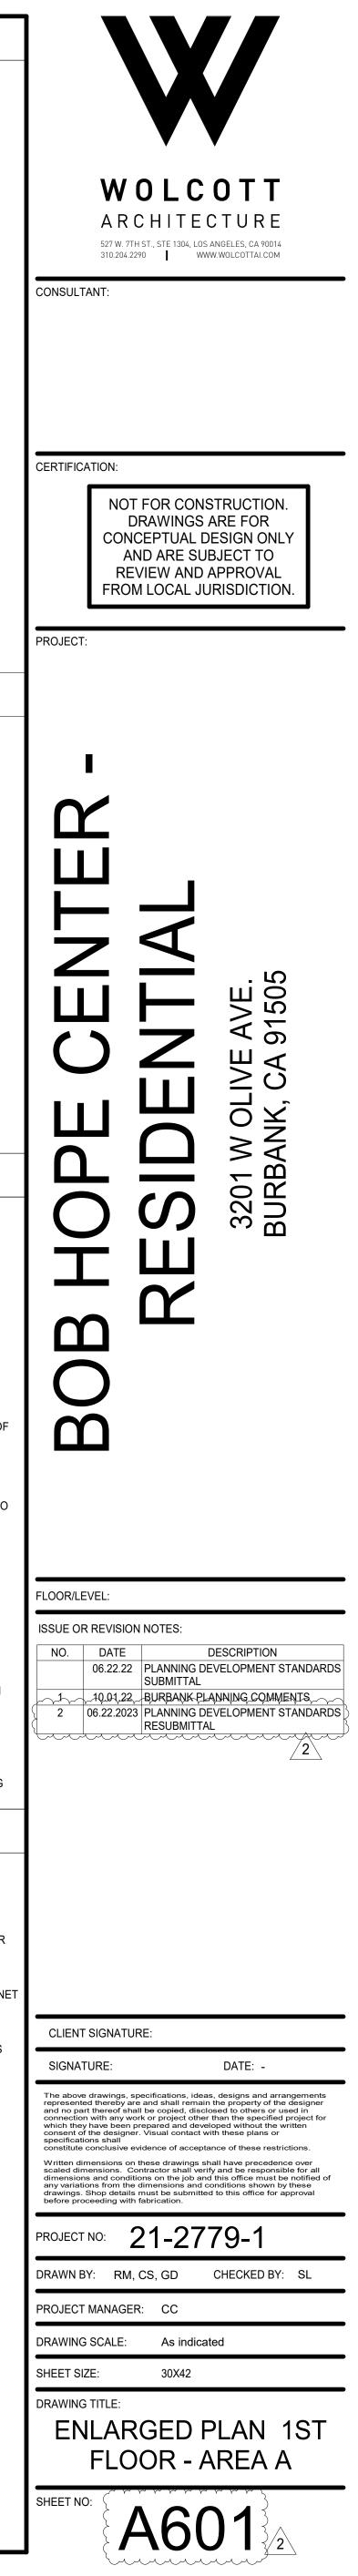


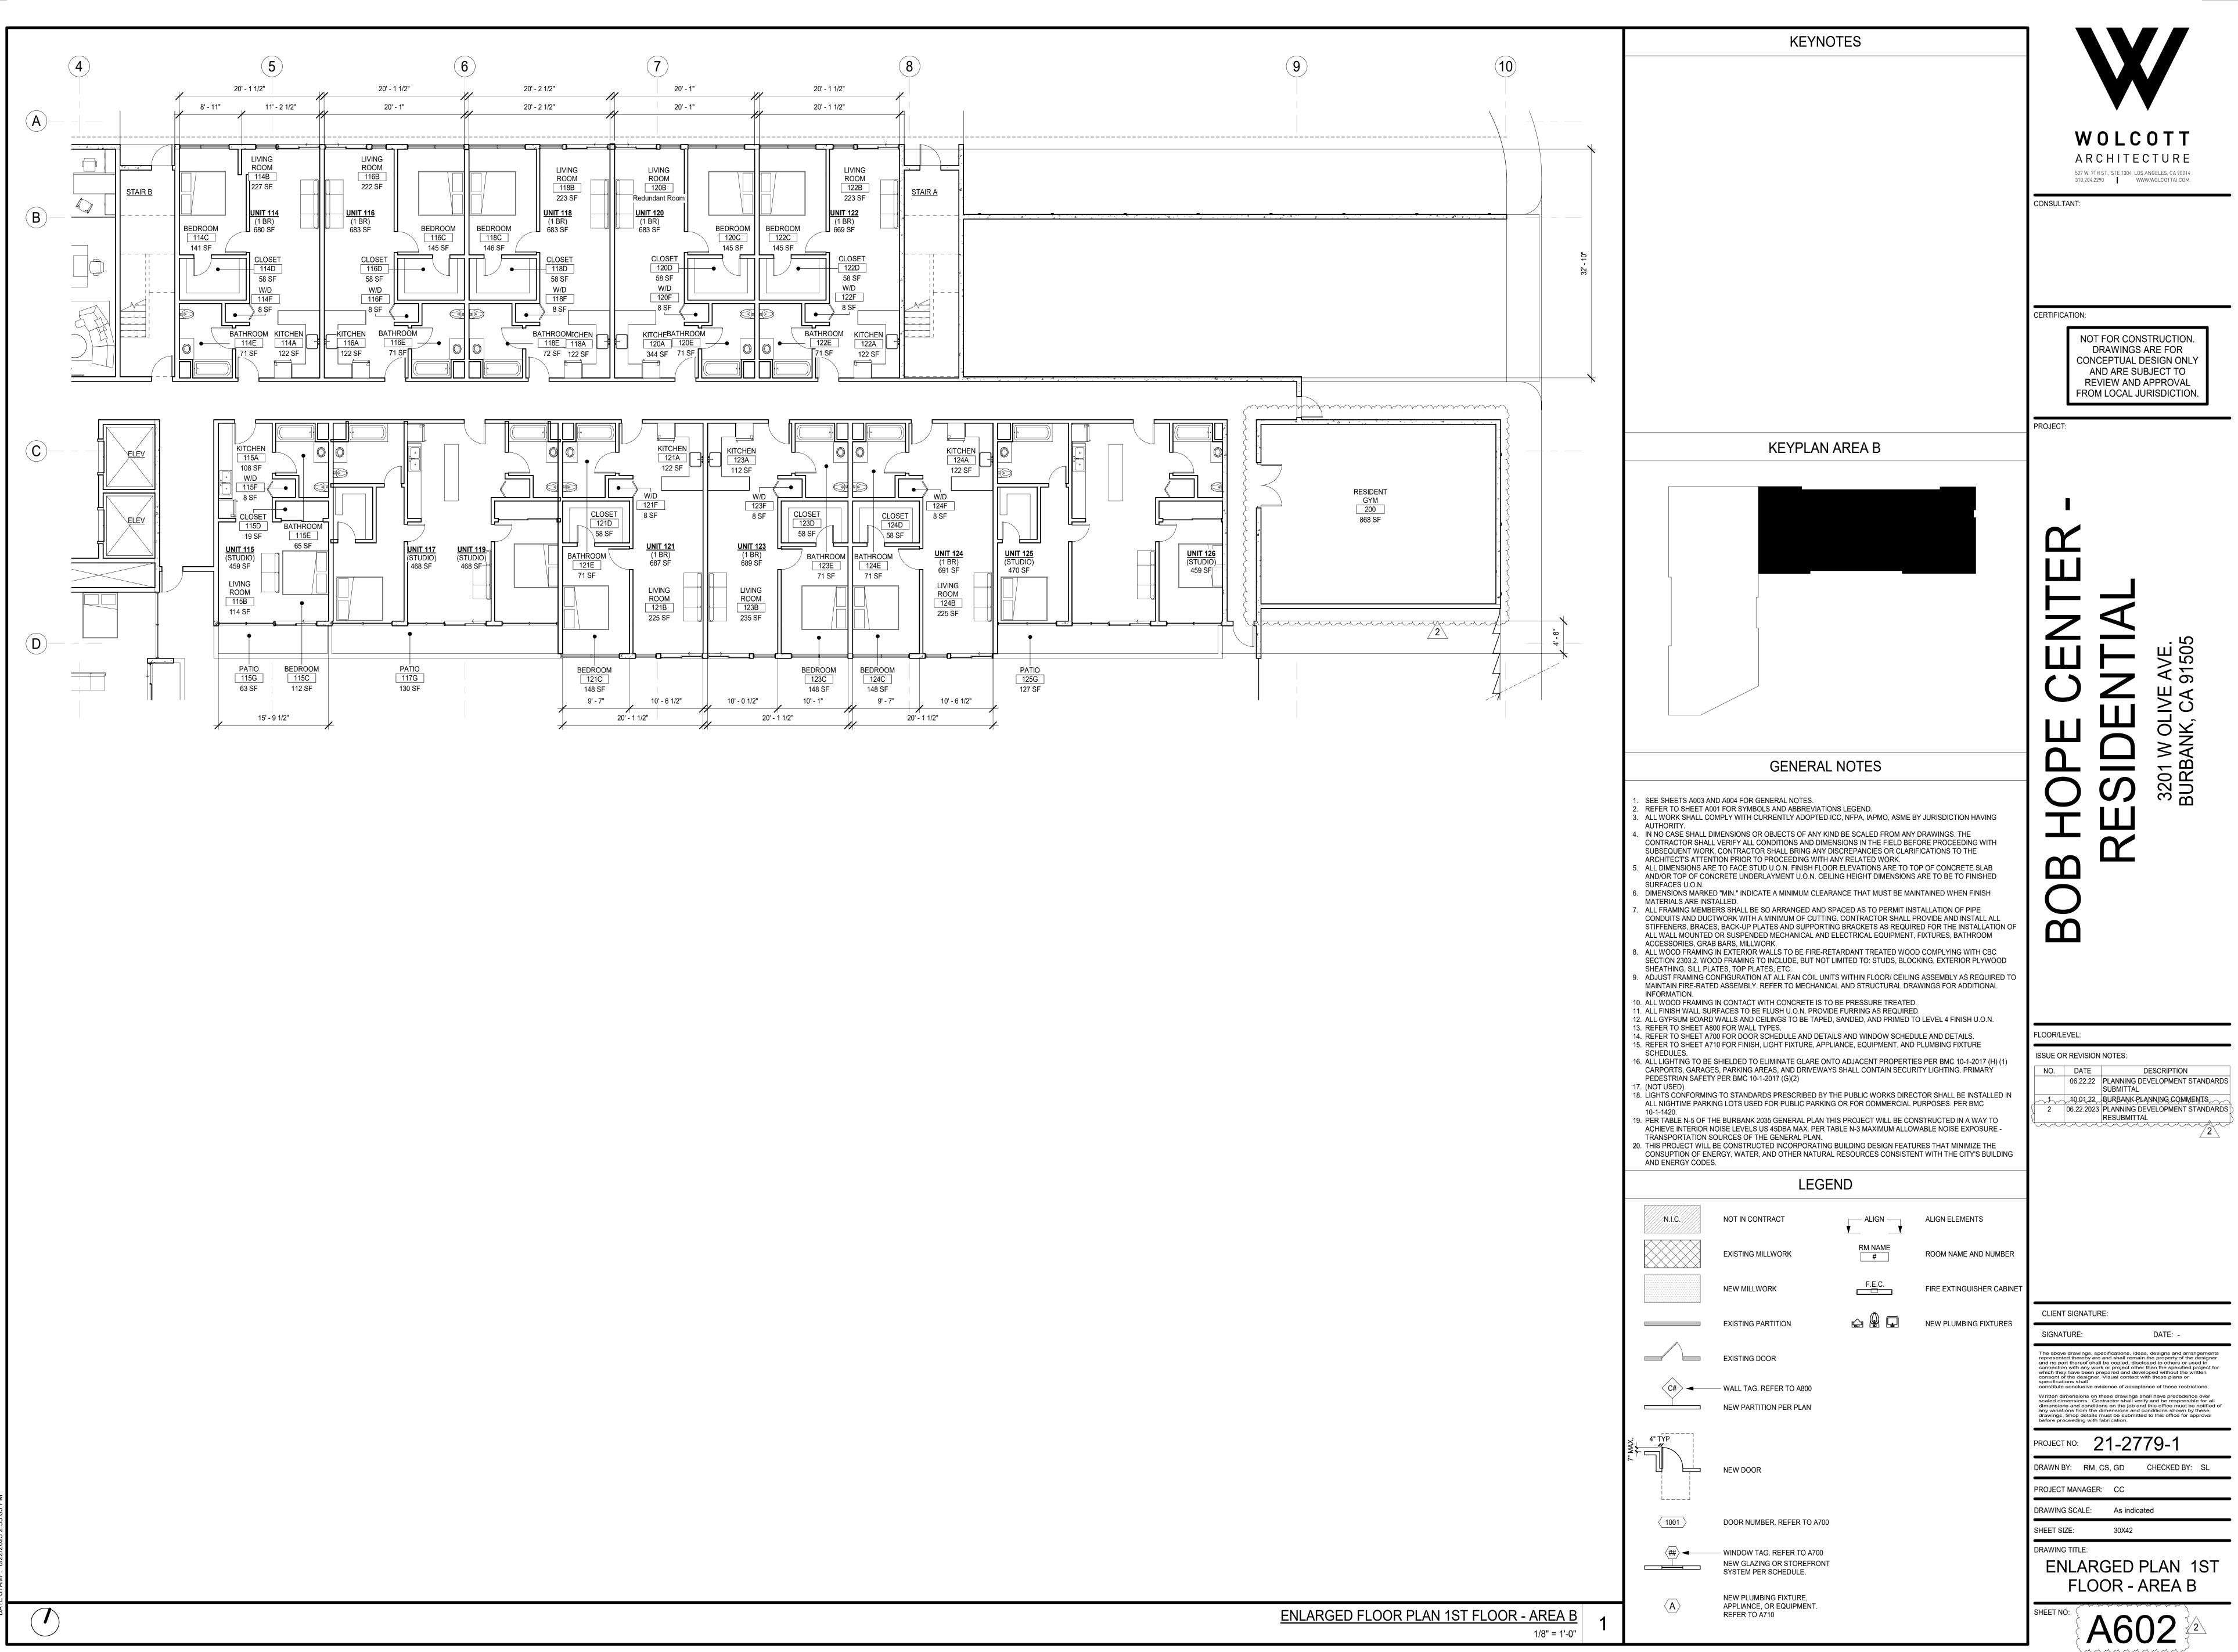




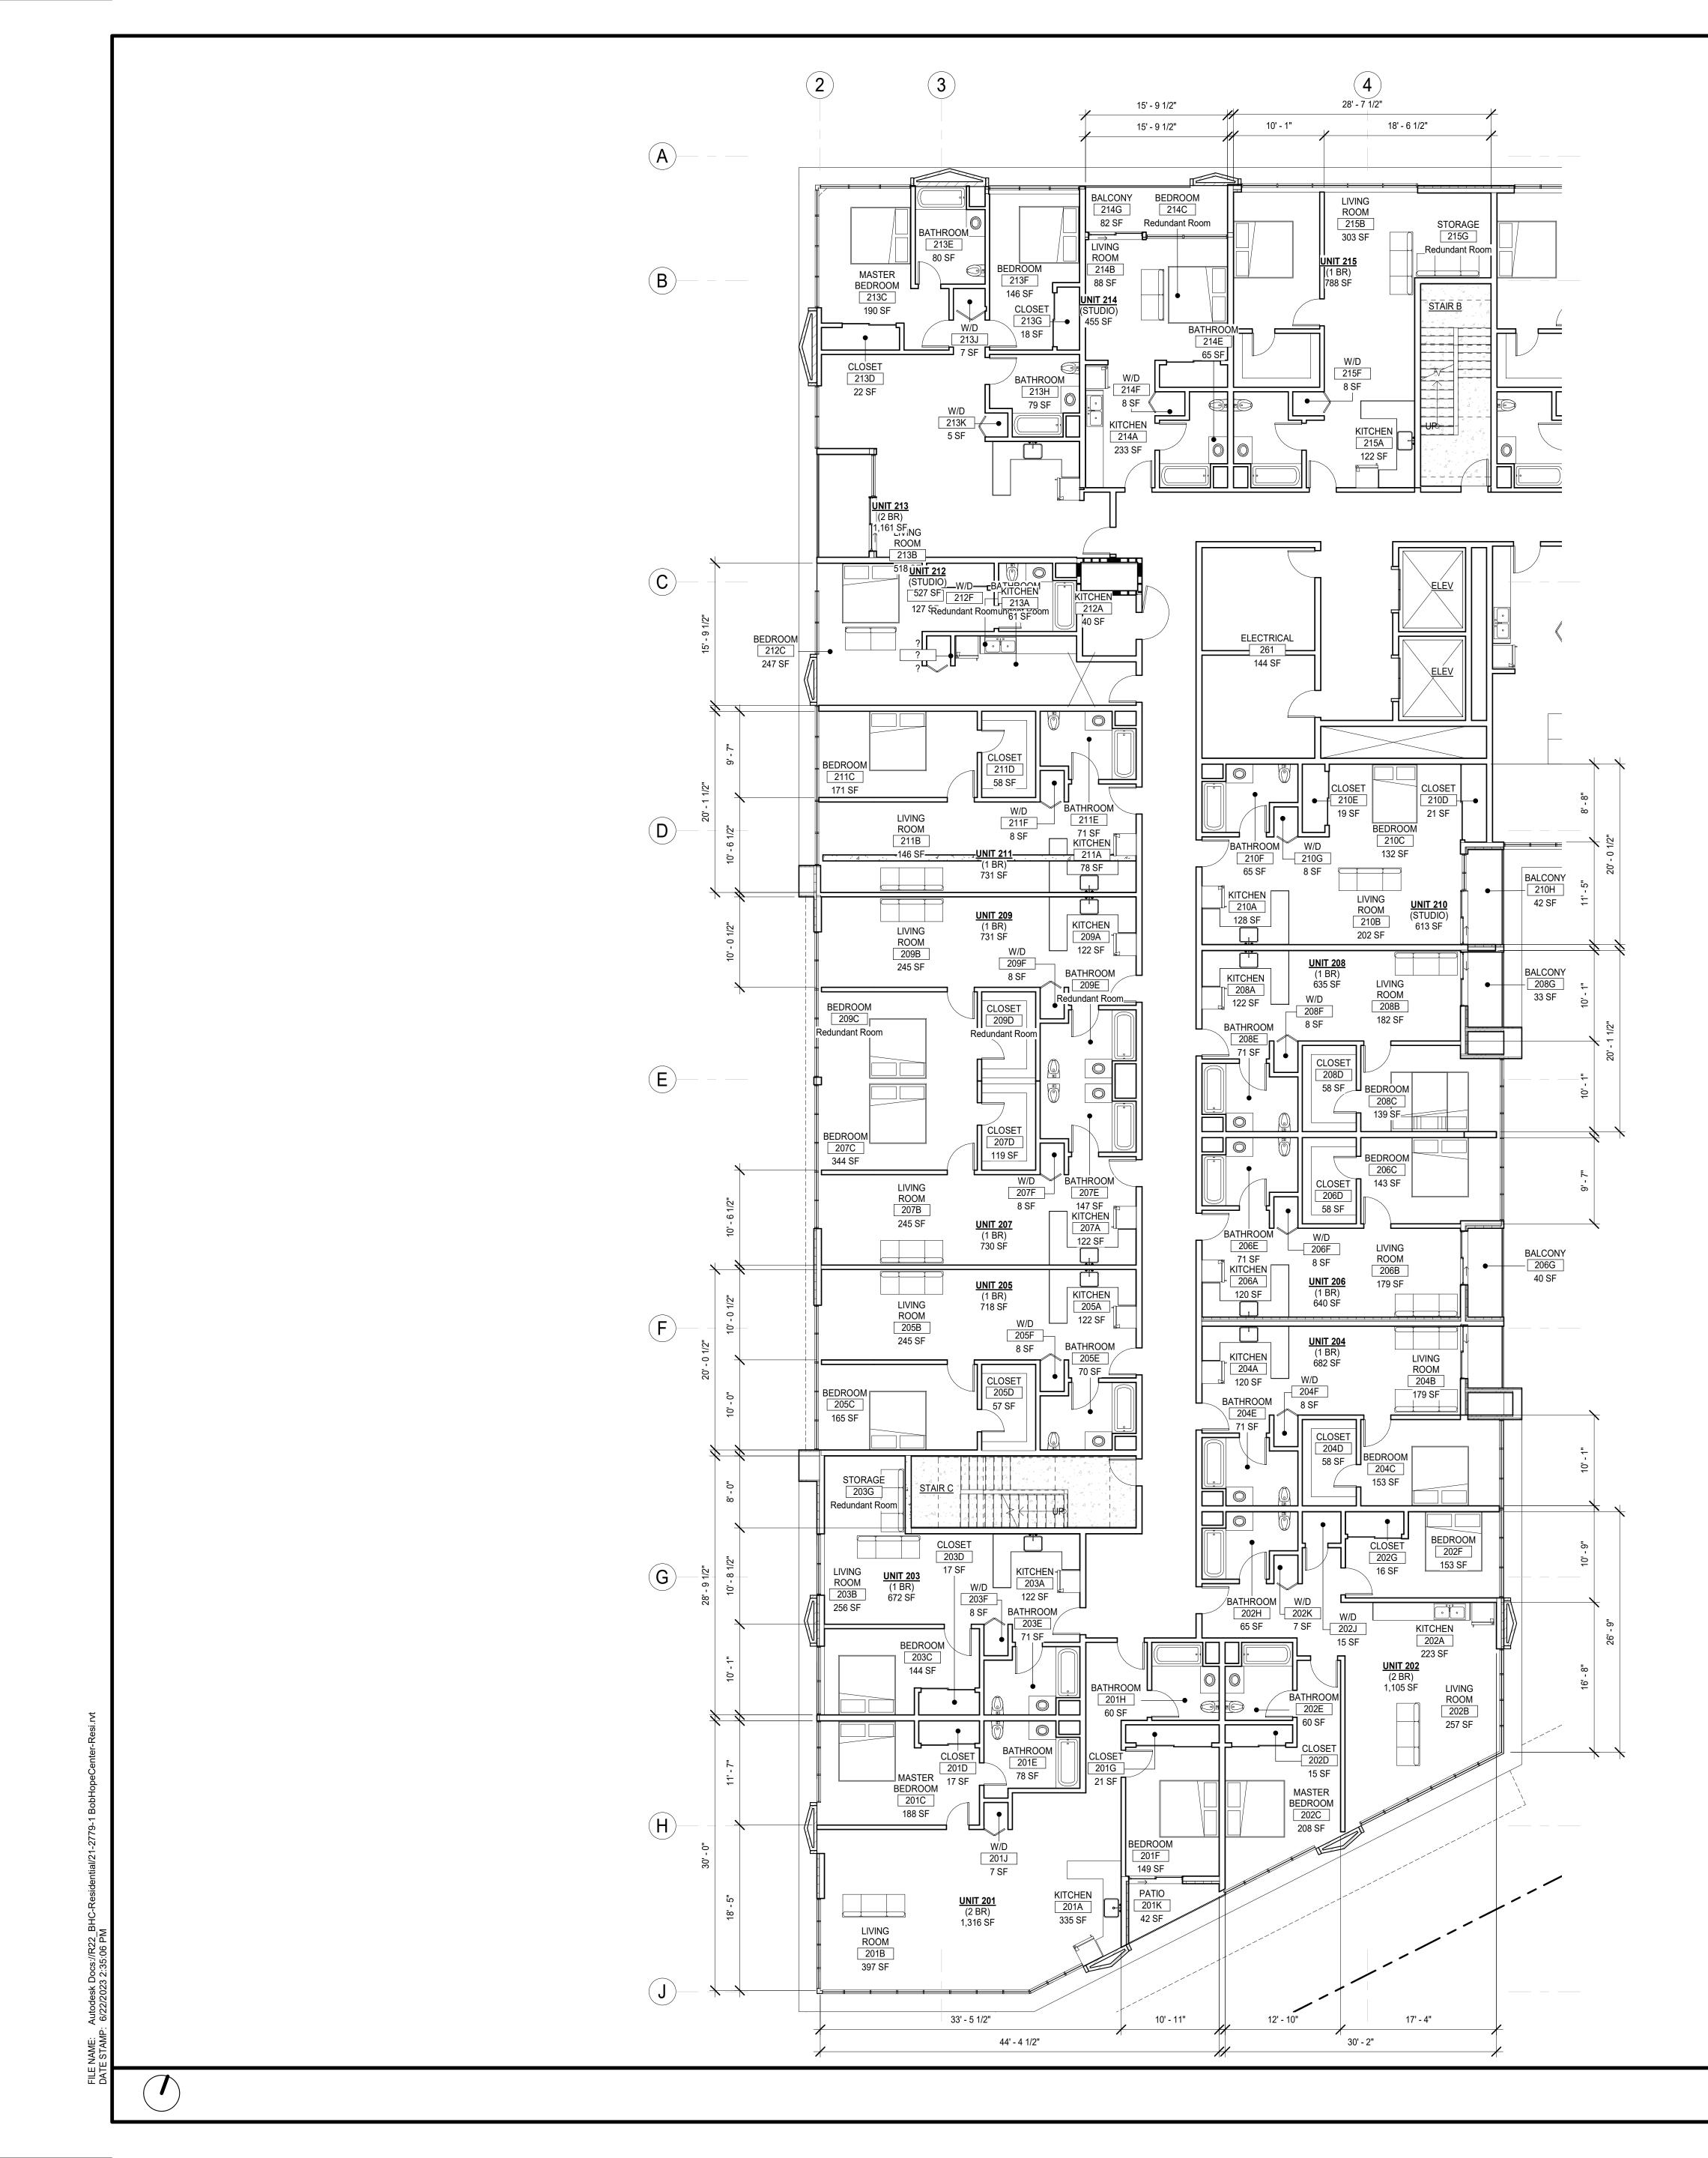


ENLARGED FLOOR PLAN 2ND FLOOR - AREA A

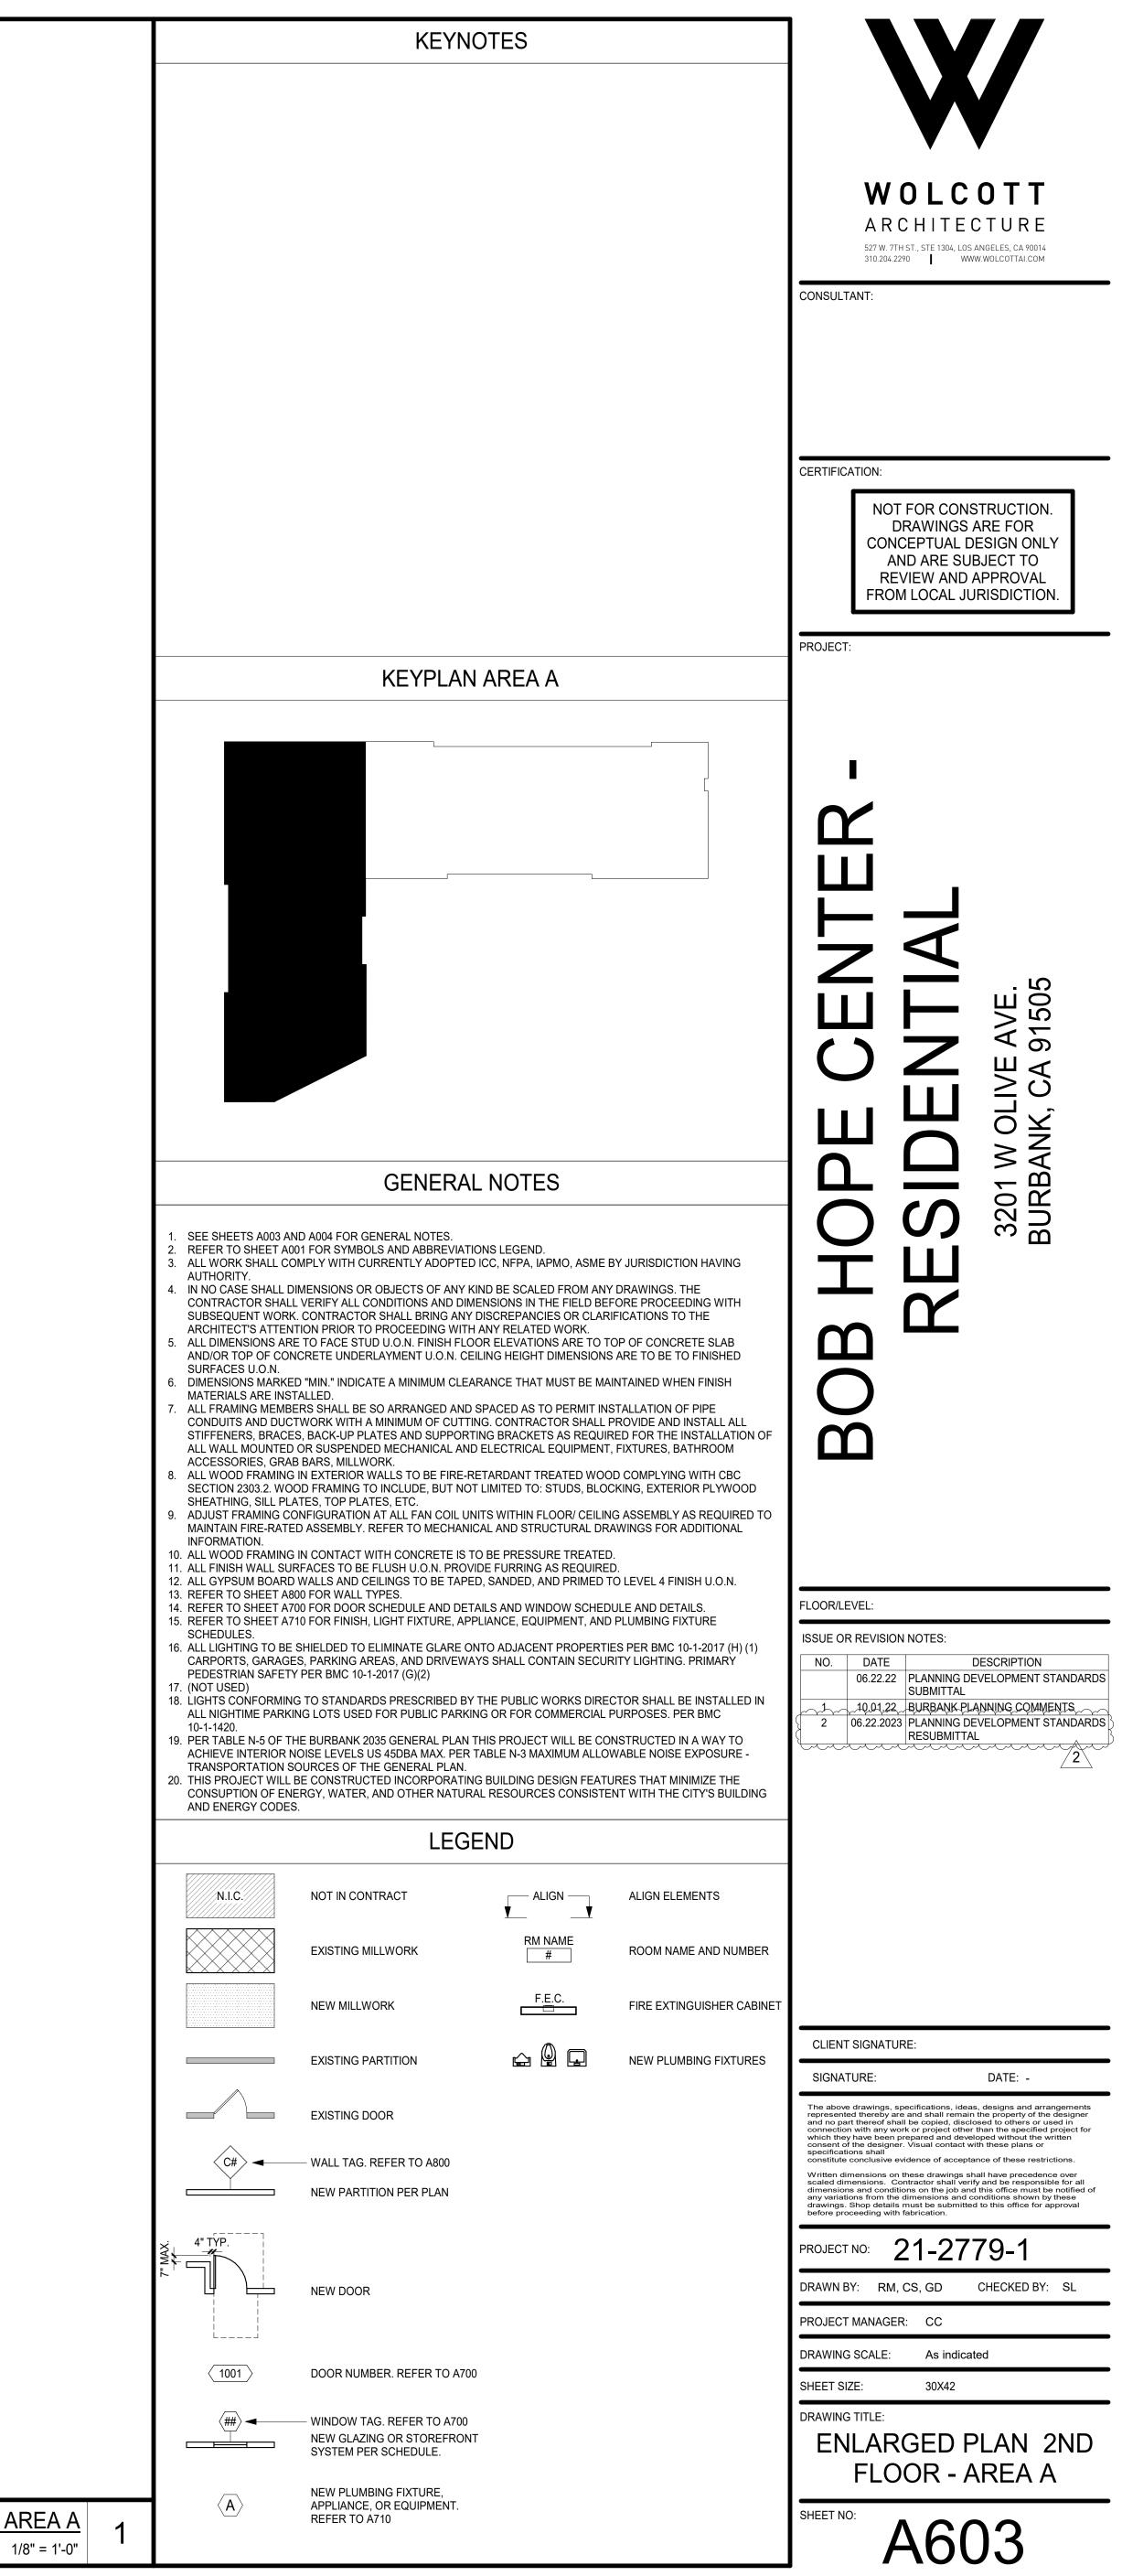

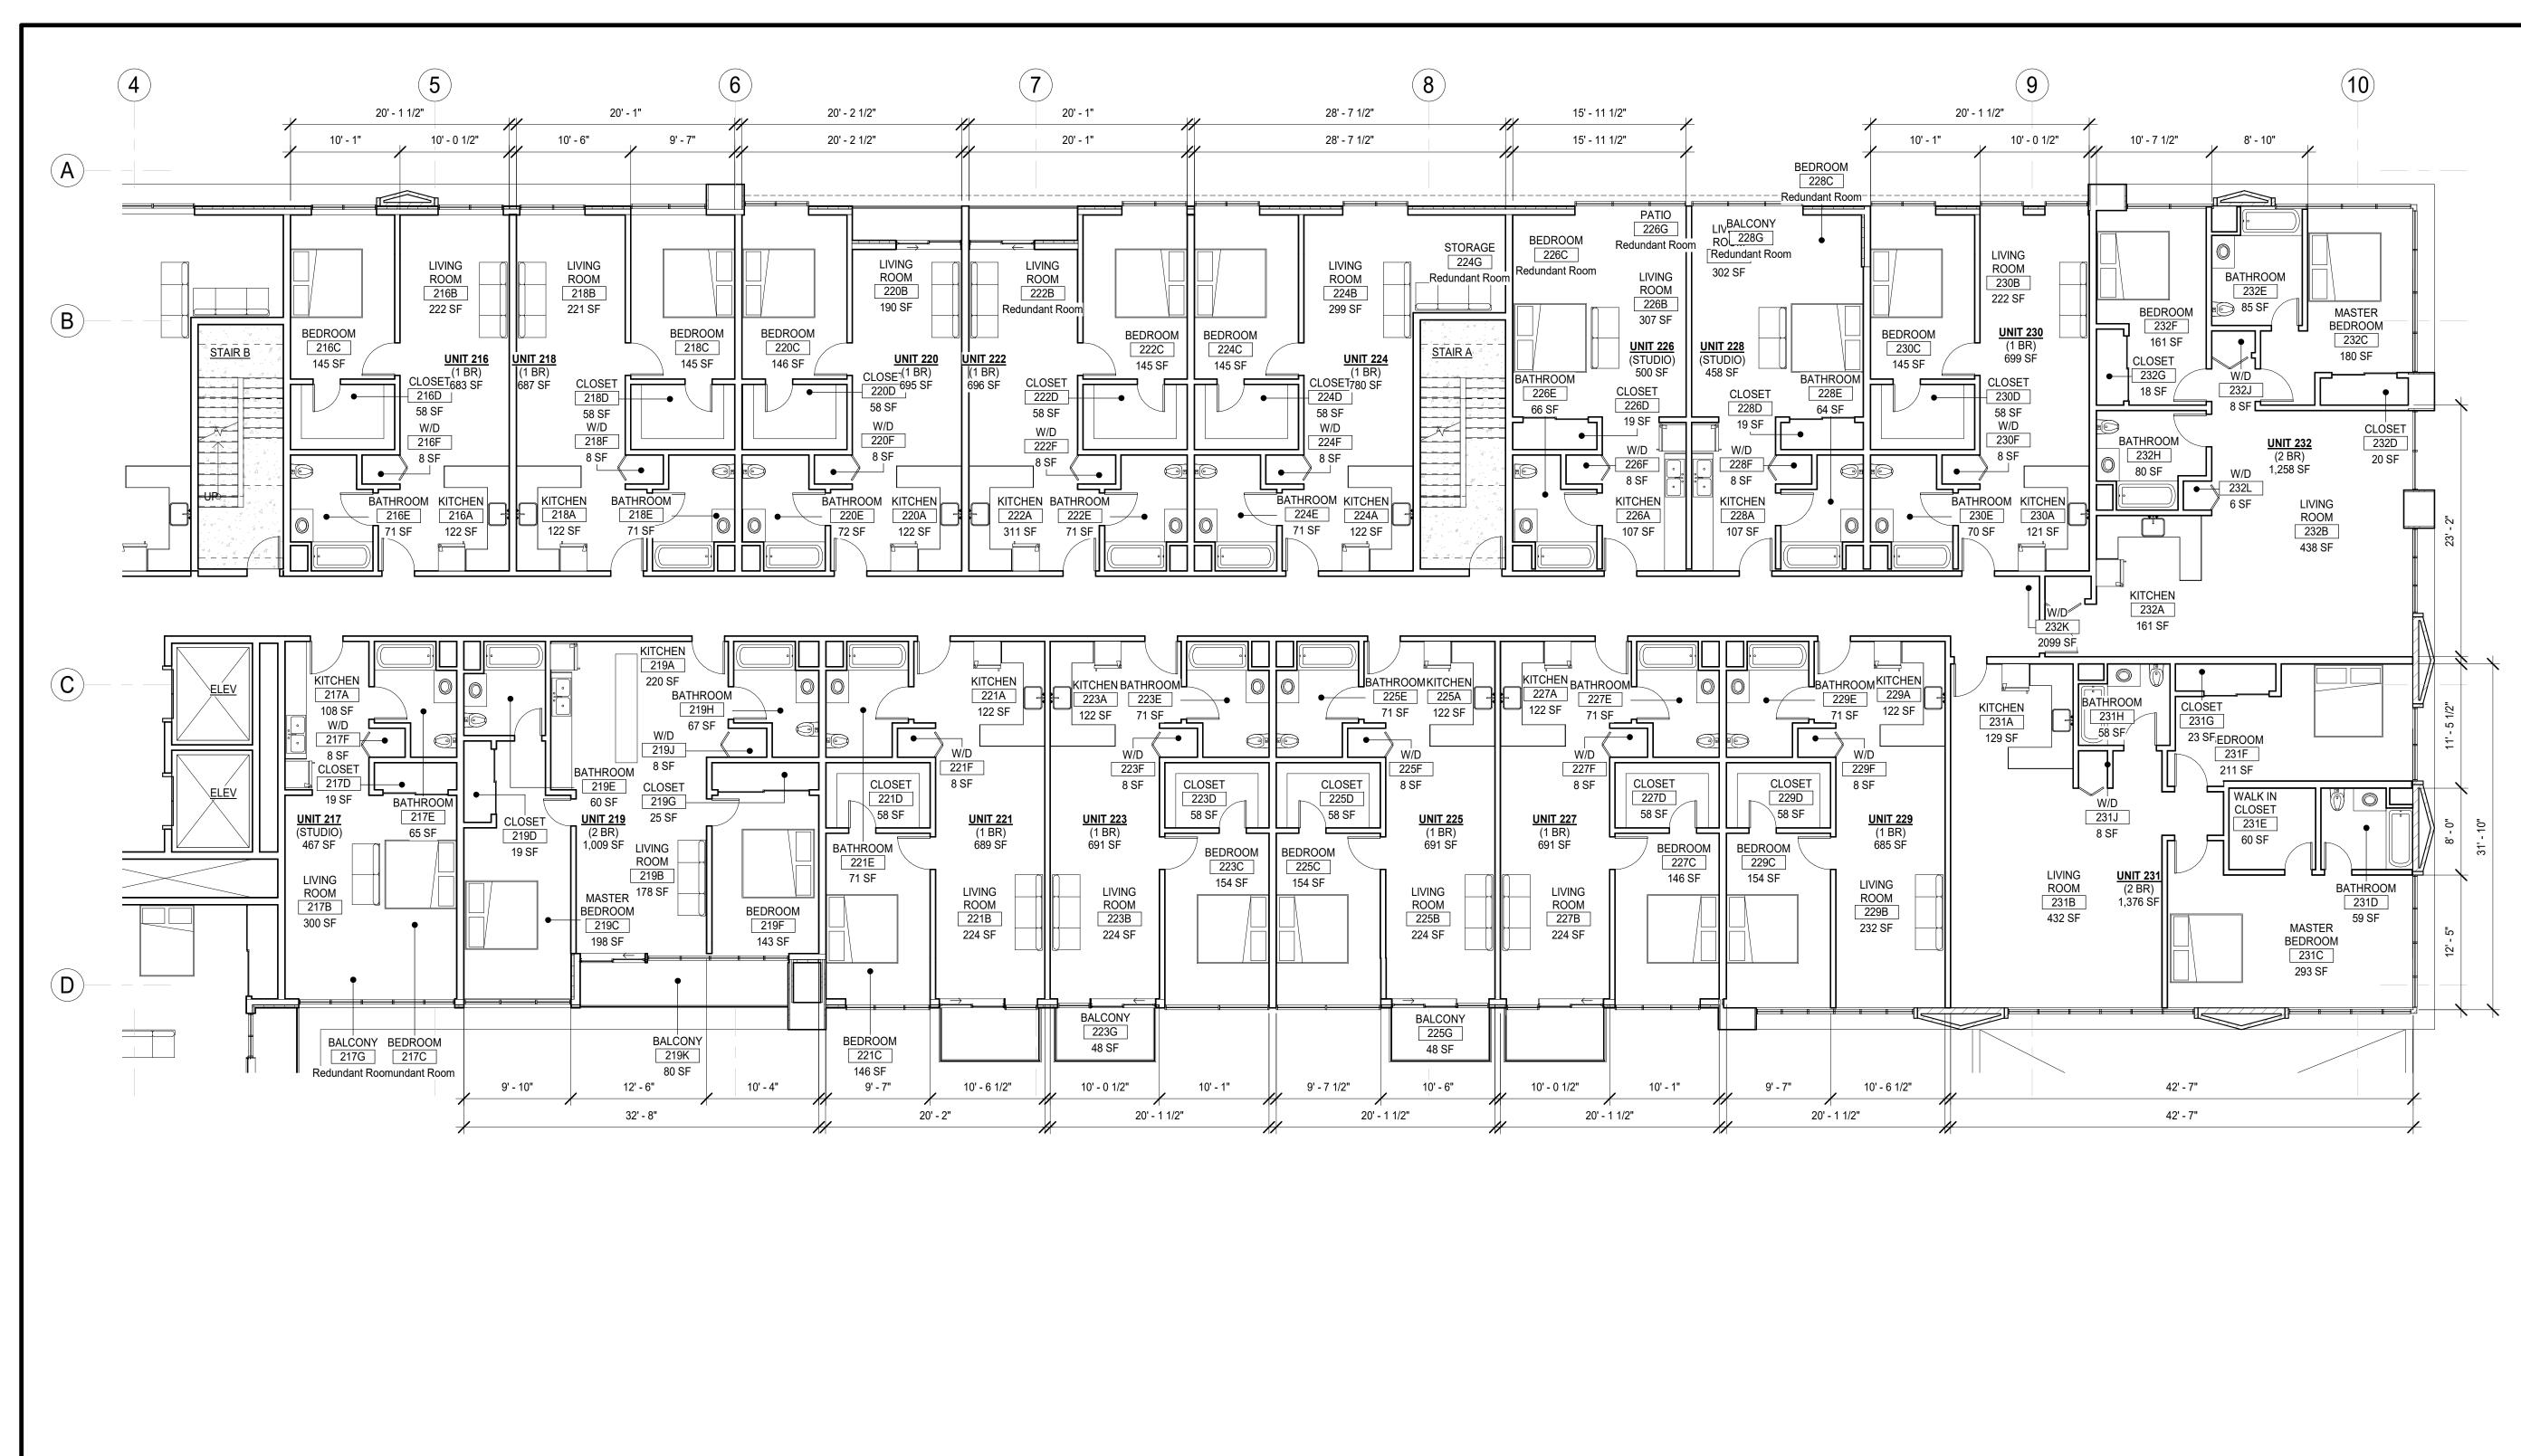




 $\frown$ 

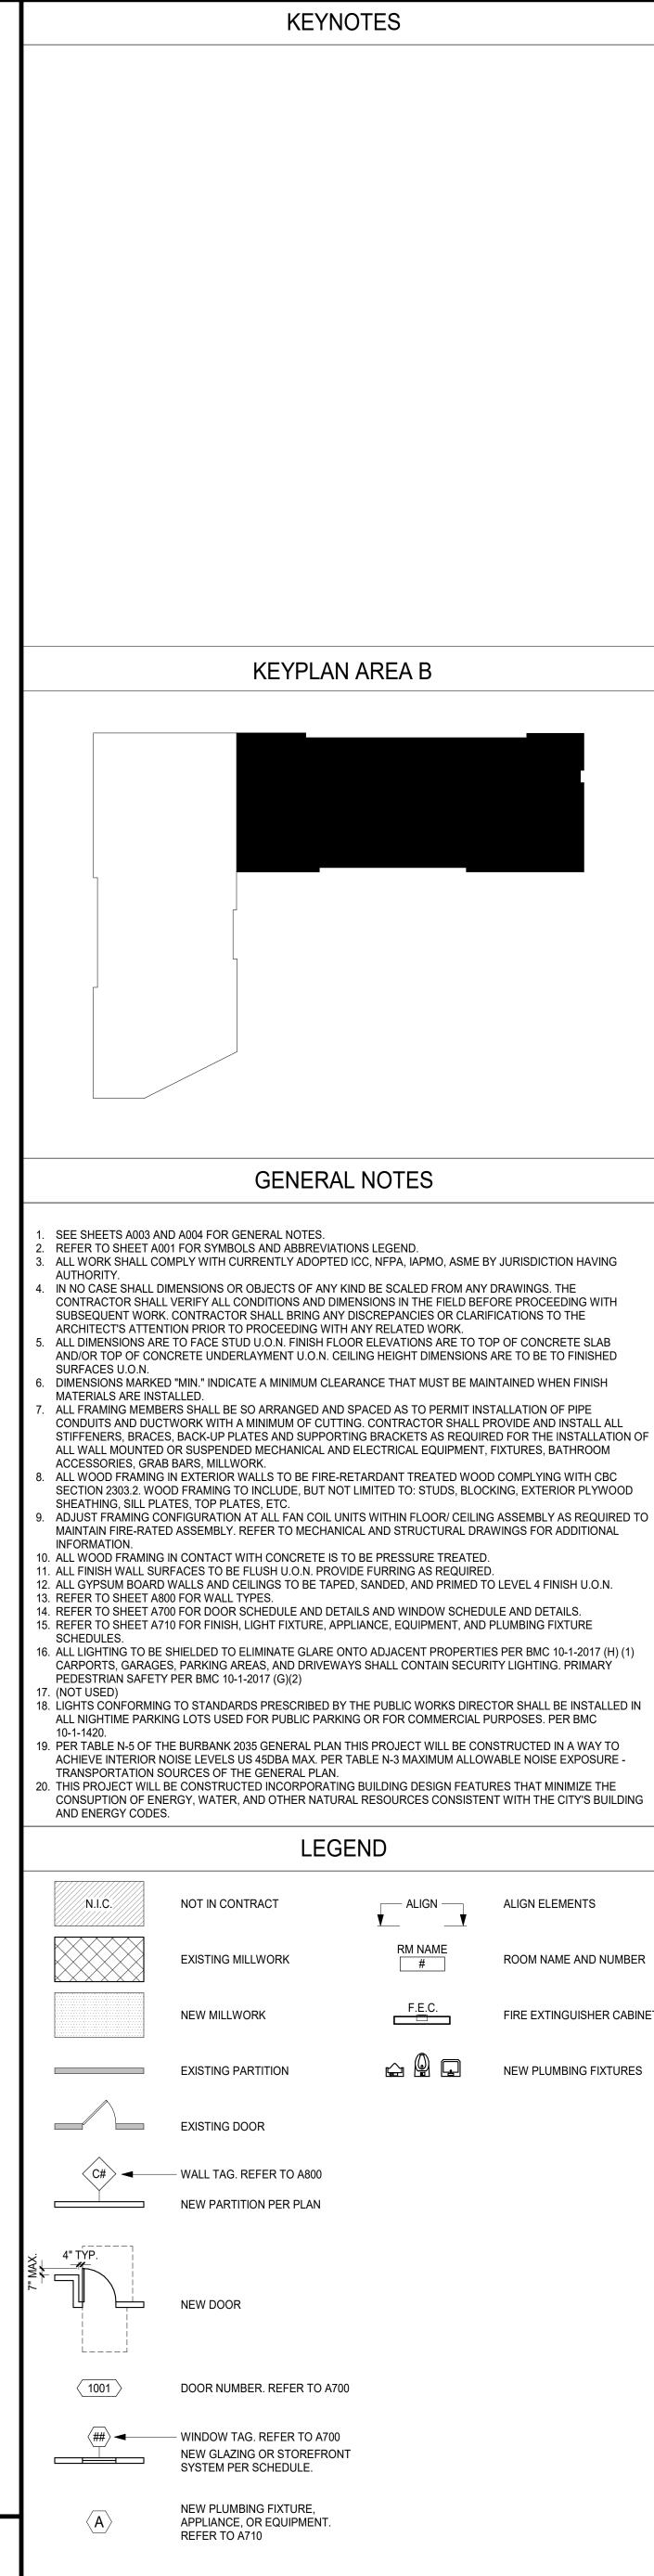


ENLARGED FLOOR PLAN 2ND FLOOR - AREA B 1/8" = 1'-0"


|     | <section-header></section-header>  |
|-----|--|
|     | DRAWINGS ARE FOR<br>CONCEPTUAL DESIGN ONLY<br>AND ARE SUBJECT TO<br>REVIEW AND APPROVAL<br>FROM LOCAL JURISDICTION.  |
| F   | BOB HOPE CENTER -<br>RESIDENTIAL<br>3201 W OLIVE AVE.<br>BURBANK, CA 91505   |
|     | FLOOR/LEVEL:         SSUE OR REVISION NOTES:         NO.       DATE         DESCRIPTION         06.22.22       PLANNING DEVELOPMENT STANDARDS         1       10.01.22       BURBANK PLANNING COMMENTS         2       06.22.2023       PLANNING DEVELOPMENT STANDARDS   |
| IET | CLIENT SIGNATURE:         SIGNATURE:       DATE: -         The above drawings, specifications, ideas, designs and arrangements represented thereby are and shall remain the property of the designer, specifications, ideas, designs and arrangements and no part thereof shall be copied, disclosed to others or used in connection with any work or project other than the specified project for which they have been prepared and developed without the written connection with any work or project other than the specified project for which they have been prepared and developed without the written connection shall         Contactor shall verify and be responsible for adjustions from the exigner shall have precedence over specifications shall         Written dimensions on these drawings shall have precedence over stall definemistions and conditions shall verify and be responsible for adjustions from the dimensions and conditions shown by these drawings. Shop details must be submitted to this office must be notified of adjustions from the dimensions and conditions shown by these detaining and conditions shown by these detaining and conditions shown by these detains and conditins shown by these detains and conditins sh |
|     | PROJECT NO: 21-2779-1<br>DRAWN BY: RM, CS, GD: CHECKED BY: SL<br>PROJECT MANAGER: CC<br>DRAWING SCALE: As indicated<br>SHEET SIZE: 30X42<br>DRAWING TITLE:<br>ENLARGED PLAN 2ND<br>FLOOR- AREA B<br>SHEET NO:<br>A6604   |

|   | ~ 前於他的為於   |
|---|------------|
|   |            |
|   |            |
|   | WD-1 (WOOD |
| rvt   |            |
| er-Resi.rvt   |            |
| peCenter-Resi.rvt   |            |
| 1 BobHopeCenter-Resi.rvt  |            |
| 1-2779-1 BobHopeCenter-Resi.rvt   | WD-1 (WOOD |
| ential/21-2779-1 BobHopeCenter-Resi.rvt   |            |
| C-Residential/21-2779-1 BobHopeCenter-Resi.rvt  |            |
| 22_BHC-Residential/21-2779-1 BobHopeCenter-Resi.rvt<br>PM   |            |
| Jocs://R22_BHC-Residential/21-2779-1 BobHopeCenter-Resi.rvt<br>2:35:09 PM   |            |
| todesk Docs://R22_BHC-Residential/21-2779-1 BobHopeCenter-Resi.rvt<br>22/2023 2:35:09 PM                            |            |
| E: Autodesk Docs://R22_BHC-Residential/21-2779-1 BobHopeCenter-Resi.rvt<br>_MP: 6/22/2023 2:35:09 PM                |            |
| FILE NAME: Autodesk Docs://R22_BHC-Residential/21-2779-1 BobHopeCenter-Resi.rvt<br>DATE STAMP: 6/22/2023 2:35:09 PM |            |

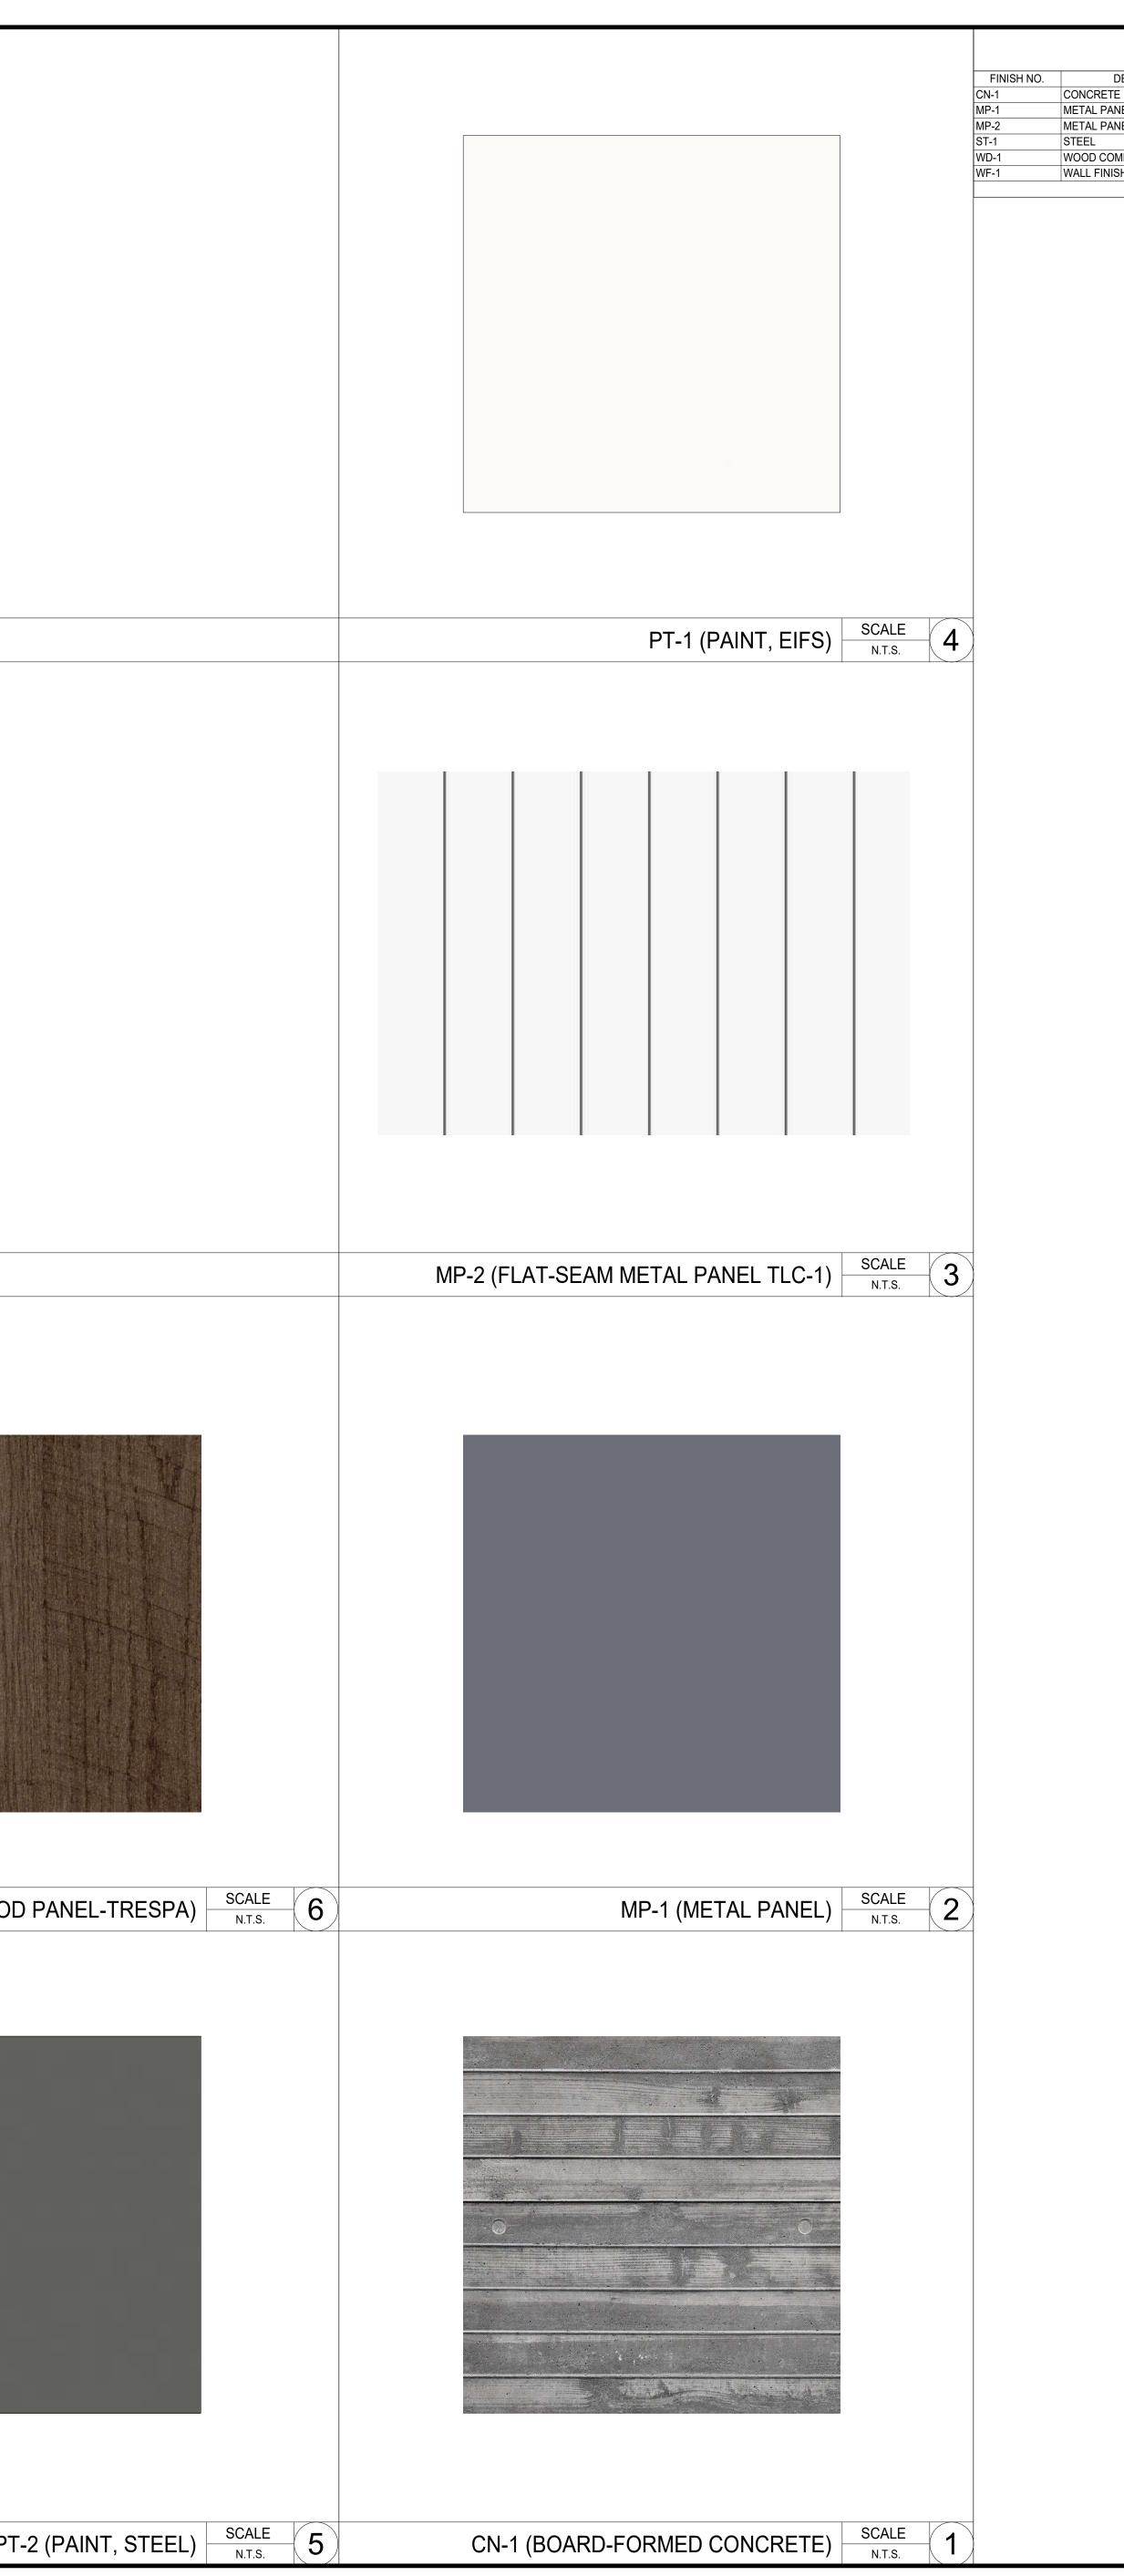


| FINISH SCHEDULE |              |                                     |                      |                                       |
|-----------------|--------------|-------------------------------------|----------------------|---------------------------------------|
| DESCRIPTION     | MANUFACTURER | SPECIFICATION                       | LOCATION             | NOTES                                 |
| TE              | -            | BOARD-FORMED CONCRETE               | SEE FINISH ELEVATION | DAVIS COLORS, DARK GREY (CARBON) 8084 |
| PANEL           | ALUMABOARD   | ALUMABOARD FW-10: CHARCOAL          | SEE FINISH ELEVATION | -                                     |
| ANEL            | METAL SALES  | TLC-1, 22 GA. FLAT SEAM METAL PANEL | SEE FINISH ELEVATION | COLOR TO MATCH PT-1                   |
|                 | -            | STEEL BARSTOCK HANDRAIL             | SEE FINISH ELEVATION | COLOR TO MATCH PT-2                   |
| OMPOSITE PANEL  | TRESPA       | METEON-LOFT BROWN                   | SEE FINISH ELEVATION | -                                     |
| NISH            | EIFS         | EIFS, PAINTED                       | SEE FINISH ELEVATION | PAINTED PT-1                          |
|                 |              | ·                                   |                      |                                       |

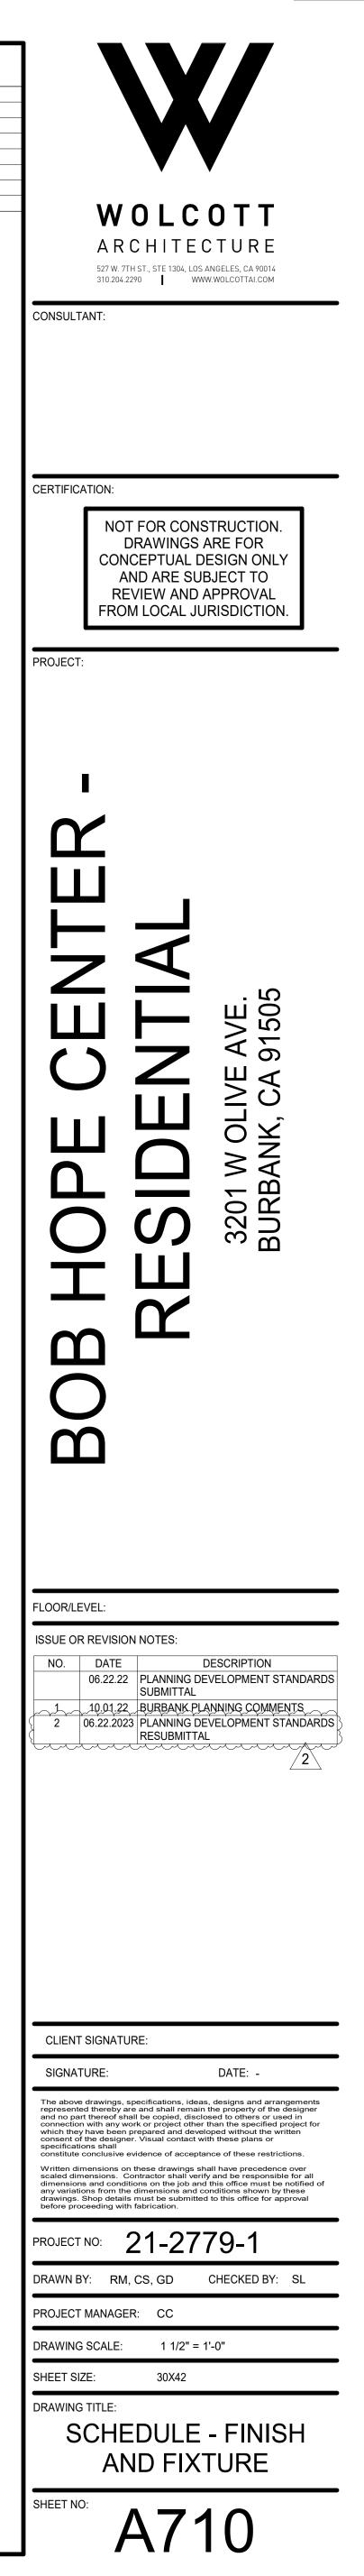

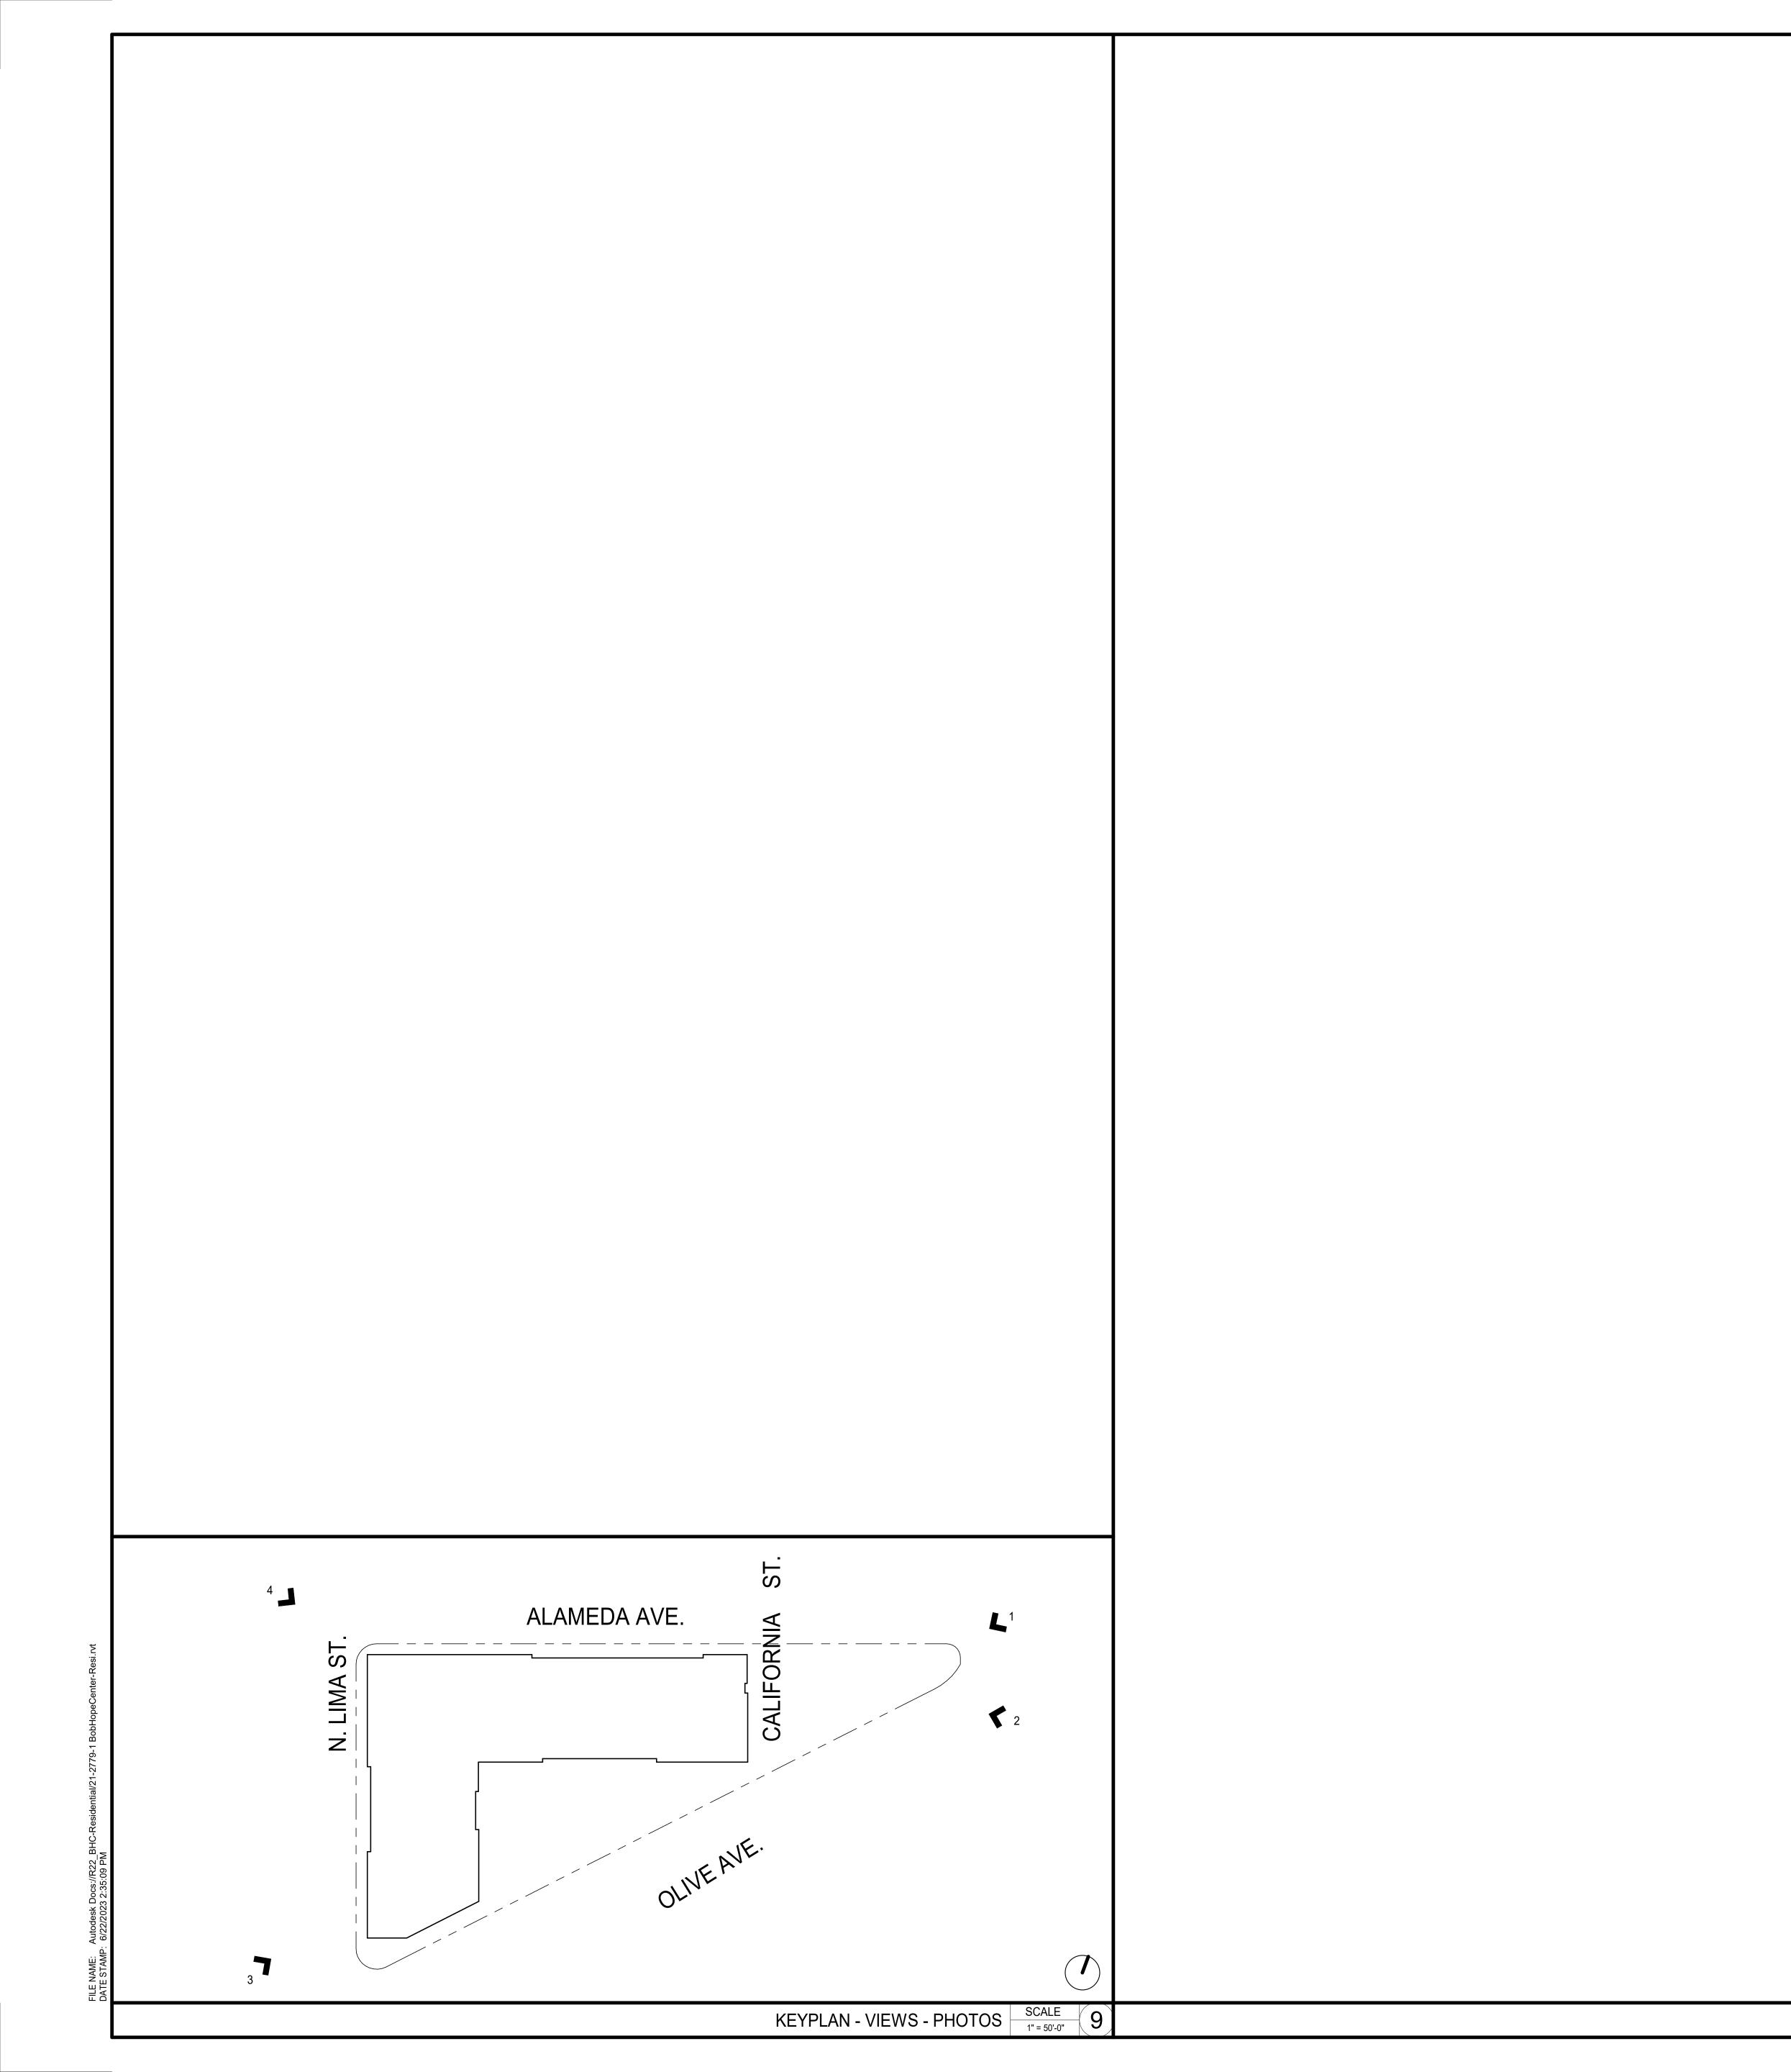




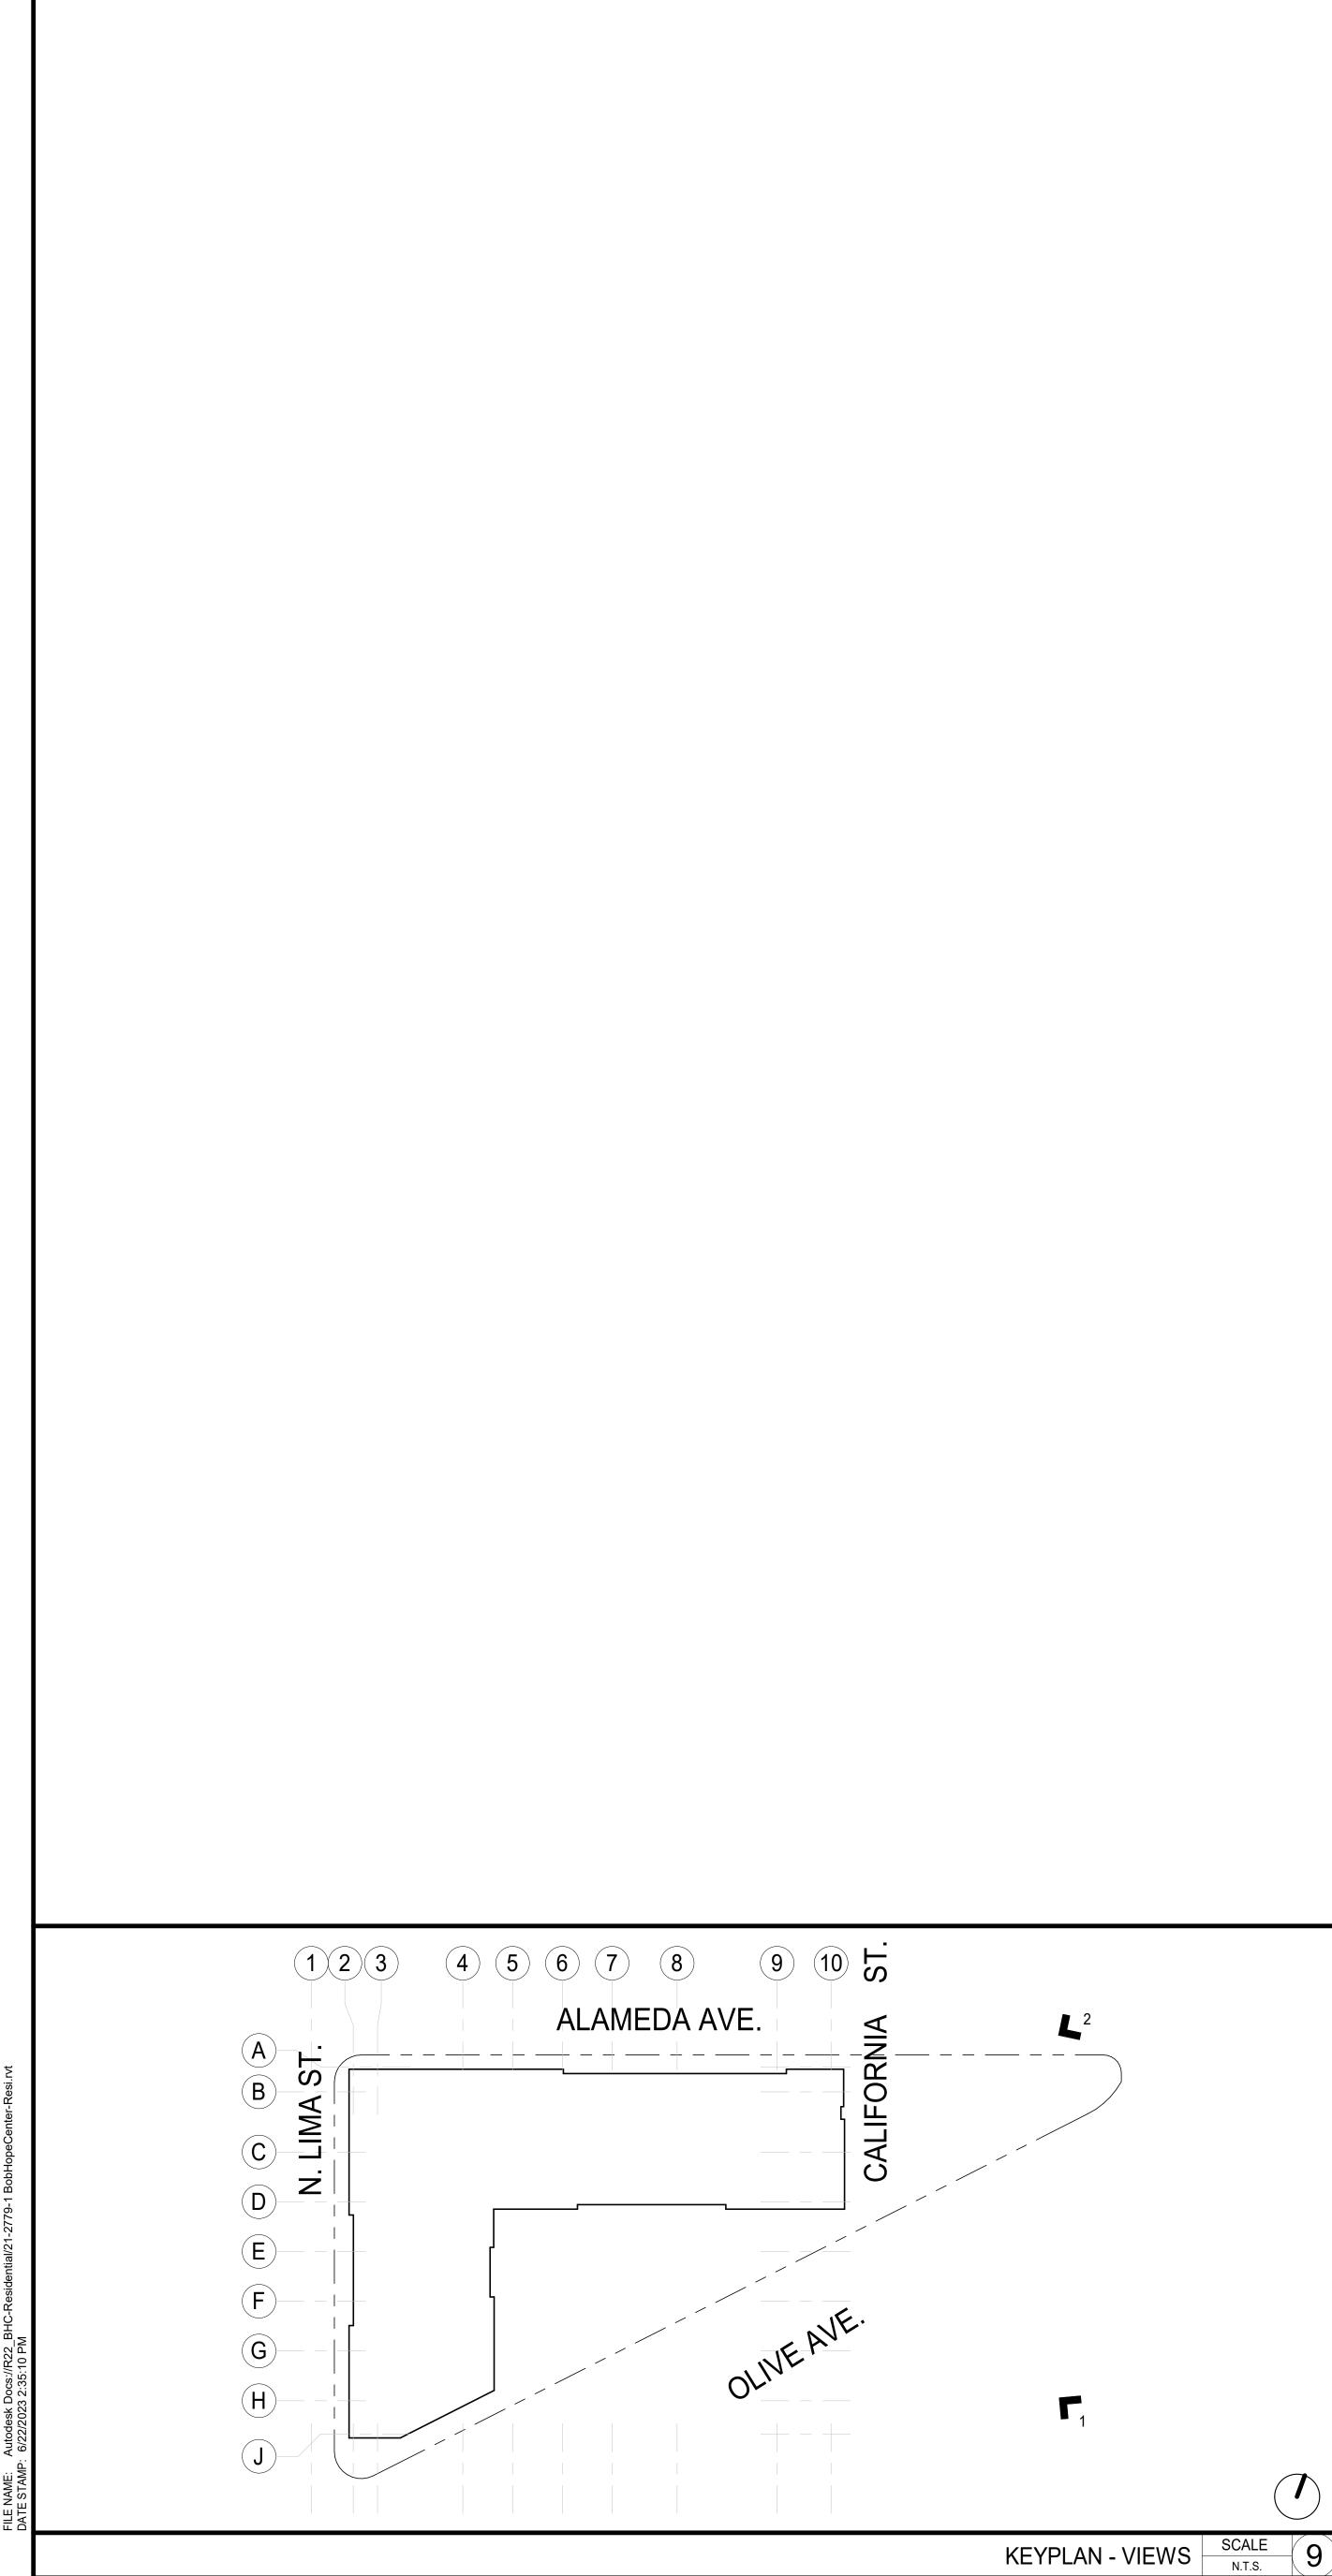





Original sheet size: 24"x36"

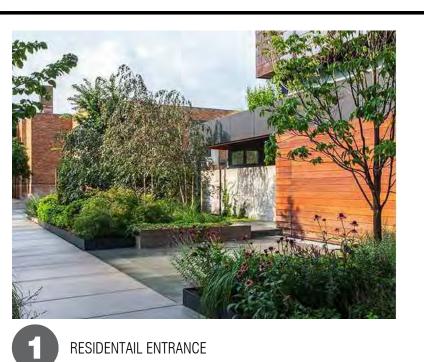




Los Angeles, California


Project Name:





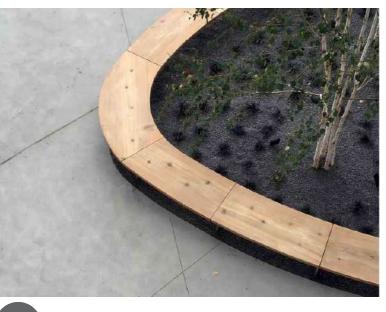


**3** BANQUETTE SEATING

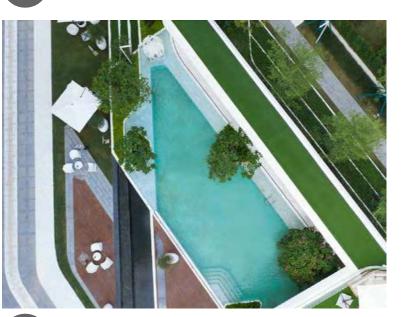



POOL



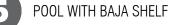



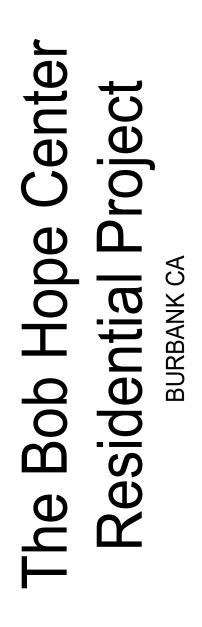

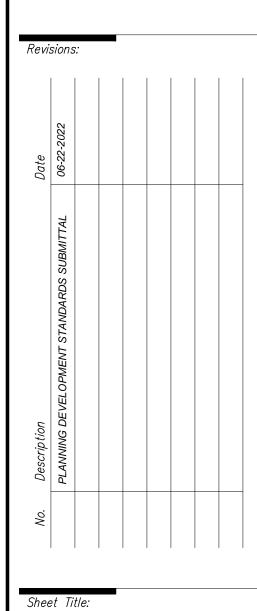




L1.0

Sheet Number:






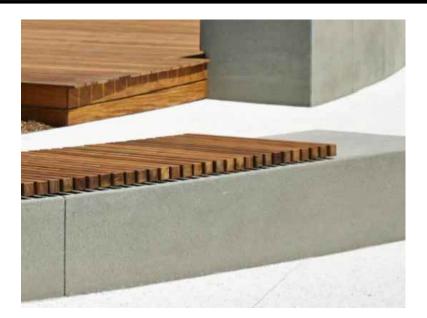



Los Angeles, California

Project Name:

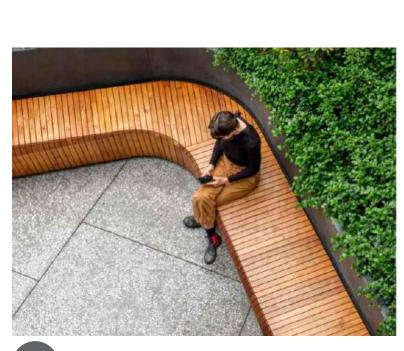












6 CAST-IN-PLACE CONCRETE SIDEWALK W/ TOPCAST FINISH



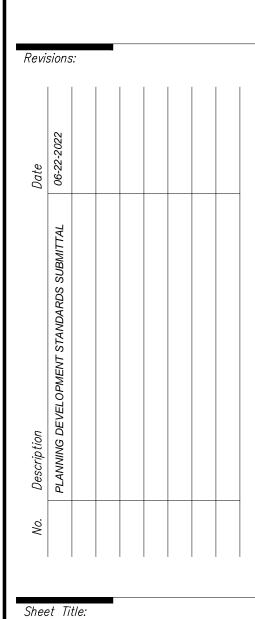


HARDSCAPE CONCEPT PLAN

Date: 06-22-2022 Scale: AS NOTED Sheet Number: L1.1



Original sheet size: 24"x36"

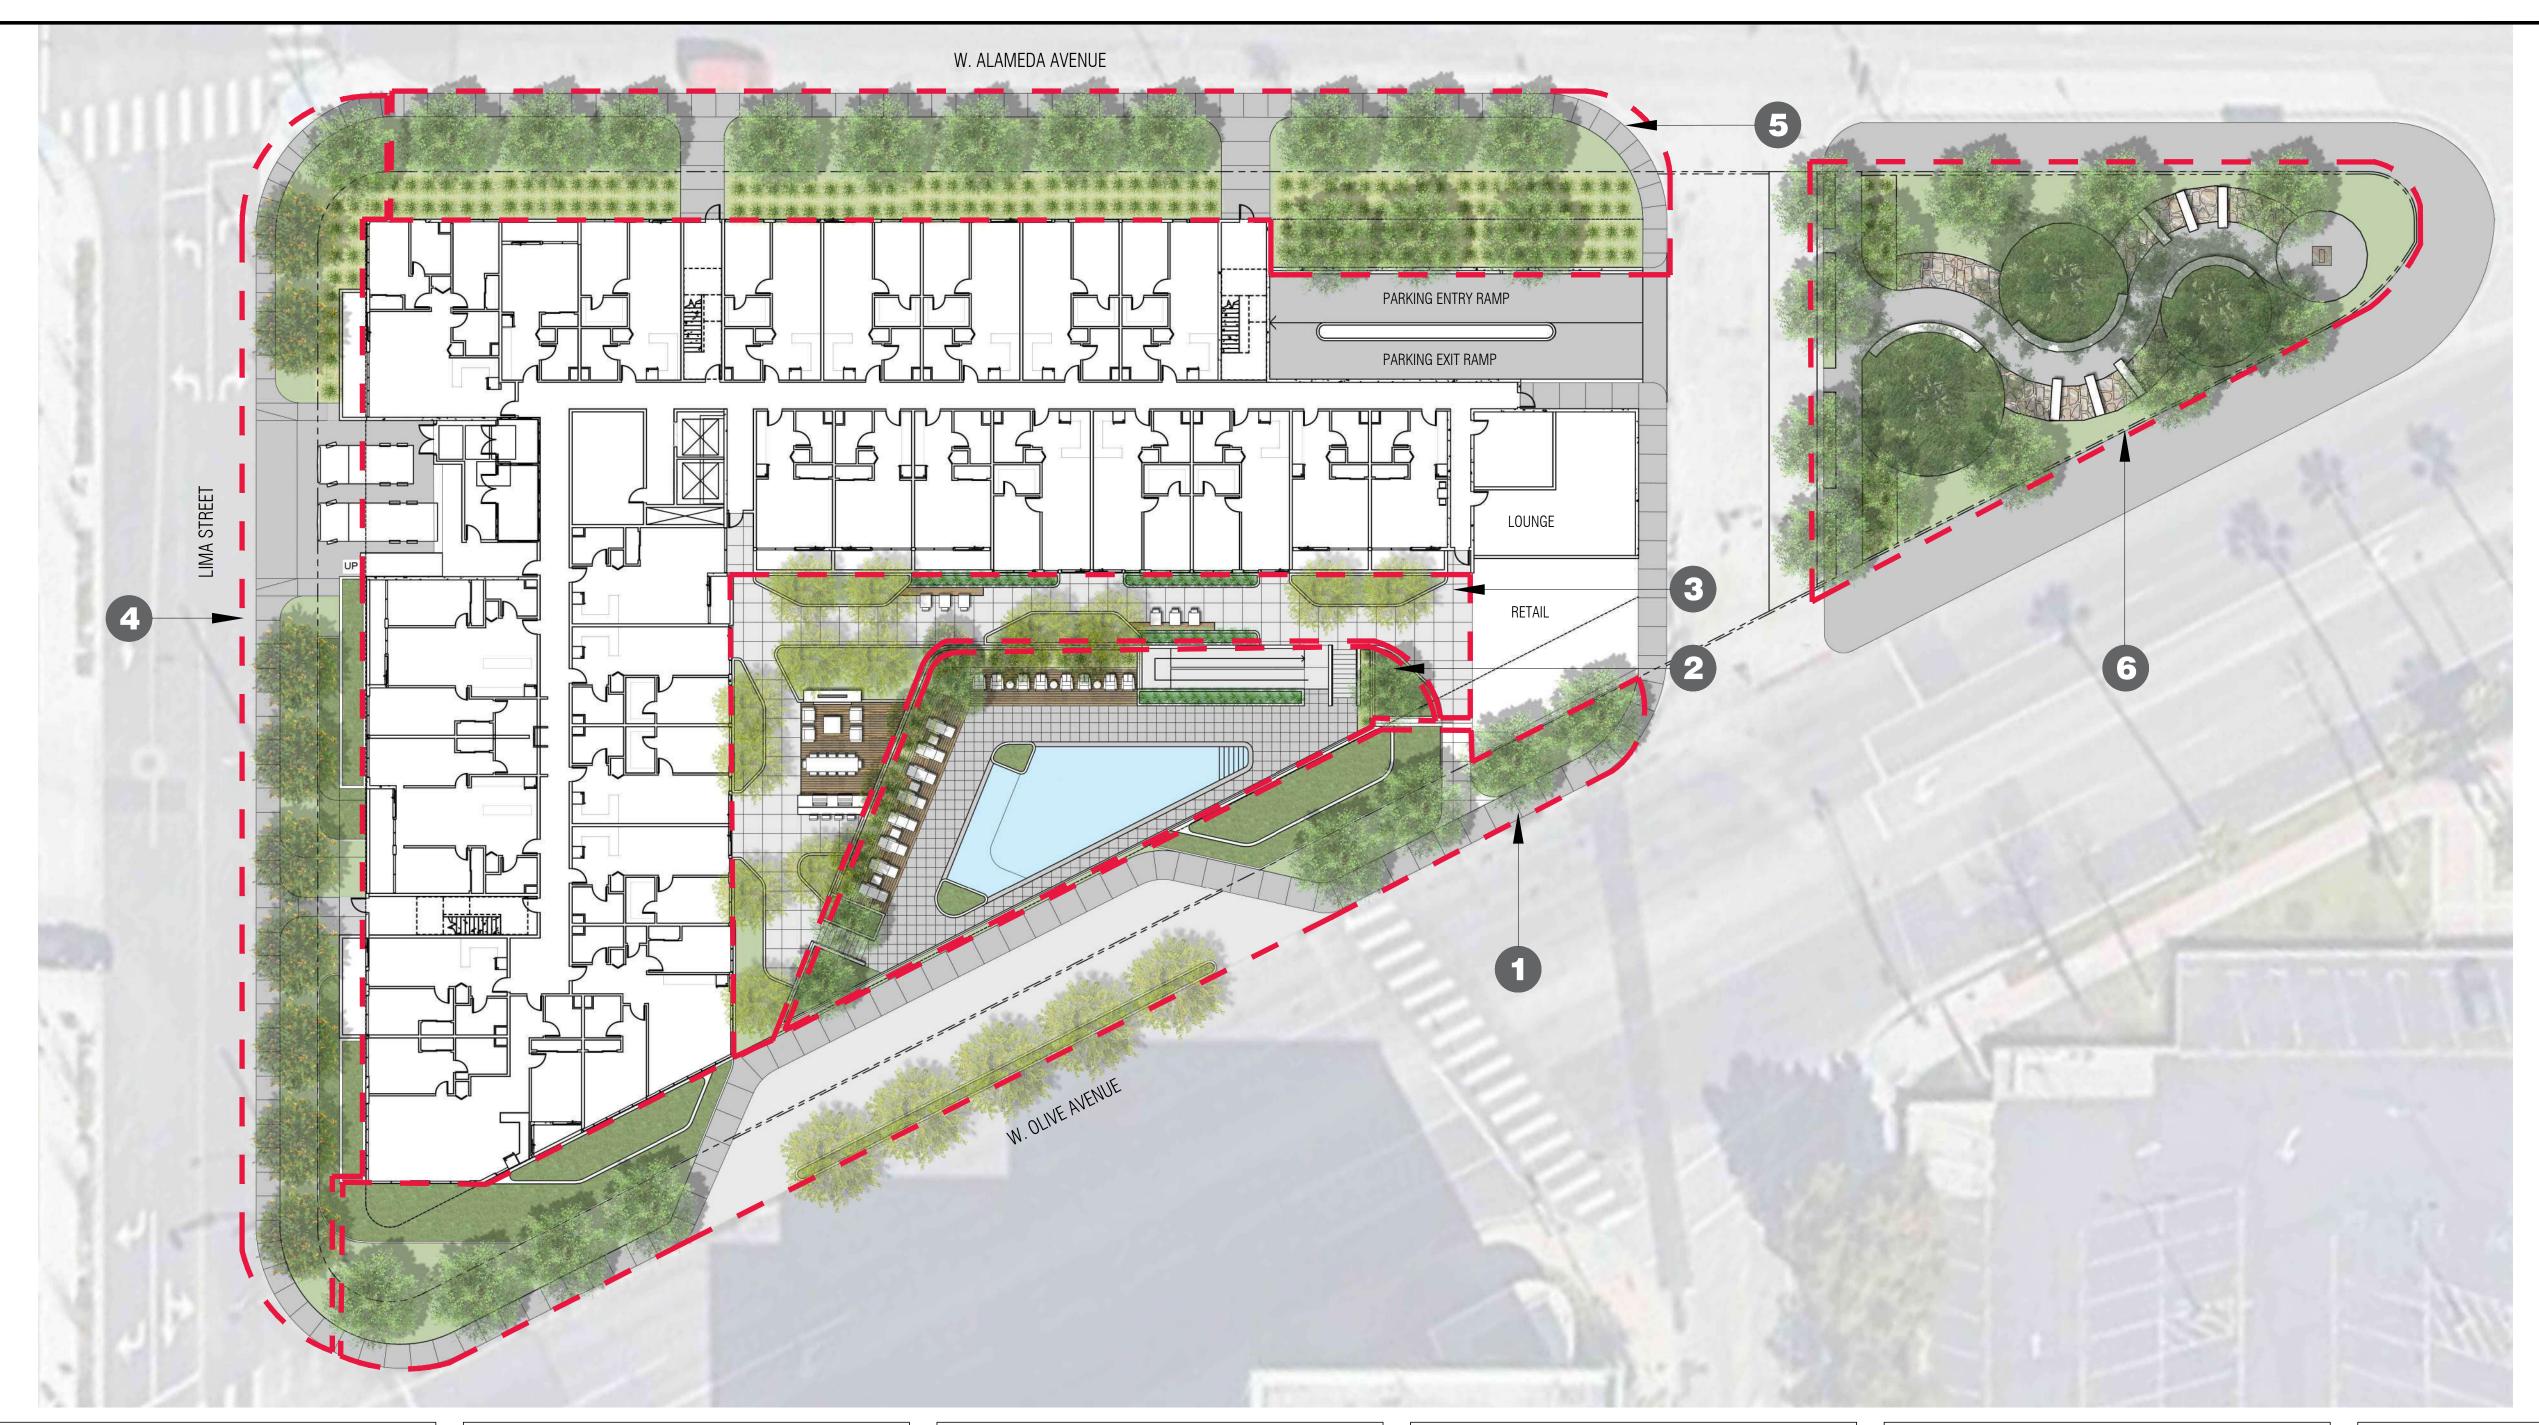

### OLIVE AVENUE FRONTAGE

| TREE S                                 | CHEDULE                      |      |
|--|------------------------------|------|
| DESCRIPTION/BOTANICAL NAME             | COMMON NAME                  | QTY  |
| OLEA EUROPAEA 'WILSONII'               | FRUITLESS EUROPEAN OLIVE     | 8    |
| CERCIDIUM 'DESERT MUSEUM'              | DESERT MUSEUM PALO VERDE     | - 5  |
| PROSOPIS CHILENSIS                     | CHILEAN MESQUITE             |      |
| SHRUB                                  | SCHEDULE                     |      |
| DESCRIPTION/BOTANICAL NAME             | COMMON NAME                  | QTY  |
| ACACIA COGNATA 'COUSIN ITT'            | COUSIN ITT ACACIA            | 47   |
| AEONIUM 'SUNBURST'                     | SUNBURST AOENIUM             | 96   |
| ANIGOZANTHOS 'HARMONY'                 | RED-YELLOW KANGAROO PAW      | 96   |
| BULBINE FRUTESCENS                     | STALKED BULBINE              | 63   |
| CALANDRINIA SPECTABILIS                | ROCK PURSLANE                | 246  |
| COPROSMA KIRKII                        | KIRK'S COPROSMA              | 37   |
| DIANELLA REVOLUTA 'LITTLE REV'         | LITTLE REV FLAX LILY         | 246  |
| FESTUCA GLAUCA 'ELIJAH BLUE'           | BLUE FESCUE GRASS            | 878  |
| FURCRAEA FEOTIDA 'MEDIOPICTA'          | NCN                          | 12   |
| HESPERALOE PARVIFLORA 'YELLOW'         | YELLOW YUCCA                 | 68   |
| OLEA EUROPAEA 'MONTRA'                 | LITTLE OLLIE                 | 60   |
| PORTULICARIA AFRA 'VARIEGATA'          | ELEPHANT BUSH                | - 24 |
| ROSMARINUS OFFICINIALIS 'PROSTRATATUS' | CREEPING ROSEMARY            | 24   |
| VERBENA LILACINA 'DE LA MINA'          | PURPLE CEDROS ISLAND VERBENA | 63   |

| 2 POOL DEC                      | K                       |     | 3 RESIDENTI.                            | AL DECK                  |            |
|---------------------------------|-------------------------|-----|---|--------------------------|------------|
| TREE S                          | CHEDULE                 |     | TREE S                                  | CHEDULE                  |            |
| DESCRIPTION/BOTANICAL NAME      | COMMON NAME             | QTY | DESCRIPTION/BOTANICAL NAME              | COMMON NAME              | <i>ατγ</i> |
| BAUHINIA X BLAKEANA             | HONG KONG ORCHID TREE   | 3   | KOELREUTERIA BIPINNATA                  | CHINESE FLAME TREE       | 14         |
| CASSIA LEPTOPHYLLA              | GOLD MEDALLION TREE     | 6   | SHRUB                                   | SCHEDULE                 |            |
| SHRUB                           | SCHEDULE                |     | DESCRIPTION/BOTANICAL NAME              | COMMON NAME              | QTY        |
| DESCRIPTION/BOTANICAL NAME      | COMMON NAME             | QTY | ABELIA GRANDIFLORA 'RADIANCE'           | RADIANCE ABELIA          | 86         |
| ALOE 'HERCULES'                 | HERCULES ALOE           | 2   | BOUGAINVILLEA 'LA JOLLA'                | NCN                      | 21         |
| ALPINIA ZERUMBET 'VARIEGATA'    | VARIEGATED SHELL GINGER | 22  | LANTANA CAMARA 'SPREADING SUNSET'       | SPREADING SUNSET LANTANA |            |
| ASPARAGUS DENSIFLORUS 'MYERSII' | FOXTAIL FERN            | 14  | LOTUS BERTHELOTI                        | PARROT'S BEAK            | 85         |
| LOMANDRA CONFERTIFOLIA 'SHORTY' | DWARF MAT RUSH          | 136 | NANDINA DOMESTICA 'LEMON LIME'          | HEAVENLY BAMBOO          | 53         |
| LOTUS BERTHELOTII               | PARROT'S BEAK           | 18  | PITTOSPORUM CRASSIFOLIUM 'NANA'         | DWARF KARO               | 70         |
| TRADESCANTIA SPATHACEA          | MOSES IN THE CRADLE     | 37  | POLYGALA FRUTICOSA 'PETITE BUTTERFLIES' | SWEET PEA SHRUB          | 36         |
| ZAMIA FURFURACEA                | SAGO CYCAS              | 92  |   |                          |            |

#### 3 RESIDENTIAL DECK

| <b>4</b> LIMA STRE<br>AND LID F    | EET FRONTAGE<br>PLANTER |     |
|------------------------------------|-------------------------|-----|
| TREE S                             | CHEDULE                 |     |
| DESCRIPTION/BOTANICAL NAME         | COMMON NAME             | QTY |
| MAYTENUS BOARIA                    | MAYTEN TREE             | 9   |
| PYRUS CALLERYANA 'BRADFORD'        | BRADFORD PEAR           | 9   |
| SHRUB                              | SCHEDULE                |     |
| DESCRIPTION/BOTANICAL NAME         | COMMON NAME             | QTY |
| ACHILLEA 'MOON SHINE'              | YARROW                  | 181 |
| ALOGYNE HUEGLII                    | BLUE HIBISCUS           | 12  |
| BACCHARIS PILULARIS 'PIGEON POINT' | DWARF COYOTE BRUSH      | 18  |
| CHONDROPETALUM TECTORUM            | SMALL CAPE RUSH         | 45  |
| LEYMUS CONDENSATUS 'CANYON PRINCE' | CANYON PRINCE WILD RYE  | 45  |
| LOMANDRA HYSTRIX 'TROPIC BELLE'    | TROPIC BELLE MAT RUSH   | 79  |
| ZEPHRANTHUS CANDIDA                | RAIN LILY               | 181 |

| <b>5</b> ALAMEDA<br>NORTH SI         | AVENUE<br>DE PLANTING     |      |
|--------------------------------------|---------------------------|------|
| TREE S                               | SCHEDULE                  |      |
| DESCRIPTION/BOTANICAL NAME           | COMMON NAME               | QTY  |
| ARBUTUS 'MARINA'                     | STRAWBERRY TREE           | 6    |
| RHUS LANCEA                          | AFRICAN SUMAC             | 11   |
| SHRUB                                | SCHEDULE                  |      |
| DESCRIPTION/BOTANICAL NAME           | COMMON NAME               | QTY  |
| CAREX DIVULSA                        | EUROPEAN GREY SEDGE       | 1,23 |
| CARISSA MACROCARPA 'GREEN CARPET'    | NATAL PLUM                | 75   |
| DIETES VEGETA 'VARIEGATA'            | VARIEGATED FORTNIGHT LILY | 310  |
| MUHLENBERGIA LINDHEIMERI             | LINDHEIMER'S MUHLY        | 128  |
| PENNISETUM SPATHIOLATUM              | SLENDER VELDT GRASS       | 1,23 |
| WESTRINGIA FRUTICOSA 'MORNING LIGHT' | COAST ROSEMARY            | 128  |

| Oft. | 10ft.   | 20ft. |
|------|---------|-------|
| GRA  | PHIC SC | ALE   |

|               |     |      | COMMON N |
|---------------|-----|------|----------|
| TREE SCHEDULE |     |      |          |
| 6             | BOB | HOPE | PARK     |
|               |     |      |          |


| DESCRIPTION/BOTANICAL NAME           | COMMON NAME                     | QTY                 |  |  |
|--------------------------------------|---------------------------------|---------------------|--|--|
| CINNAMOMUM CAMPHORA                  | CAMPHOR TREE                    |                     |  |  |
| TIPUANA TIPU                         | TIPU TREE                       | 2                   |  |  |
| SPATHODEA CAMPANULATA                | AFRICAN TULIP TREE              | 6                   |  |  |
| SHRUB SCHEDULE                       |                                 |                     |  |  |
| DESCRIPTION/BOTANICAL NAME           | COMMON NAME                     | QTY                 |  |  |
| COREOPSIS LANCEOLATA 'EARLY SUNRISE' | DOUBLE FLOWERED YELLOW TICKSEED | 180                 |  |  |
| DIETES BICOLOR                       | FORTNIGHT LILY                  | 72                  |  |  |
| LOMANDRA 'PLATINUM BEAUTY'           | PLATINUM BEAUTY MAT RUSH        | 72                  |  |  |
| HEBE 'GIBBY'                         | GIBBY HEBE                      | 45                  |  |  |
| OLEA EUROPAEA 'MONTRA'               | LITTLE OLLIE                    |                     |  |  |
| FESTUCA RUBRA 'MOLATE'               | CREEPING RED FESCUE GRASS       | 1,816 S.F.<br>FLATS |  |  |



Los Angeles, California

Project Name:

## Center Project Hope BURBANK CA Residential The Bob

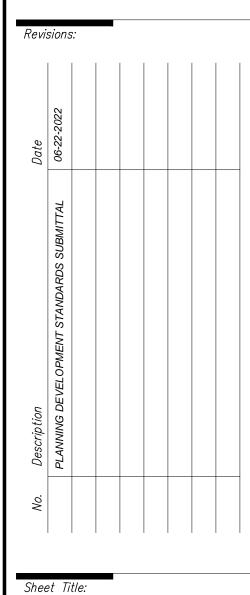

CONCEPTUAL PLANTING PLAN


#### Date: 06-22-2022

Scale: AS NOTED

Sheet Number:

L1.3

### OLIVE AVENUE FRONTAGE

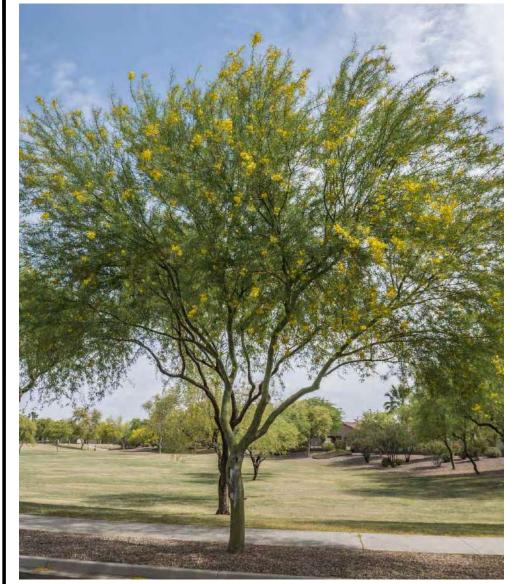

CERCIDIUM 'DESERT MUSEUM' DESERT MUSEUM PALO VERDE



OLEA EUROPAEA 'WILSONII' FRUITLESS EUROPEAN OLIVE

#### ① OLIVE AVE CONTINUED



FURCRAEA FOETIDA 'MEDIOPICTA' NCN



HESPERALOE PARVIFLORA 'YELLOW' YELLOW YUCCA





PORTULICARIA AFRA 'VARIEGATA' ELEPHANT BUSH



ROSMARINUS OFFICINALIS 'PROSTRATUS' CREEPING ROSEMARY



VERBENA LILACINA 'DE LA MINA' PURPLE CEDROS ISLAND VERBENA





BAUHINIA X BLAKEANA HONG KONG ORCHID TREE

### **3** RESIDENTIAL DECK



KOELREUTERIA BIPINNATA CHINESE FLAME TREE





ABELIA GRANDIFLORA 'RADIANCE' RADIANCE ABELIA



NANDINA DOMESTICA 'LEMON LIME' HEAVENLY BAMBOO



BOUGAINVILLEA 'LA JOLLA' NCN



PITTOSPORUM CRASSIFOLIUM 'NANA' DWARF KARO





ACACIA COGNATA 'COUSIN ITT' COUSIN ITT ACACIA



CALANDRINIA SPECTABILIS ROCK PURSLANE



AEONIUM 'SUNBURST' SUNBURST AOENIUM



COPROSMA KIRKII KIRK'S COPROSMA

### 2 POOL DECK



CASSIA LEPTOPHYLLA GOLD MEDALLION TREE



ALOE 'HERCULES' HERCULES ALOE




ALPINIA ZERUMBET 'VARIEGATA' VARIEGATED SHELL GINGER



LOTUS BERTHELOTII PARROT'S BEAK



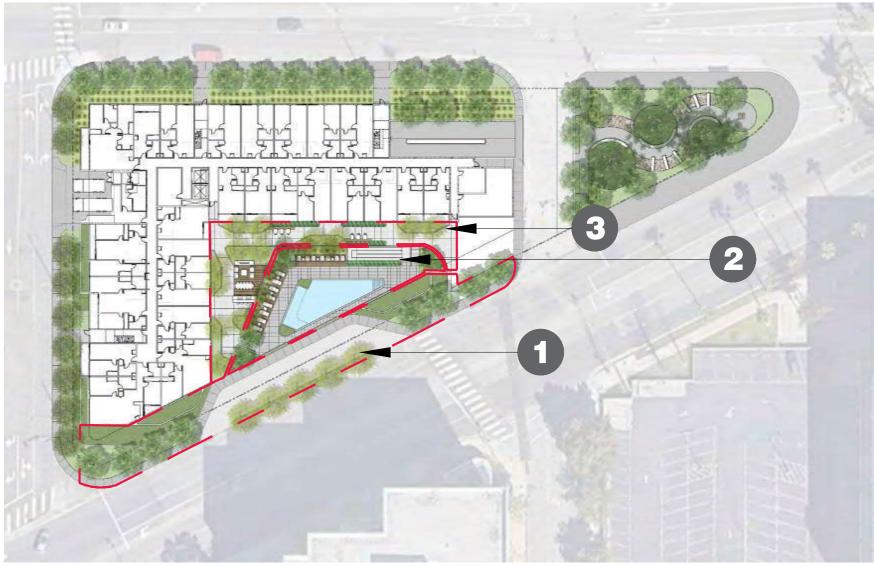



LANTANA CAMARA 'SPREADING SUNSET SPREADING SUNSET LANTANA



POLYGALA FRUTICOSA 'PETITE BUTTERFLIES' SWEET PEA SHRUB



LOTUS BERTHELOTII PARROT'S BEAK



RHAPHIOLEPIS UMBELLATA 'MINOR' DWARF YEDDO HAWTHORN



ANIGOZANTHOS 'HARMONY' RED-YELLOW KANGAROO PAW



DIANELLA REVOLUTA 'LITTLE REV' LITTLE REV FLAX LILY



BULBINE FRUTESCENS STALKED BULBINE



FESTUCA GLAUCA 'ELIJAH BLUE' BLUE FESCUE GRASS





ASPARAGUS DENSIFLORUS 'MYERSII' FOXTAIL FERN



LOMANDRA CONFERTIFOLIA 'SHORTY' DWARF MAT RUSH



TRADESCANTIA SPATHACEA MOSES IN THE CRADLE



ZAMIA FURFURACEA SAGO CYCAS



Los Angeles, California


Project Name:



Revisions:

| Sheet | Title: |
|-------|--------|
|       |        |

PLANT IMAGES

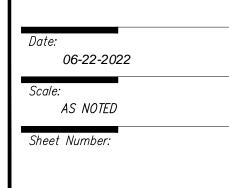

L1.4

### LIMA STREET FRONTAGE AND LID PLANTERS



PYRUS CALLERYANA 'BRADFORD' BRADFORD PEAR



ACHILLEA 'MOON SHINE' YARROW



CHONDROPETALUM TECTORUM SMALL CAPE RUSH

MAYTENUS BOARIA MAYTEN TREE

### SALAMEDA AVENUE CONTINUED



CAREX DIVULSA EUROPEAN GREY SEDGE



CARISSA MACROCARPA 'GREEN CARPET' NATAL PLUM



DIETES VEGETA 'VARIEGATA' VARIEGATED FORTNIGHT LILY





PENNISETUM SPATHIOLATUM SLENDER VELDT GRASS



WESTRINGIA FRUTICOSA 'MORNING LIGHT' COAST ROSEMARY



### 6 BOB HOPE PARK, CONTINUED



COREOPSIS LANCEOLATA 'EARLY SUNRISE' DOUBLE FLOWERED YELLOW TICKSEED



HEBE 'GIBBY' GIBBY HEBE PLANT IMAGES



OLEA EUROPAEA 'MONTRA' LITTLE OLLIE

DIETES BICOLOR FORTNIGHT LILY



FESTUCA RUBRA 'MOLATE' CREEPING RED FESCUE GRASS



LOMANDRA 'PLATINUM BEAUTY' PLATINUM BEAUTY MAT RUSH

ALOGYNE HUEGLII BLUE HIBISCUS



BACCHARIS PILULARIS 'PIGEON POINT' DWARF COYOTE BRUSH



ZEPHRANTHUS CANDIDA RAIN LILY




ARBUTUS 'MARINA' STRAWBERRY TREE

LEYMUS CONDENSATUS 'CANYON PRINCE' CANYON PRINCE WILD RYE

### **BOB HOPE PARK**

LOMANDRA HYSTRIX 'TROPIC BELLE'

TOPIC BELLE MAT RUSH

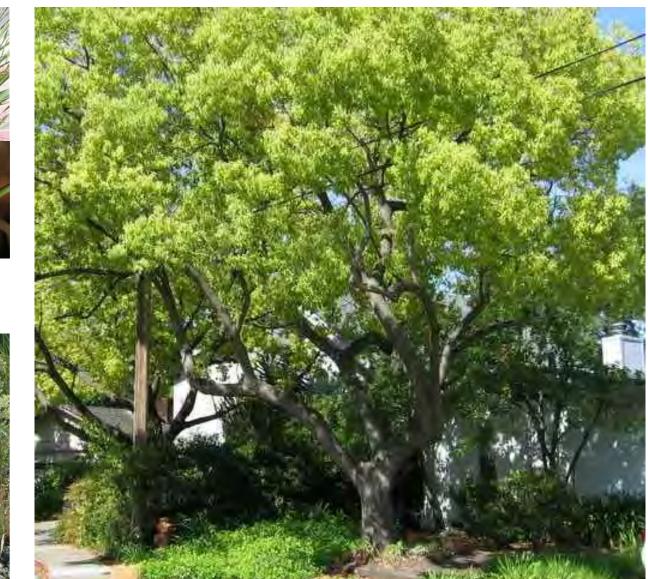


CINNAMOMUM CAMPHORA CAMPHOR TREE



SPATHODEA CAMPANULATA AFRICAN TULIP TREE

#### KEY MAP

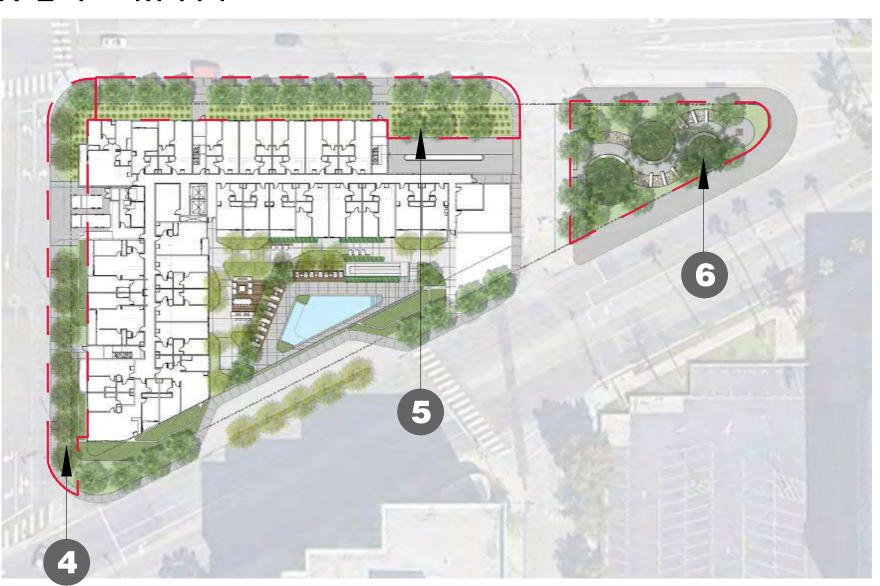

### SALAMEDA AVE NORTH SIDE

RHUS LANCEA AFRICAN SUMAC







TIPUANA TIPU TIPU TREE



Los Angeles, California

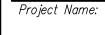

#### Center roject Φ $\bigcirc$ σ enti Bob sid Φ he Ľ

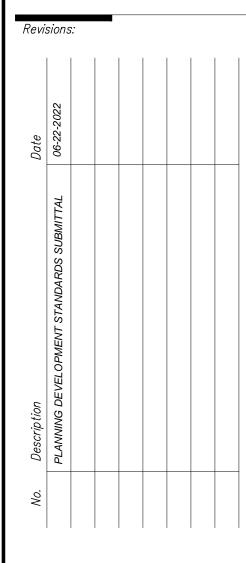

Sheet Title:

PLANT IMAGES

Date: 06-22-2022 Scale. AS NOTED Sheet Number: L1.5